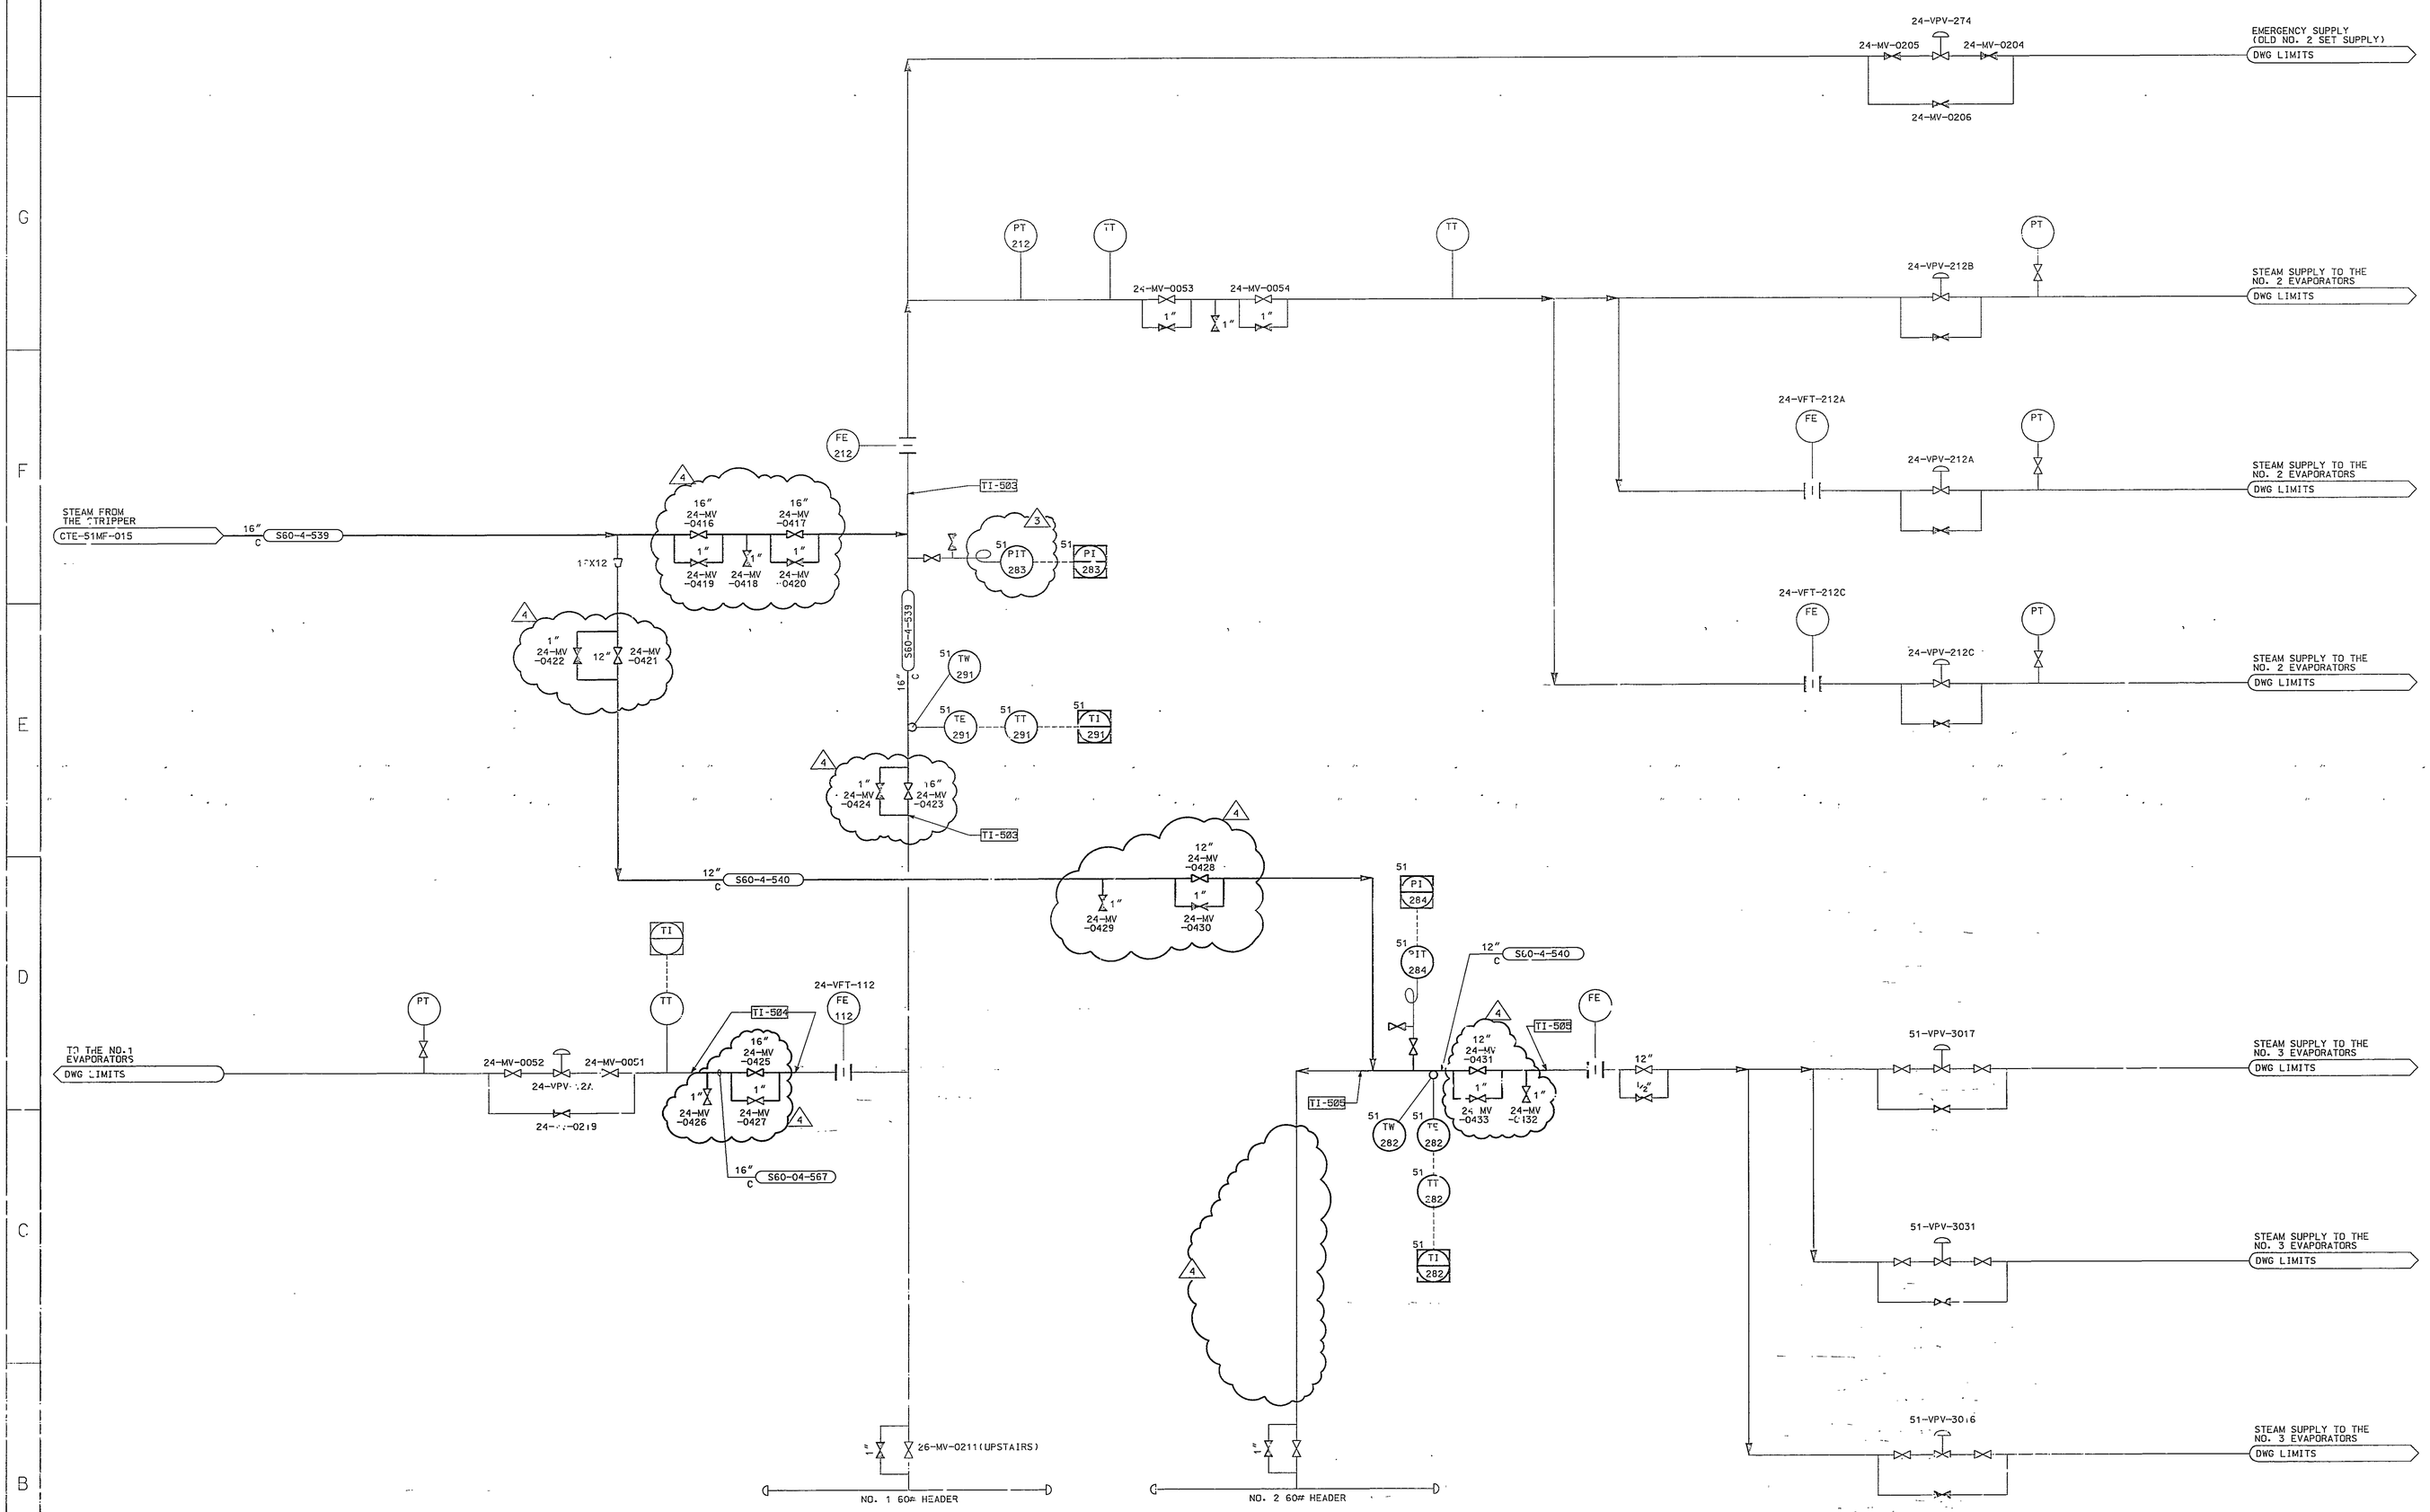

NOTES

1. A HAND SKETCH OF THIS DRAWING WAS PROVIDED BY BOWATER ON JULY 12, 2000.

REV. NO.	CODE	CIRCLES	DATE	REV. BY	DESCRIPTION	CHECKED BY	APPROVED	APPROVED
4	G	–	11 27 01	TTC	RELEASED FOR RECORD			
3	B	3	01 26 01	TGT	REMOVED TIE-IN 506 CHANGED INSTRUMENT TAG			
2	B	–	10 20 00	TGT	RELEASED FOR DESIGN WITH PIPING DWGS.			
1	B	12	09 18 00	TGT	ADDED LINE NUMBERS			
0	B	–	08 09 00	TGT	RELEASED FOR DESIGN	DLB	TGT	

NOTE: CIRCLE ALL REVISIONS. IDENTIFY WITH DIAMOND NUMBER AND ARROW. REGIVE ONLY CIRCLE AND ARROW BEFORE NEXT REVISION.

ISSUE CODE			
A PRELIMINARY	C MAT'L T.O.	F CONST'N	
B DESIGN	D MAT'L PURC.	G RECORD	
	E PIDS		

SEAL

SIGNATURE

DATE

BE&K ENGINEERING OF NORTH CAROLINA, INC.
800 PERIMETER PARK DRIVE, SUITE 100
MORRISVILLE, NORTH CAROLINA 27560

DR. E. HYSINGER	DATE 07/20/00
DSGN. T. TOMPKINS	FILE NUMBER
CK. D. BROWN	
DPE T. TOMPKINS	JOB NO. 99-2047
CadFile Name: **DGN**	

BOWATER
COATED PAPER & PULP DIV.
P.O. Box 7, Catawba, South Carolina 29704

DRAWING TITLE
CLUSTER RULE PROJECT
COND. STRIPPER SYS.
60 # STEAM SYSTEM
P&I DIAGRAM

BE&K DRAWING NUMBER
047-PO-006

CLIENT DRAWING NUMBER
CTE-51MF-017

RECORD DRAWING
BY _____ DATE _____