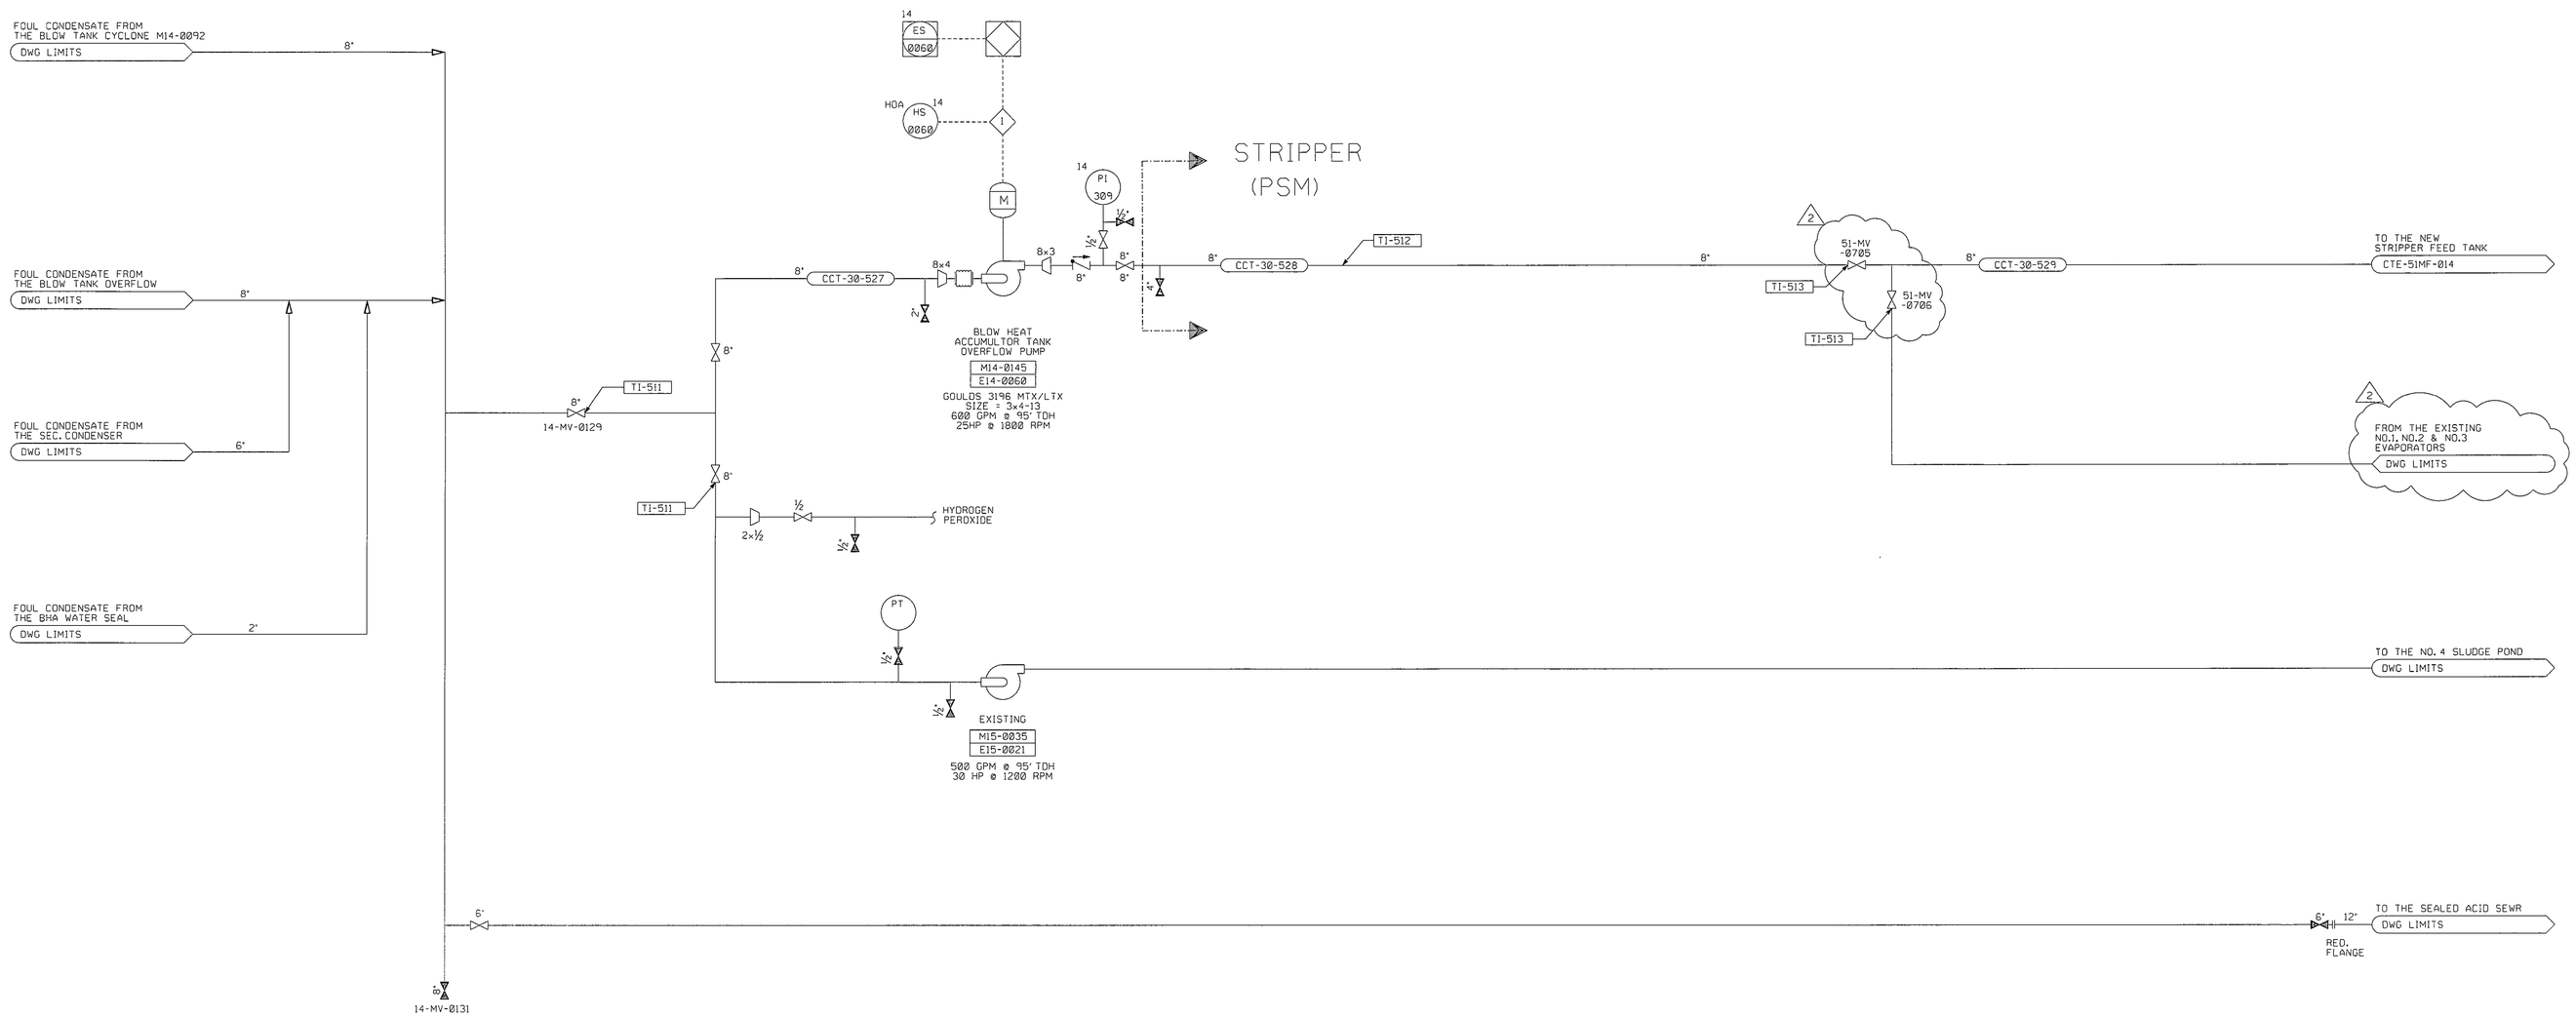

LEGEND

DENOTES (PSM) ---·---·---▶

RECORD DRAWING

BY _____ DATE _____

NOTES

REV. NO.	CODE / REV. BY	CIRCLES	DATE	DESCRIPTION	CHECKED BY	APPROVED	APPROVED
3	RRB		09 25 02	ADDED (PSM) PER GAH			
2	G - TTC		11 27 01	RELEASED FOR RECORD			
1	B 1 TGT		01 26 01	RELEASED FOR DESIGN			
Ø	B - TGT		10 20 00	RELEASED FOR DESIGN WITH THE PIPING DRAWINGS			
A	A - TGT		09 18 00	RELEASED FOR CLIENT APPROVAL			

NOTE: CIRCLE ALL REVISIONS. IDENTIFY WITH DIAMOND, NUMBER AND ARROW. REMOVE ONLY CIRCLE AND ARROW BEFORE NEXT REVISION.

ISSUE CODE					
A	PRELIMINARY	C	MAT'L T.O.	F	CONST'N
B	DESIGN	D	MAT'L PURC.	G	RECORD
		E	BIDS		

SEAL

SIGNATURE

DATE

BE&K ENGINEERING OF NORTH CAROLINA, INC.
2009 PERIMETER PARK DRIVE, SUITE 100
MORRISVILLE, NORTH CAROLINA 27560

DR. C. WARE	DATE 08/21/00
DSGN. T. TOMPKINS	FILE NUMBER
CK. D. BROWN	
DPE T. TOMPKINS	JOB NO. 99-2047
Cadfile Name: ••DGN••	

DR. BOWATER
COATED PAPER & PULP DIV.
P.O. Box 7, Catawba, South Carolina 29704

DRAWING TITLE
CLUSTER RULE PROJECT
COND. STRIPPER SYS.
BHA OVERFLOW
P & I DIAGRAM

BE&K DRAWING NUMBER
047-PØ-008

CLIENT DRAWING NUMBER
CTE-51MF-019

••SYTIME••