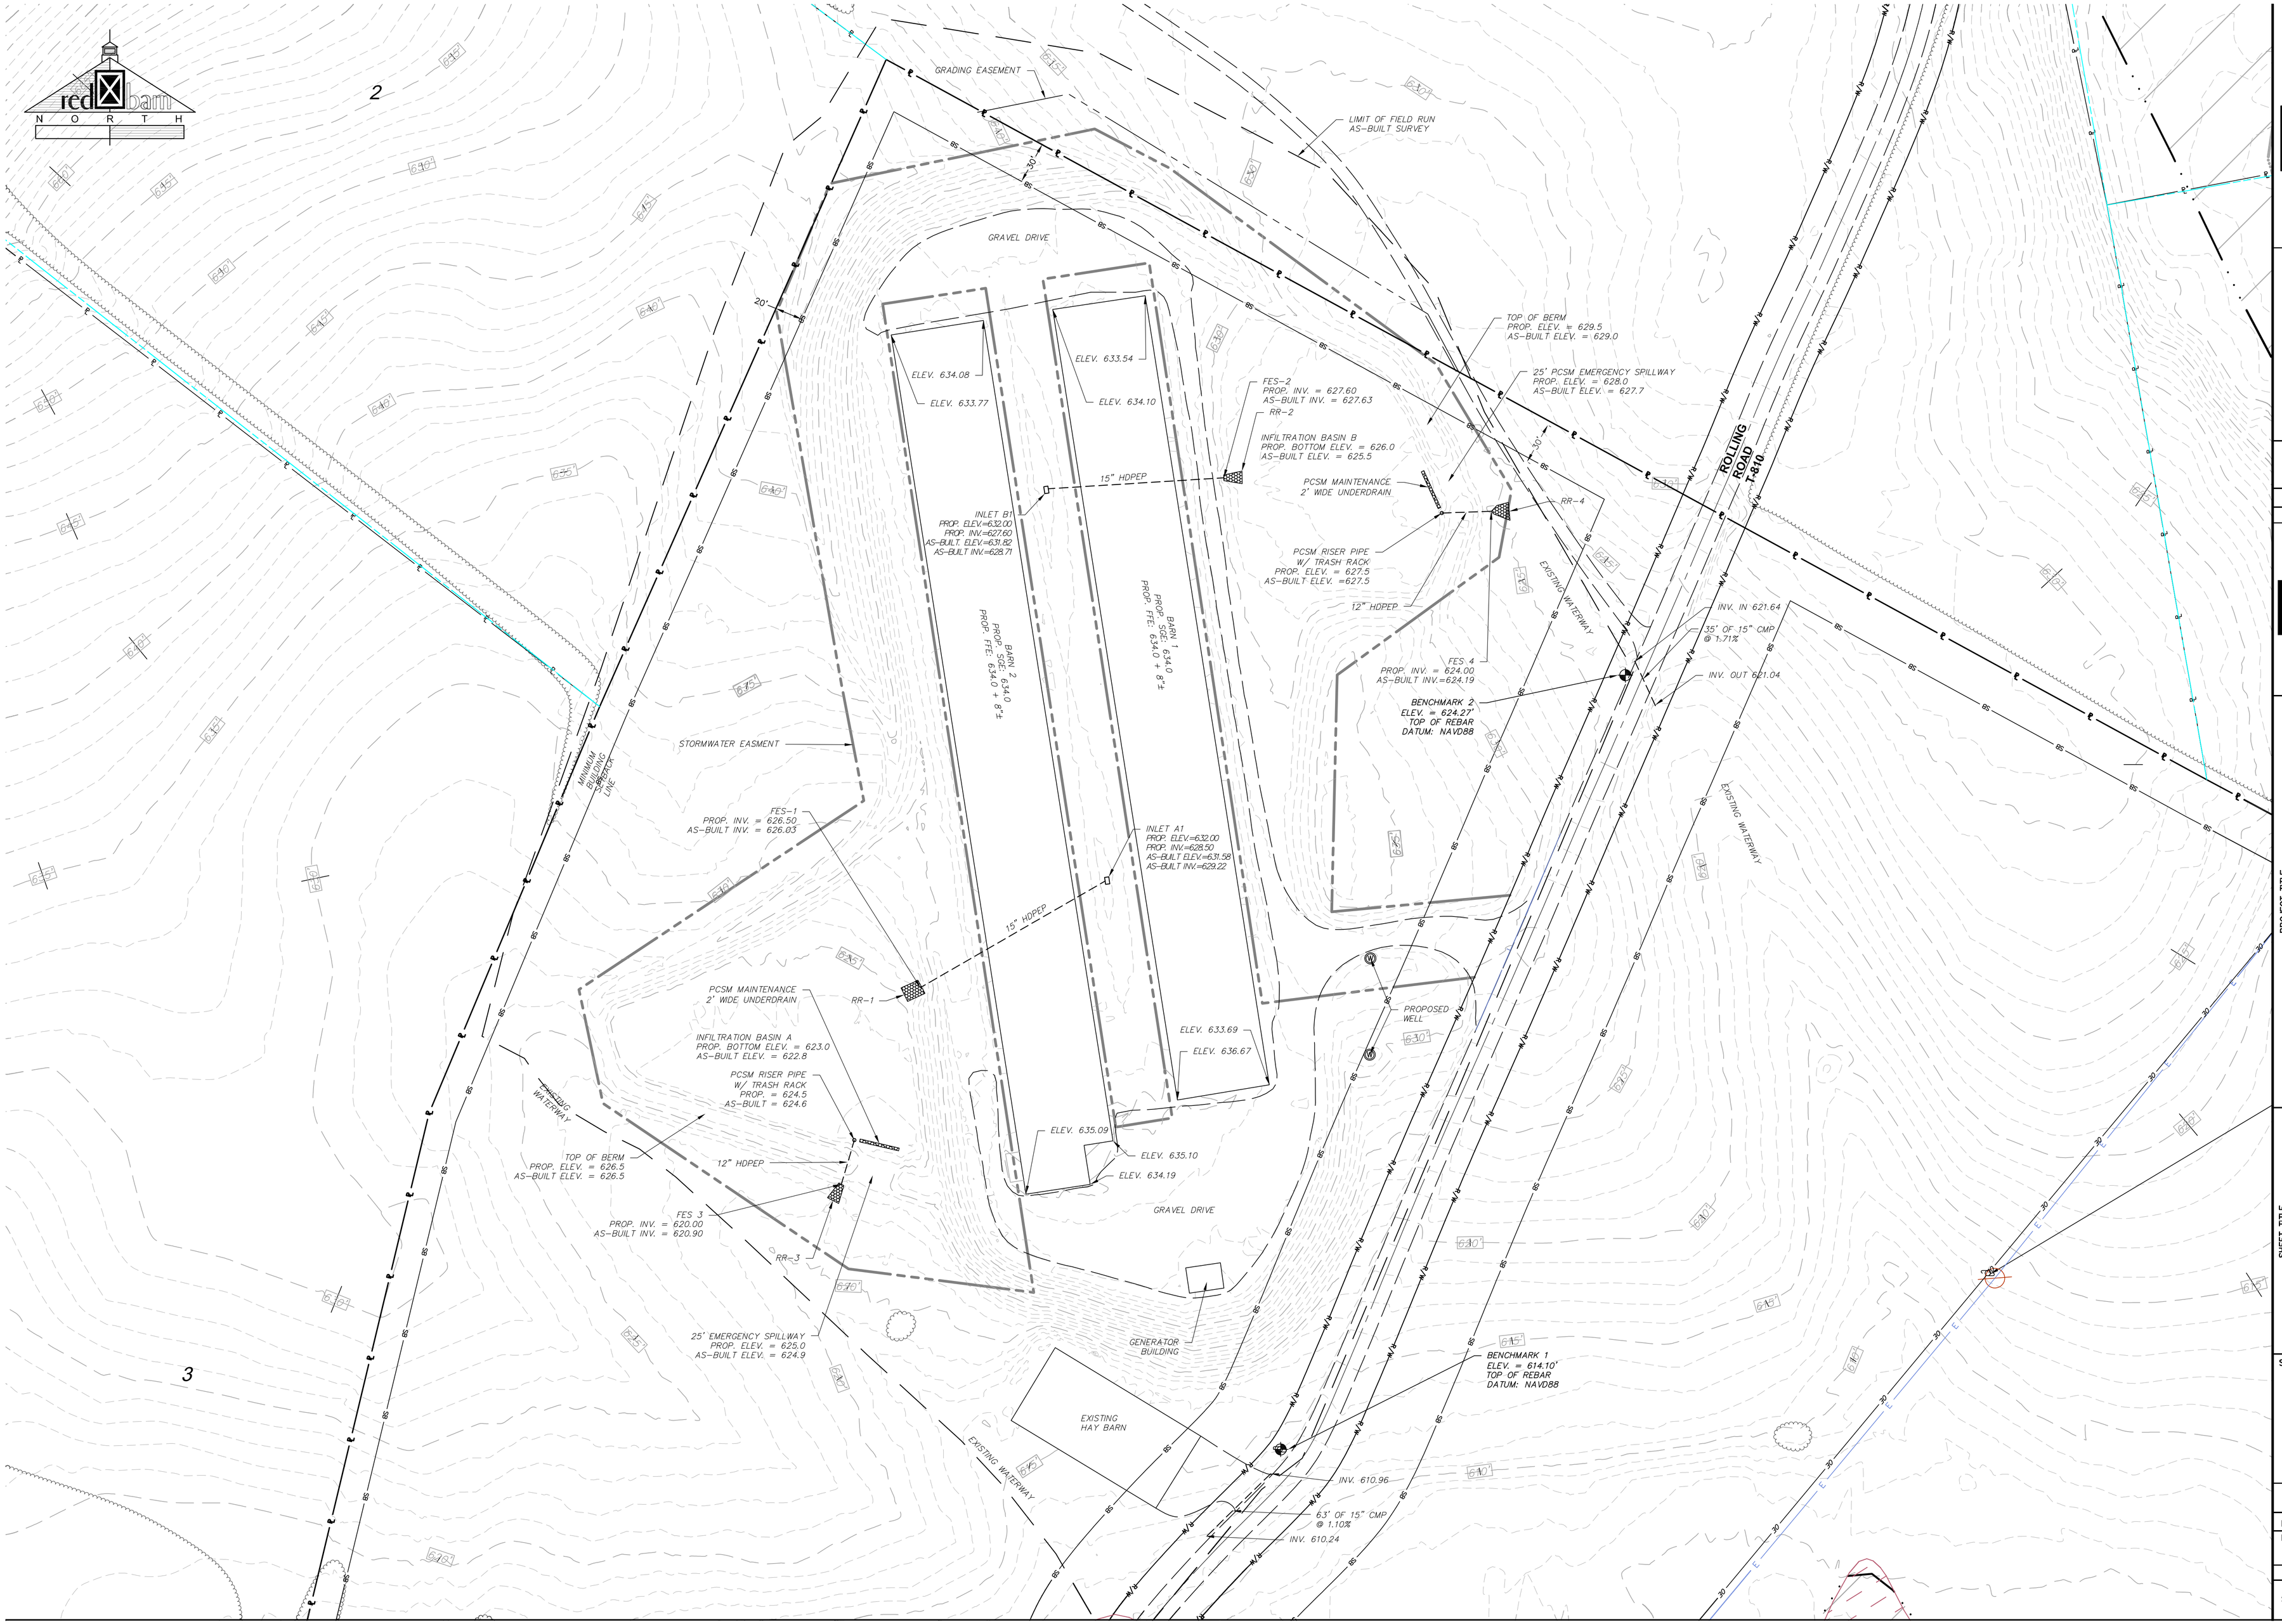

red barn
1383 Arcadia Road, Suite 001
Lancaster, PA 17601
Phone: (717) 393-2176
Fax: (888) 850-0015
www.redbarnag.com

NO	BY	DATE	REVISION

PROJECT TITLE

FINAL LAND DEVELOPMENT PLAN FOR WEAVER POULTRY OPERATION

HUNTINGTON TOWNSHIP, ADAMS COUNTY, PENNSYLVANIA

SHEET TITLE

AS-BUILT GRADING PLAN

0' 50' 100' 150'
SCALE: 1" = 50'

SEAL

DRAWN BY:	CHECKED BY:
BJN	

DATE: 10-17-2013

PROJECT NO.:

SHEET NO.: 601