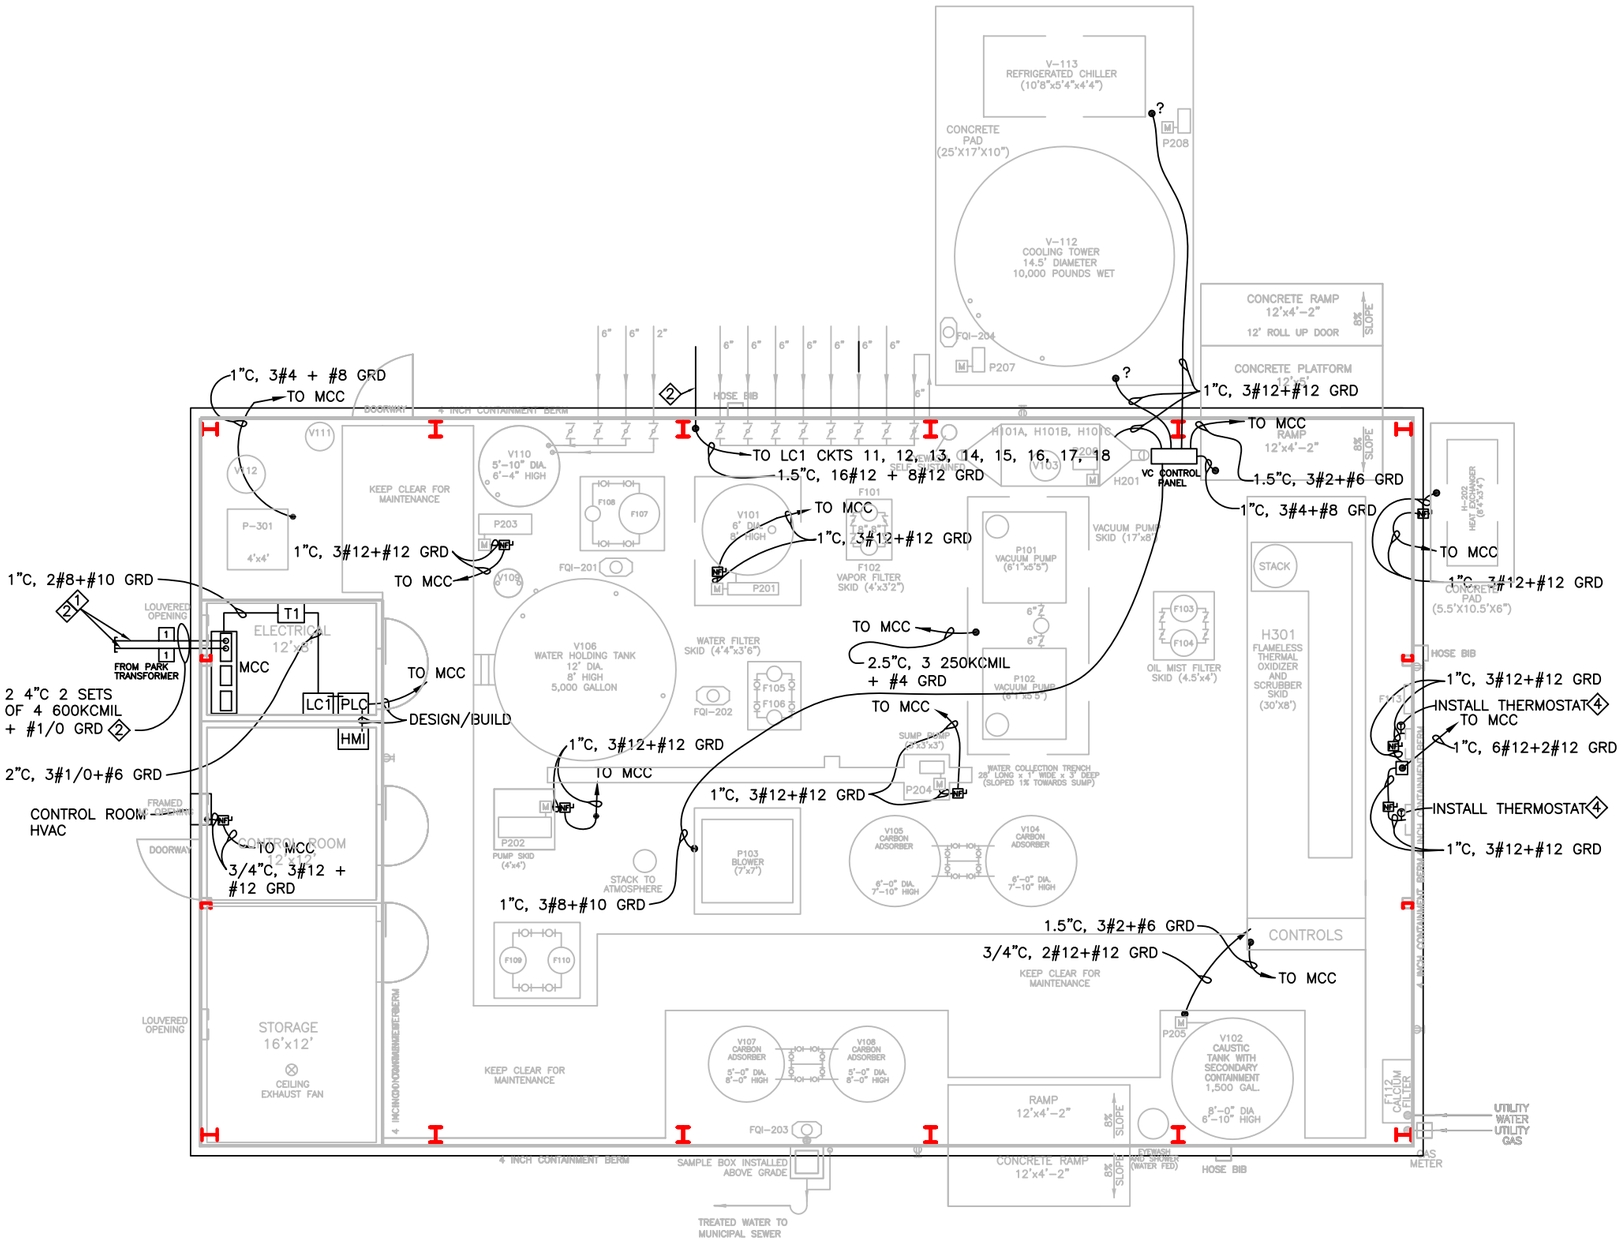

PLAN NOTES:

1. SEE DETAIL 1/E-3
2. SEE DETAIL 2/E-3
3. CONNECTION IS TO BE MADE DIRECTLY TO THE DISCONNECT SWITCH AT EACH SUMP. SEE DWG C-10.
4. INSTALL THERMOSTAT SWITCH WITH ADJUSTABLE SET POINT BETWEEN 80 AND 110°F
5. QUESTION MARKS INDICATE DESIGN/BUILD INFORMATION TO BE PROVIDED IN "AS-BUILT" DRAWINGS BY TREATMENT SYSTEM CONTRACTOR.

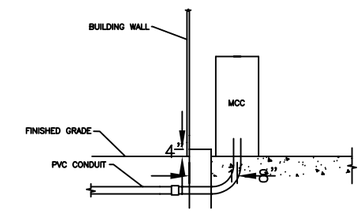

1 E-3 POWER CONNECTION AT MCC

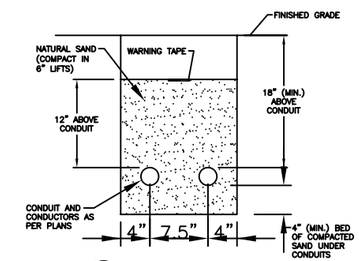

2 E-3 TRENCH DETAIL

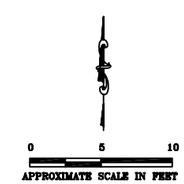

AS-BUILT

TREATMENT COMPOUND ELECTRICAL PLAN

PEMACO SUPERFUND SITE
5050 EAST SLAUSON AVENUE
MAYWOOD, CALIFORNIA

PREPARED FOR:
U.S. Environmental
Protection Agency
Region IX
San Francisco, California

PREPARED BY:
JACOB & HEFNER ASSOCIATES
ENGINEERING · SURVEYING · ENVIRONMENTAL
15375 BARRANCA PARKWAY, SUITE J-101
IRVINE, CALIFORNIA 92618
PHONE: (949) 453-1045

SCALE: AS SHOWN	APPROVED	DATE: 06/13/2007
DESIGNED: J.S.	AS BUILTS	DRAWING
DRAWN: CPL		E-3
CHECKED: J.W.		