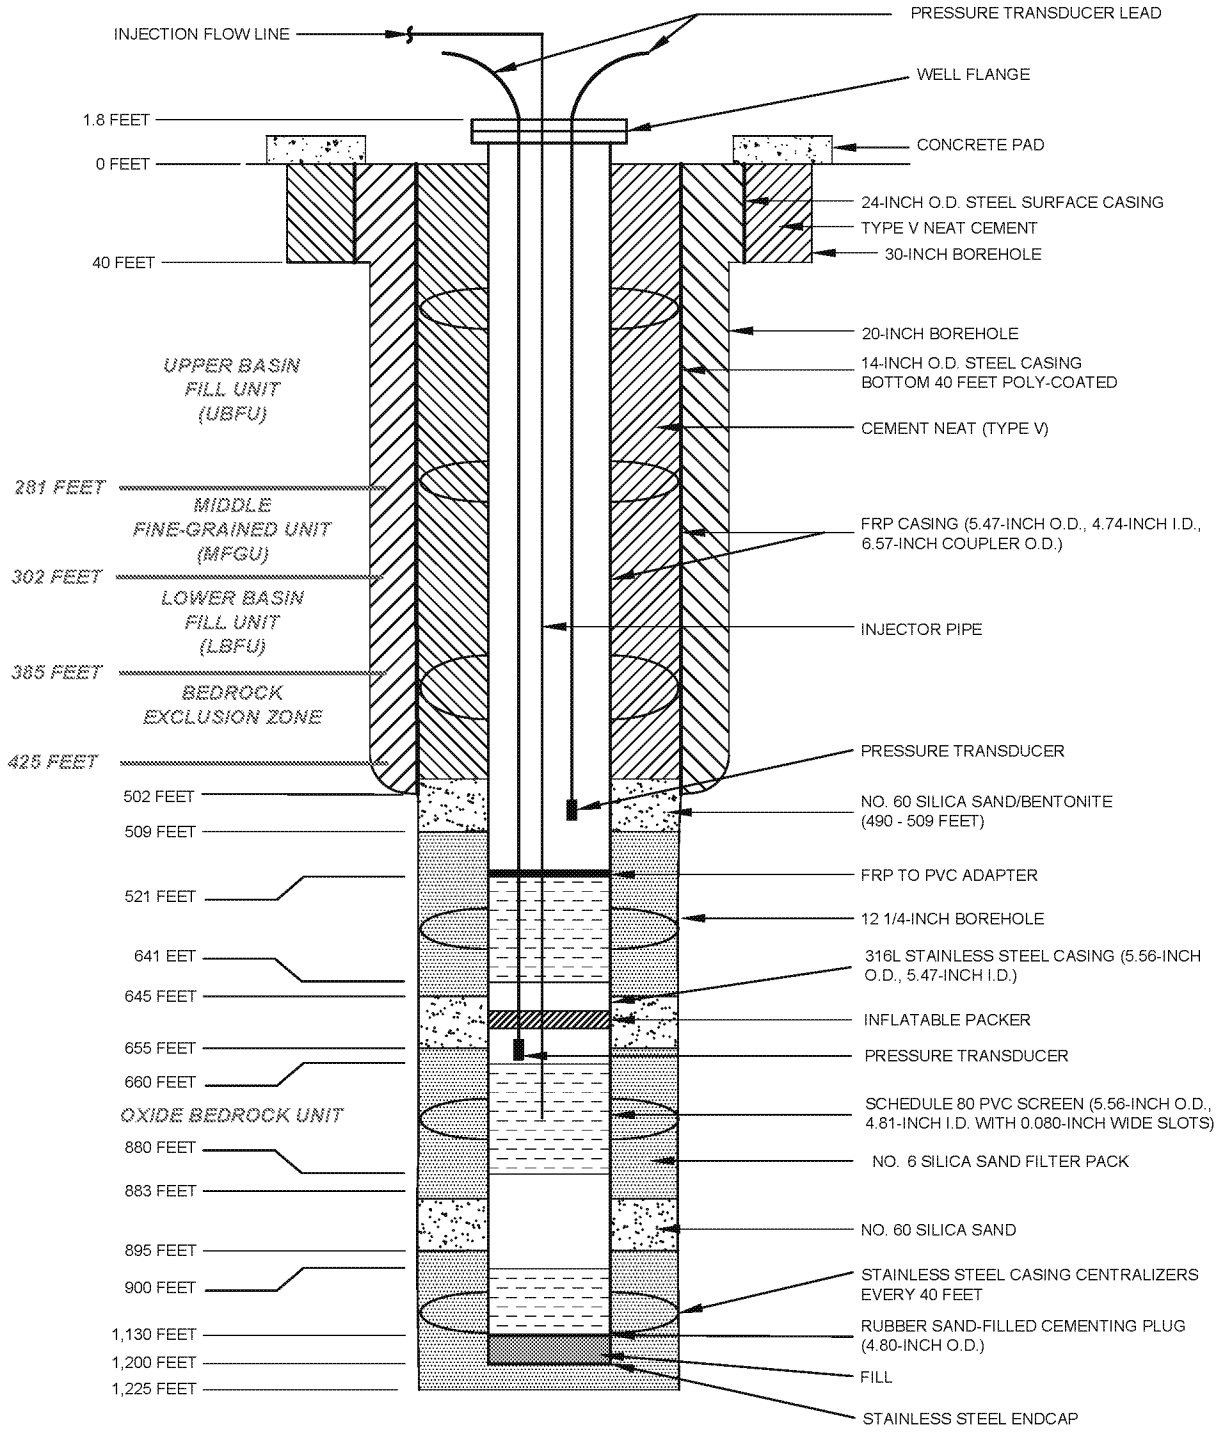

DRAFT

NOTES

1. WELL REGISTRATION NO.: 55-227965
2. CADASTRAL LOCATION: D(4-9) 28 CAC
3. MEASURING POINT ELEVATION: 1480.71 FEET AMSL
4. I.D. = INSIDE DIAMETER
5. O.D. = OUTSIDE DIAMETER
6. PVC = POLYVINYL CHLORIDE
7. FRP = FIBERGLASS REINFORCED PLASTIC
8. SOUNDING TUBE INSTALLED TO ~500 FEET

HALEY ALDRICH

PRODUCTION TEST FACILITY
FLORENCE COPPER, INC.
FLORENCE, ARIZONA

I-03 INJECTION WELL
AS-BUILT DIAGRAM

FLORENCE COPPER

SCALE: NOT TO SCALE
OCTOBER 2018

FIGURE 4

MOBINI, GITA Printed: 10/8/2018 12:21 PM Layout: I-03
E:\PROJECTS\FLORENCE COPPER\CAD\AS-BUILTS\INJECTION WELLS\129687-011_INJECTIONWELL_AS-BUILT.DWG