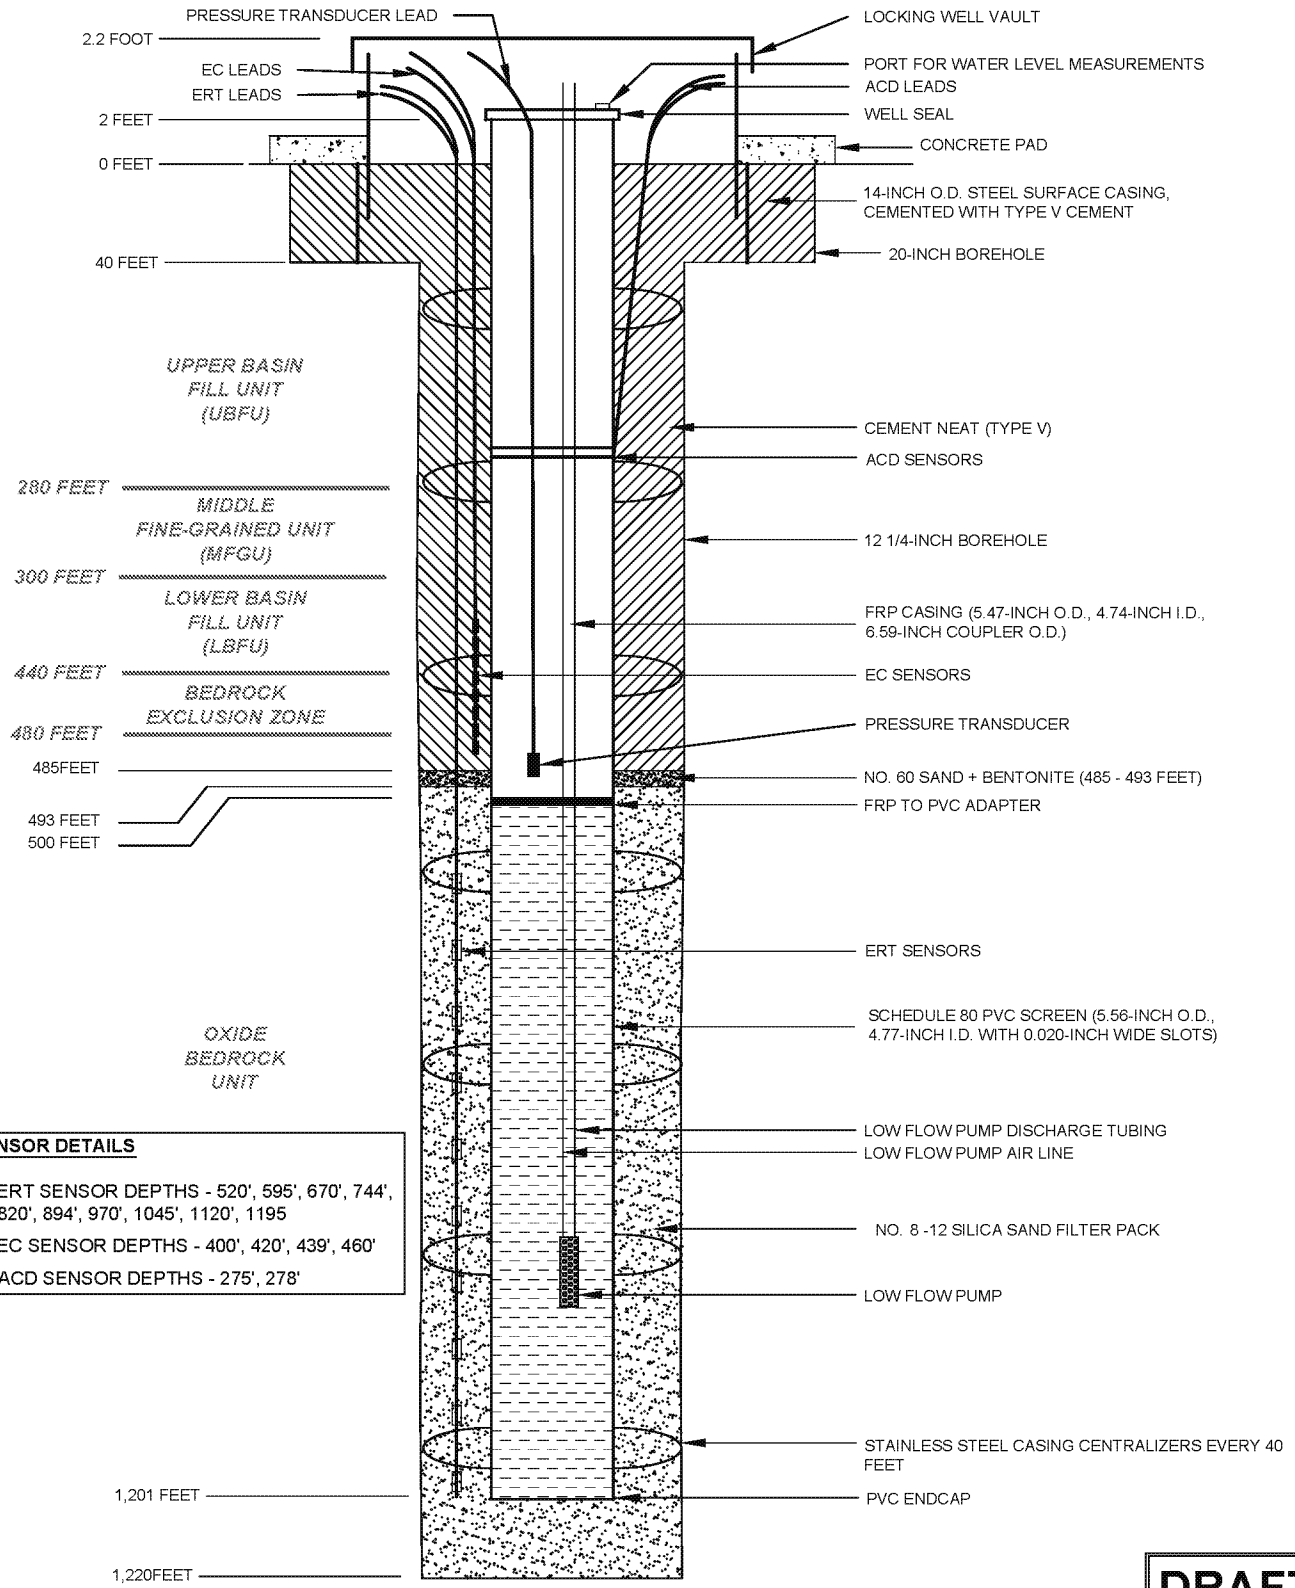


**SENSOR DETAILS**

- ERT SENSOR DEPTHS - 520', 595', 670', 744', 820', 894', 970', 1045', 1120', 1195
- EC SENSOR DEPTHS - 400', 420', 439', 460'
- ACD SENSOR DEPTHS - 275', 278'

**DRAFT**

**NOTES**

1. WELL REGISTRATION NO.: 55-227230
2. CADASTRAL LOCATION: D (4-9) 28 CAC
3. MEASURING POINT ELEVATION: 1481.08' AMSL
4. I.D. = INSIDE DIAMETER
5. O.D. = OUTSIDE DIAMETER
6. PVC = POLYVINYL CHLORIDE
7. FRP = FIBERGLASS REINFORCED PLASTIC
8. ACD = ANNULAR CONDUCTIVITY DEVICE
9. EC = ELECTRICAL CONDUCTIVITY
10. ERT = ELECTRICAL RESISTIVITY TOMOGRAHY

HALEY ALDRICH

PRODUCTION TEST FACILITY
FLORENCE COPPER, INC.
FLORENCE, ARIZONA

O-01 OBSERVATION WELL
AS-BUILT DIAGRAM

FLORENCE COPPER

SCALE: NOT TO SCALE
SEPTEMBER 2018

FIGURE 2

MOBINI, GITA Printed: 8/31/2018 1:45 PM Layout: O-01
E:\PROJECTS\FLORENCE COPPER\CADIAS-BUILTS\OBSERVATION WELLS\129687-011_OBSERVATIONWELL_AS-BUILT.DWG