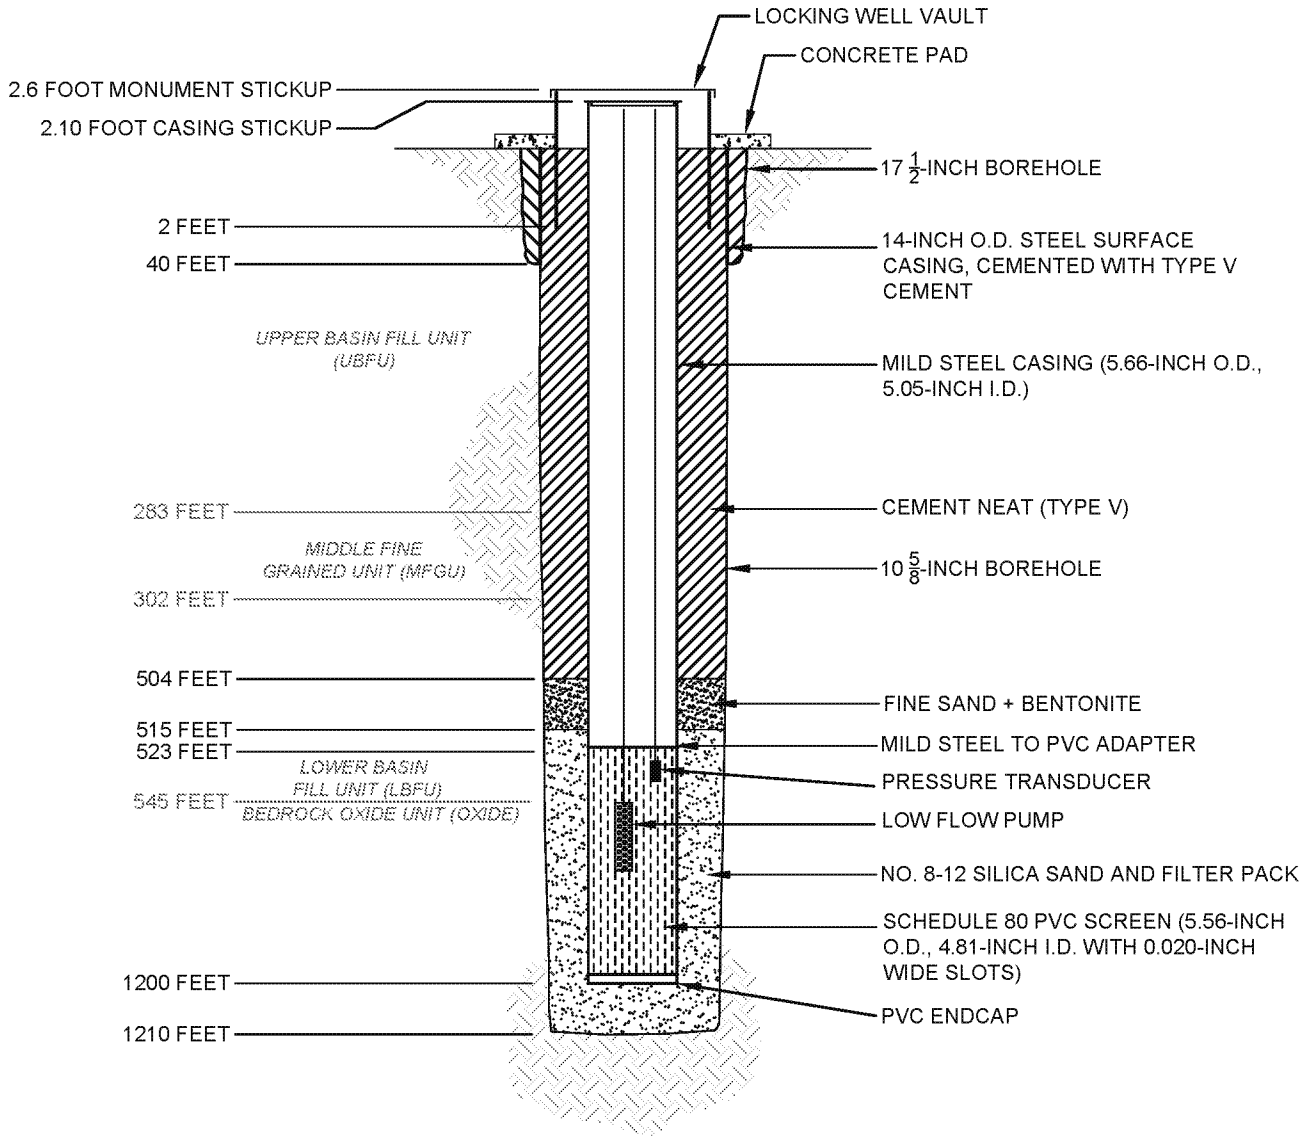


**NOTES**

1. WELL REGISTRATION NO.: 55-226790
2. CADASTRAL LOCATION: D (4-9) 28 CBD
3. TOP OF CASING ELEVATION: 1478.71' AMSL
4. CONCRETE PAD ELEVATION: 1476.77' AMSL
5. I.D. = INSIDE DIAMETER
6. O.D. = OUTSIDE DIAMETER
7. PVC = POLYVINYL CHLORIDE

**DRAFT**

HALEY ALDRICH

PRODUCTION TEST FACILITY
FLORENCE COPPER, INC.
FLORENCE, ARIZONA

M57-O
SUPPLEMENTAL MONITORING
WELL AS-BUILT DIAGRAM

FLORENCE COPPER INC.

SCALE: NOT TO SCALE
SEPTEMBER 2018

FIGURE 2

MOBINI, GITA Printed: 8/31/2018 2:35 PM Layout: M57-O
E:\PROJECTS\FLORENCE COPPER\CADIAS-BUILT\SIMONITORING WELLS\M57-O_WELLDESIGN_ASBUILT.DWG