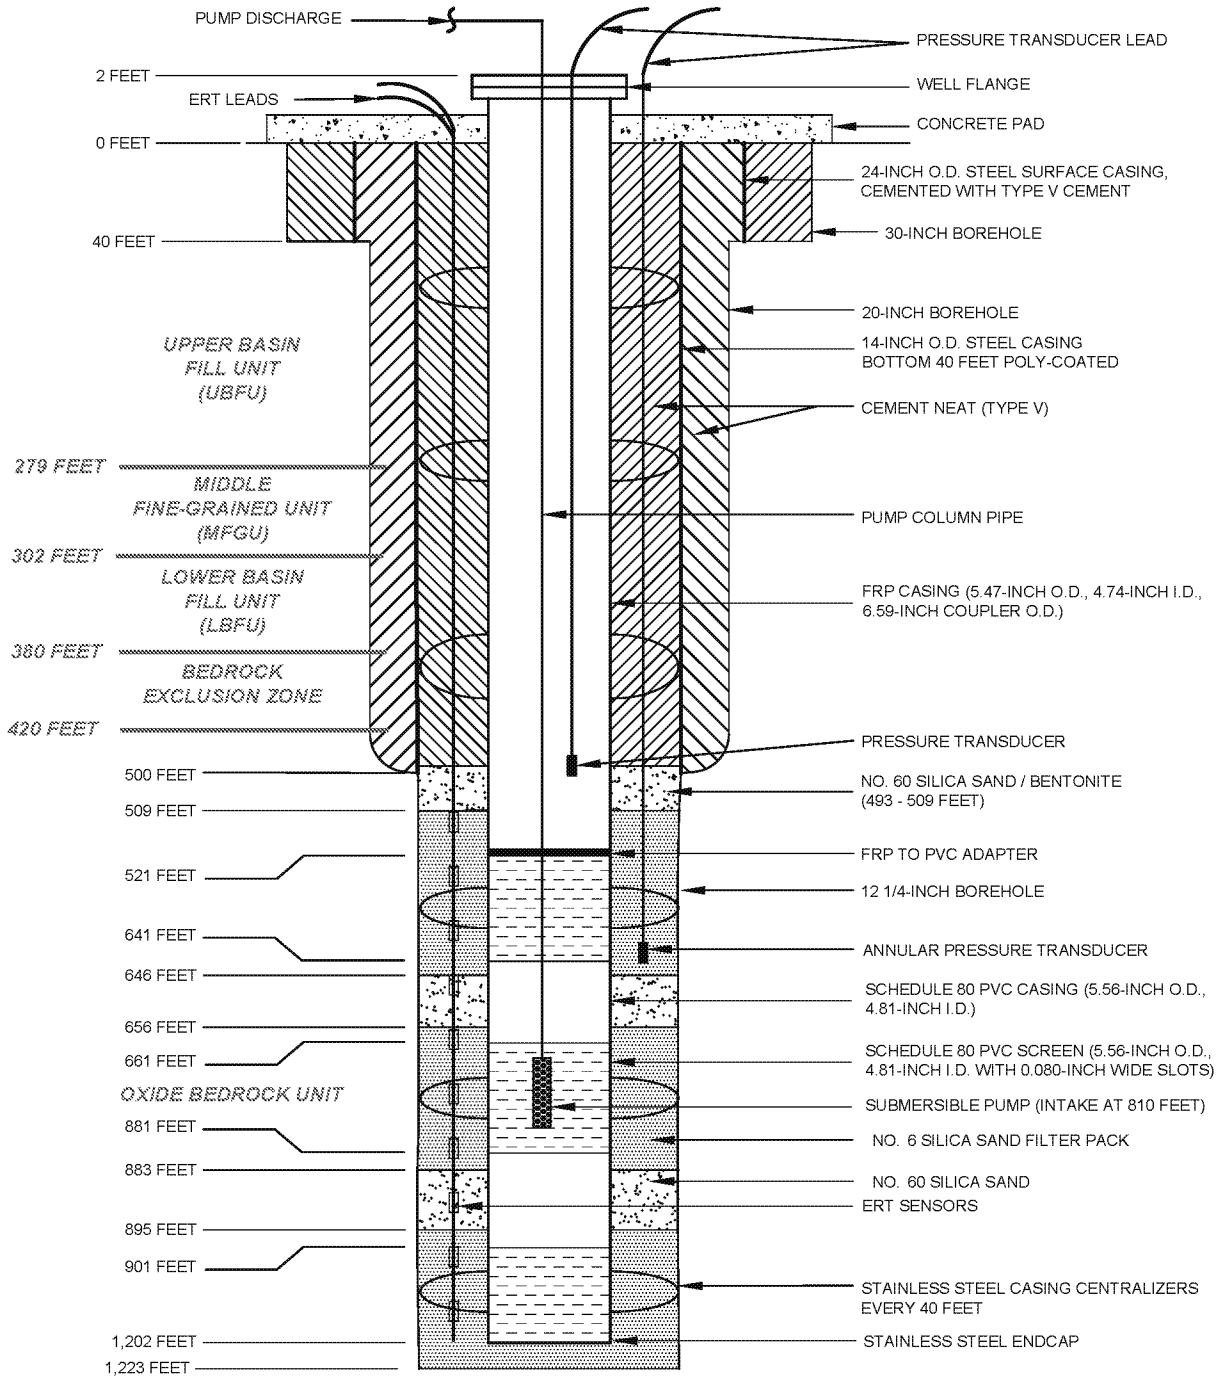

ANNULAR SENSOR DETAILS

- ERT SENSOR DEPTHS - 455, 520, 586, 651, 716, 781, 846, 911, 976, 1041, 1106, 1171
- ANNULAR TRANSDUCER DEPTH - 636 FEET

NOTES

1. WELL REGISTRATION NO.: 55-227704
2. CADASTRAL LOCATION: D(4-9) 28 CAC
3. MEASURING POINT ELEVATION; 1480.41 FEET AMSL
4. I.D. = INSIDE DIAMETER
5. O.D. = OUTSIDE DIAMETER
6. PVC = POLYVINYL CHLORIDE
7. FRP = FIBERGLASS REINFORCED PLASTIC
8. ERT = ELECTRICAL RESISTIVITY TOMOGRAHY
9. SOUNDING TUBE INSTALLED TO ~ 500 FEET

DRAFT

HALEY ALDRICH

PRODUCTION TEST FACILITY
FLORENCE COPPER, INC.
FLORENCE, ARIZONA

R-05 RECOVERY WELL
AS-BUILT DIAGRAM

FLORENCE COPPER

SCALE: NOT TO SCALE
SEPTEMBER 2018

FIGURE 4

MOBINI, GITA Printed: 8/31/2018 3:00 PM Layout: R-05
E:\PROJECTS\FLORENCE COPPER\CAD\AS-BUILTS\RECOVERY WELLS\129687-011_RECOVERYWELL_AS-BUILT.DWG