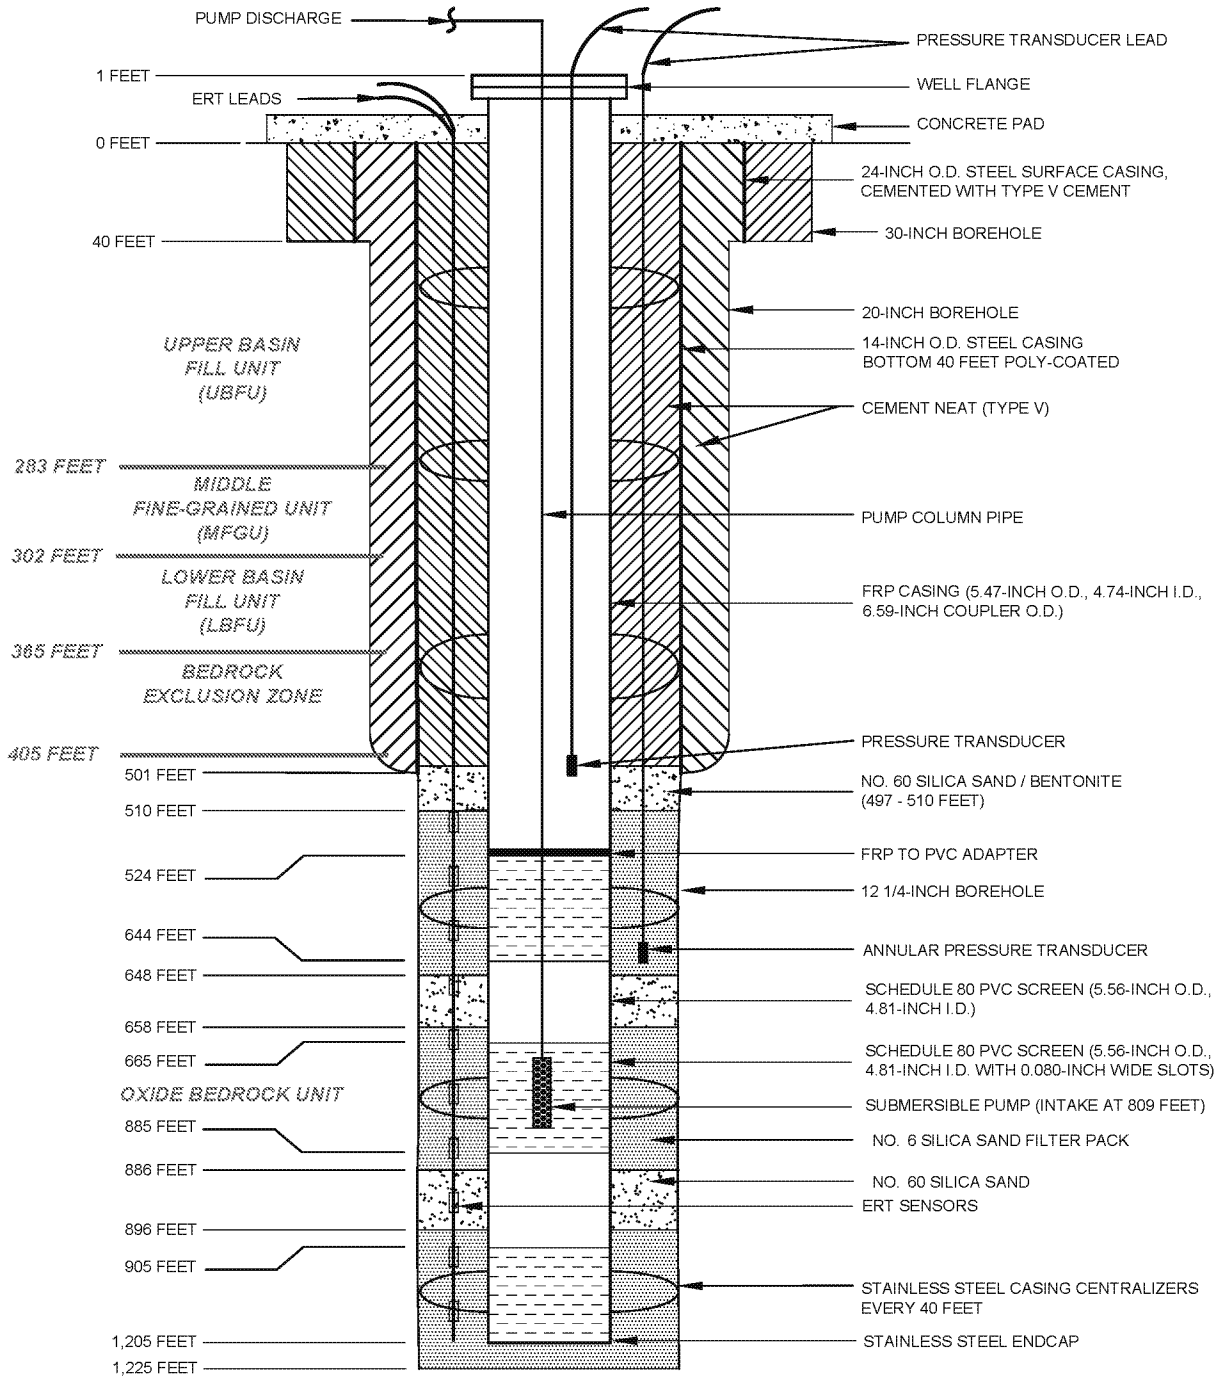

ANNULAR SENSOR DETAILS

- ERT SENSOR DEPTHS - 634, 694, 754, 814, 874, 934, 994, 1054, 1114, 1175
- ANNULAR TRANSDUCER DEPTH - 637 FEET

NOTES

1. WELL REGISTRATION NO.: 55-227707
2. CADASTRAL LOCATION: D(4-9) 28 CBD
3. MEASURING POINT ELEVATION; 1480.51 FEET AMSL
4. I.D. = INSIDE DIAMETER
5. O.D. = OUTSIDE DIAMETER
6. PVC = POLYVINYL CHLORIDE
7. FRP = FIBERGLASS REINFORCED PLASTIC
8. ERT = ELECTRICAL RESISTIVITY TOMOGRAHY
9. SOUNDING TUBE INSTALLED TO ~ 500 FEET

DRAFT

HALEY ALDRICH

PRODUCTION TEST FACILITY
FLORENCE COPPER, INC.
FLORENCE, ARIZONA

R-08 RECOVERY WELL
AS-BUILT DIAGRAM

FLORENCE COPPER

SCALE: NOT TO SCALE
SEPTEMBER 2018

FIGURE 4

MOBINI, GITA Printed: 8/31/2018 2:59 PM Layout: R-08
E:\PROJECTS\FLORENCE COPPER\CAD\AS-BUILTS\RECOVERY WELLS\129687-011_RECOVERYWELL_AS-BUILT.DWG