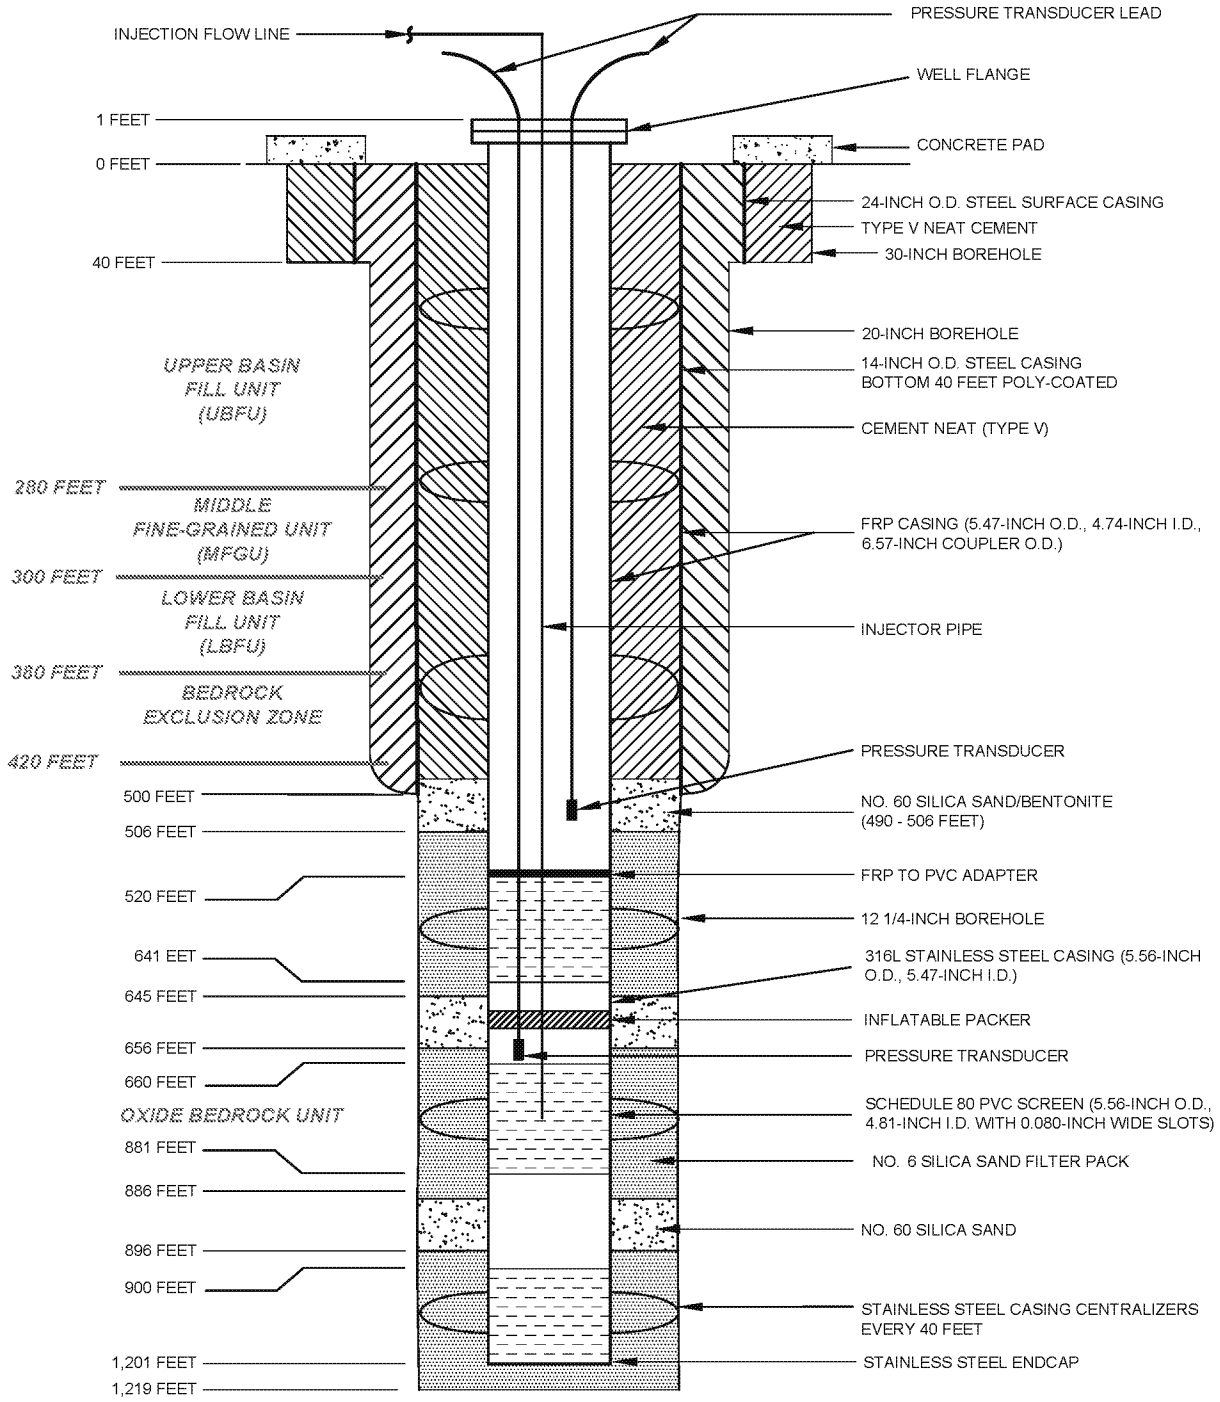

DRAFT

NOTES

1. WELL REGISTRATION NO.: 55-227964
2. CADASTRAL LOCATION: D(4-9) 28 CAC
3. MEASURING POINT ELEVATION: 1482.61 FEET AMSL
4. I.D. = INSIDE DIAMETER
5. O.D. = OUTSIDE DIAMETER
6. PVC = POLYVINYL CHLORIDE
7. FRP = FIBERGLASS REINFORCED PLASTIC
8. SOUNDING TUBE INSTALLED TO ~500 FEET

HALEY ALDRICH

PRODUCTION TEST FACILITY
FLORENCE COPPER, INC.
FLORENCE, ARIZONA

INJECTION WELL I-02
AS-BUILT DIAGRAM

FLORENCE COPPER

SCALE: NOT TO SCALE
SEPTEMBER 2018

FIGURE 4

MOBINI, GITA Printed: 8/31/2018 11:20 AM Layout: I-02
E:\PROJECTS\FLORENCE COPPER\CADIAS-BUILTS\INJECTION WELLS\129687-011_INJECTIONWELL_AS-BUILT.DWG