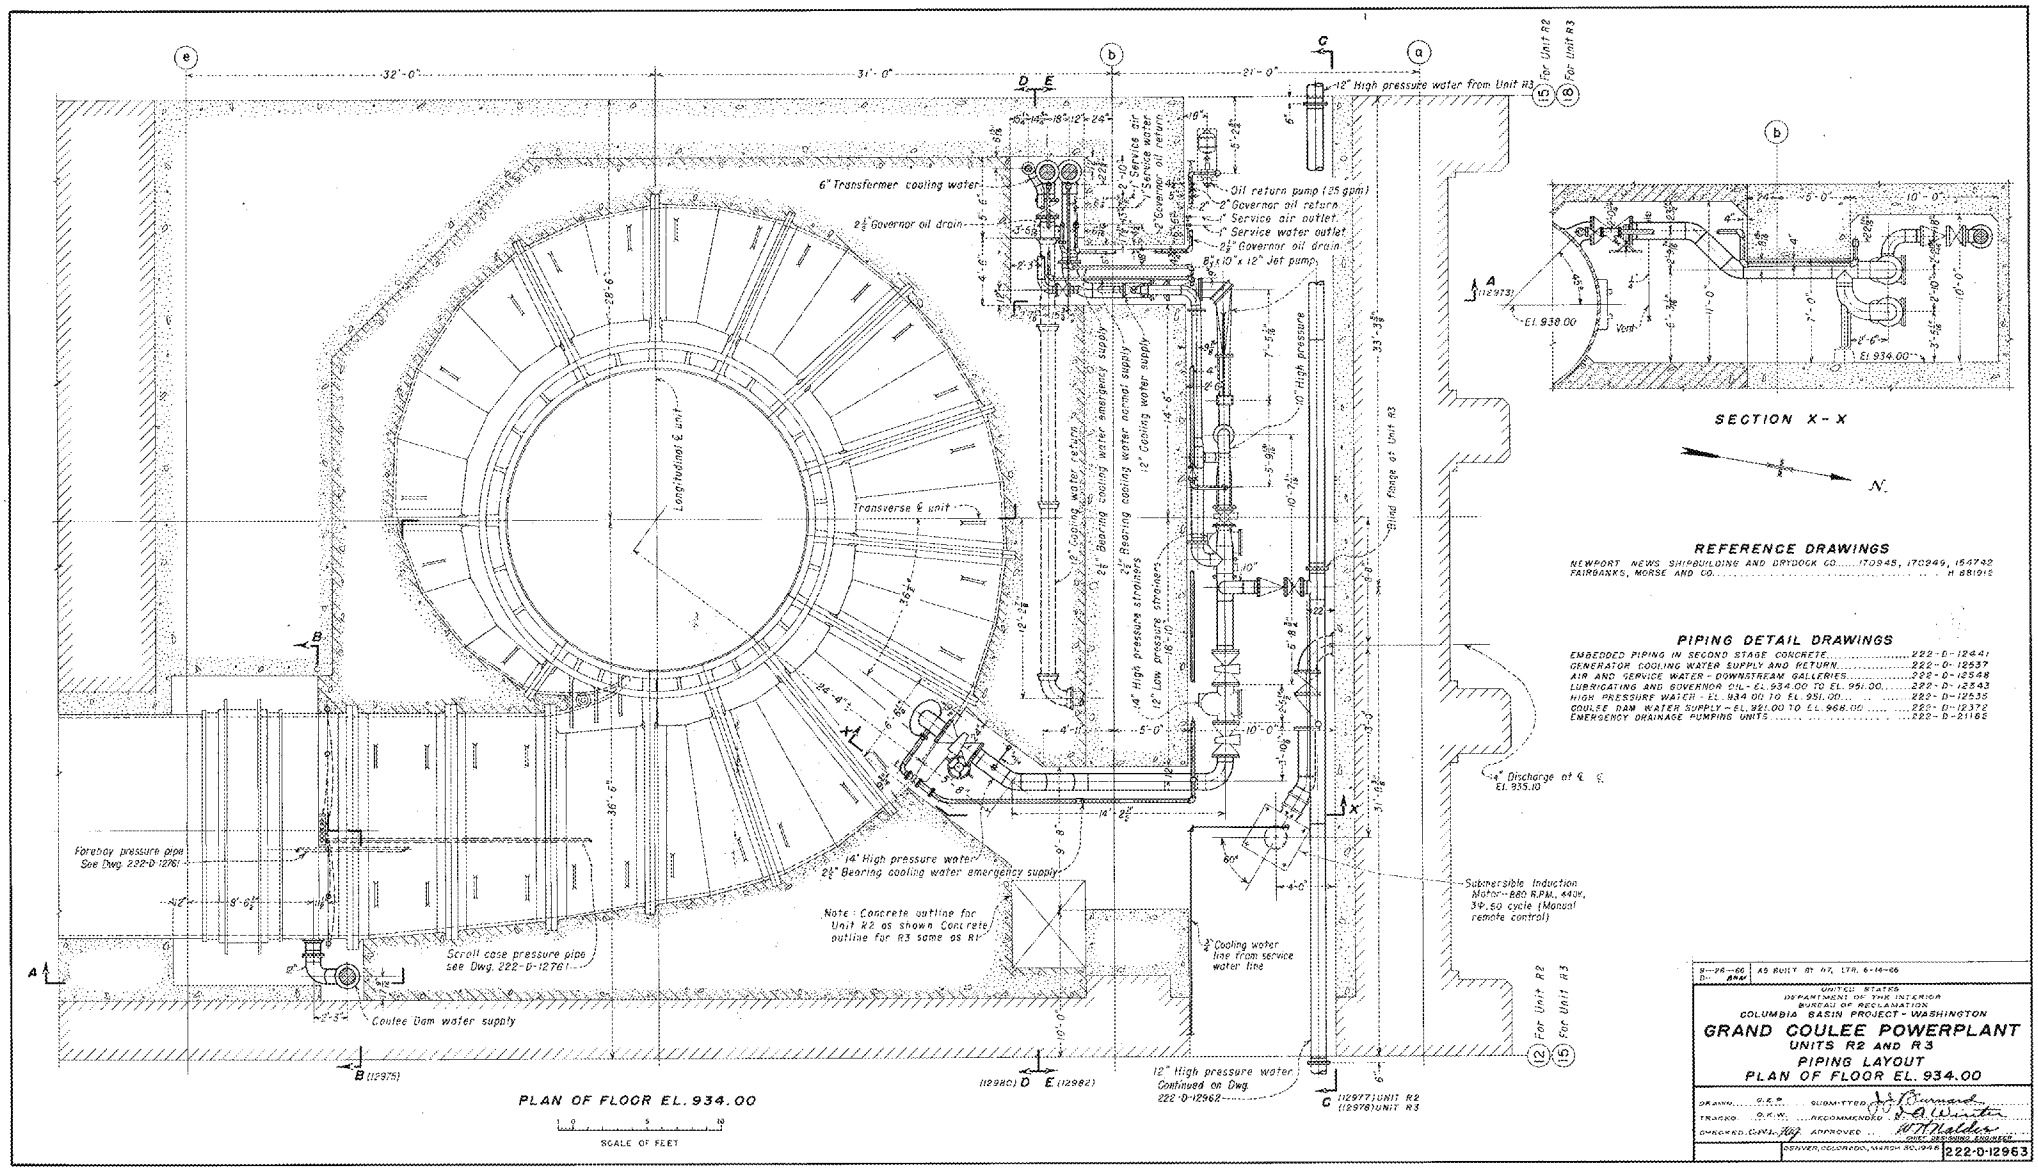

REFERENCE DRAWINGS

NEWPORT NEWS SHIPBUILDING AND DRYDOCK CO. 170945, 170949, 154742
FAIRBANKS, MORSE AND CO. ..... H 881912

PIPING DETAIL DRAWINGS

EMBEDDED PIPING IN SECOND STAGE CONCRETE 222-D-12441
GENERATOR COOLING WATER SUPPLY AND RETURN 222-D-12537
AIR AND SERVICE WATER - DOWNSTREAM GALLERIES 222-D-12548
LUBRICATING AND GOVERNOR OIL - EL. 934.00 TO EL. 951.00 ..... 222-D-12543
HIGH PRESSURE WATER - EL. 934.00 TO EL. 951.00 ..... 222-D-12535
COULEE DAM WATER SUPPLY - EL. 921.00 TO EL. 968.00 ..... 222-D-12372
EMERGENCY DRAINAGE PUMPING UNITS 222-D-21165

9-26-66 D- ARM	AS BUILT BY DT, LTR. 6-14-66

UNITED STATES
DEPARTMENT OF THE INTERIOR
BUREAU OF RECLAMATION
COLUMBIA BASIN PROJECT - WASHINGTON

GRAND COULEE POWERPLANT
UNITS R2 AND R3
PIPING LAYOUT
PLAN OF FLOOR EL. 934.00

DRAWN G.E.B. SUBMITTED J. J. Barnard
TRACED O.K.W. RECOMMENDED D. A. Winter
CHECKED C.N.J. APPROVED W. H. Nalder
CHIEF DESIGNING ENGINEER

DENVER, COLORADO, MARCH 30, 1948 222-D-12963

ED_004421A_00354499-00001