


1/1 **PROFILE THROUGH DAM- STEEL MEMBRANE**
PROFILE 1"=40'

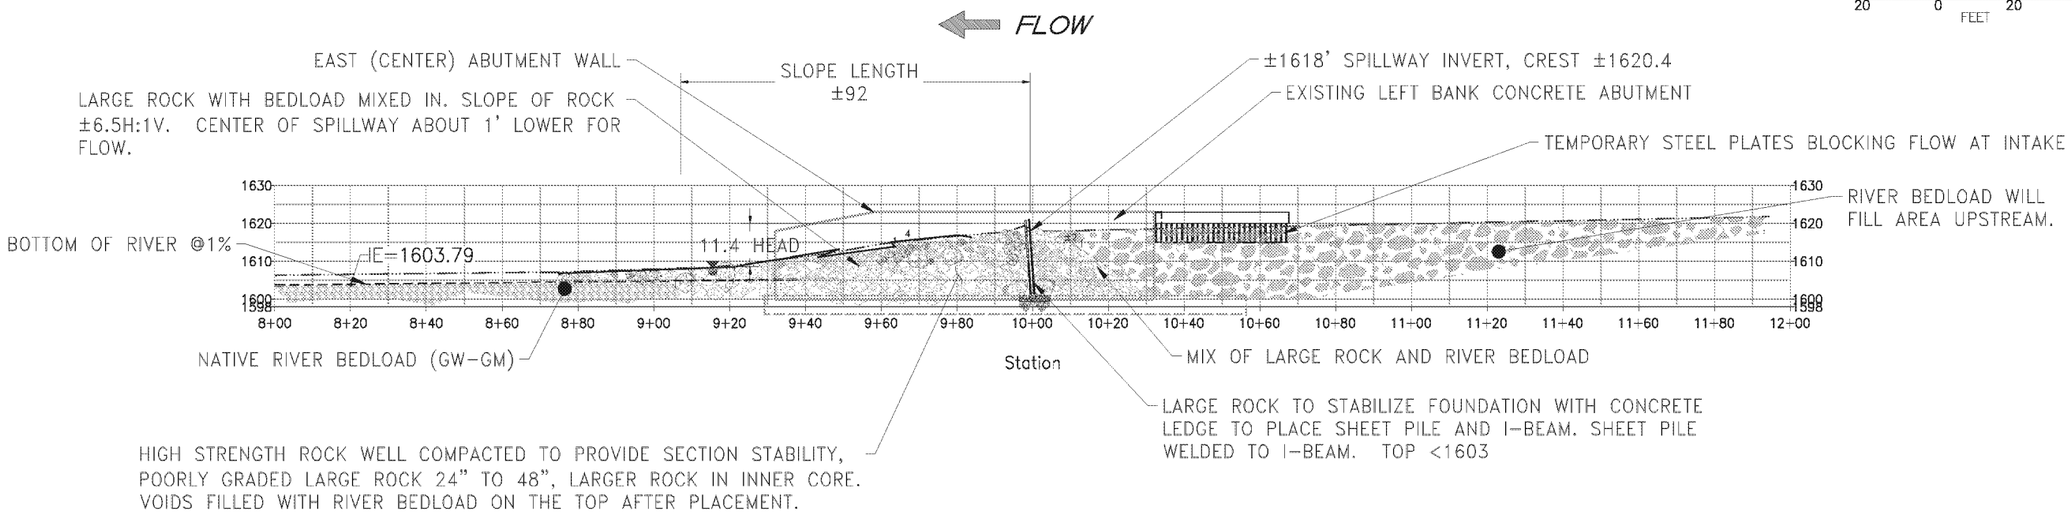


2/1 **PROFILE THROUGH DAM - STEEL MEMBRANE**
PROFILE 1"=10'

Note:
Information shown is approximate and does not reflect the results or surveying or engineering measurement.

| NO. | DATE | REVISION | BY | CK |
|---|---|---|---|---|
| 1 | 11/03/20 | PRELIMINARY PROFILE & SECTION | SPG | |
| 2 | 11/5/20 | REVISIONS | SG | JAF |
| 3 | | | | |
| 4 | | | | |
| 5 | | | | |
| 6 | | | | |
| 7 | | | | |
| 8 | | | | |
| 9 | | | | |

ELECTRON HYDROELECTRIC PROJECT
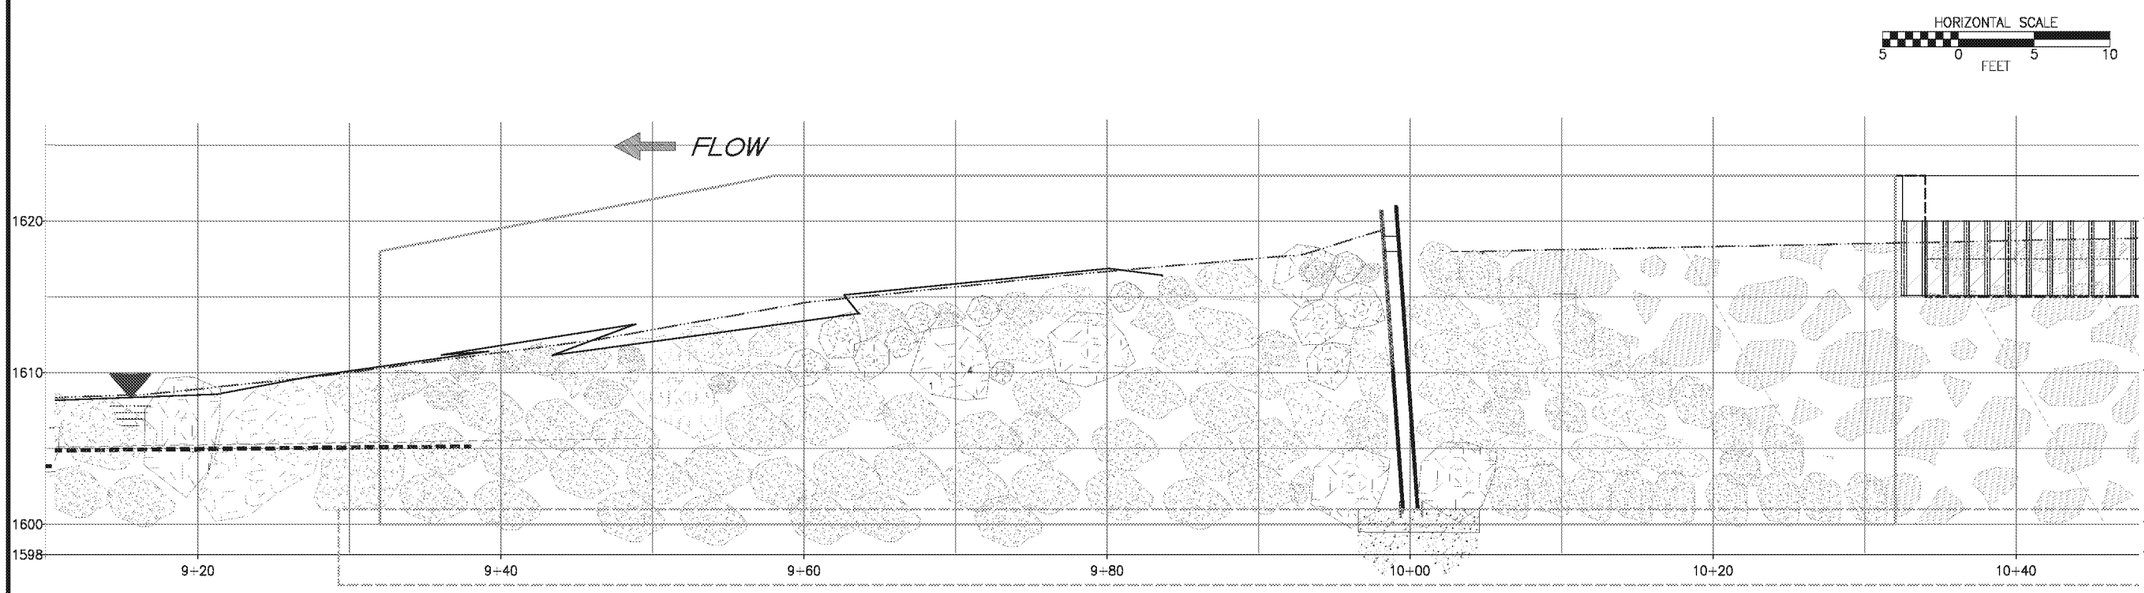
# TEMPORARY DIVERSION ROCK SPILLWAY, AS-CONSTRUCTED

PIERCE COUNTY WASHINGTON

DESIGN:
DRAWN:
CHECKED:
DATE: 11/03/2020
JOB#: 11011900

SHEET 2 OF 3

DRAWING
2