SECTION LOOKING DOWNSTREAM

HORIZONTAL SCALE
10 0 10 20
FEET

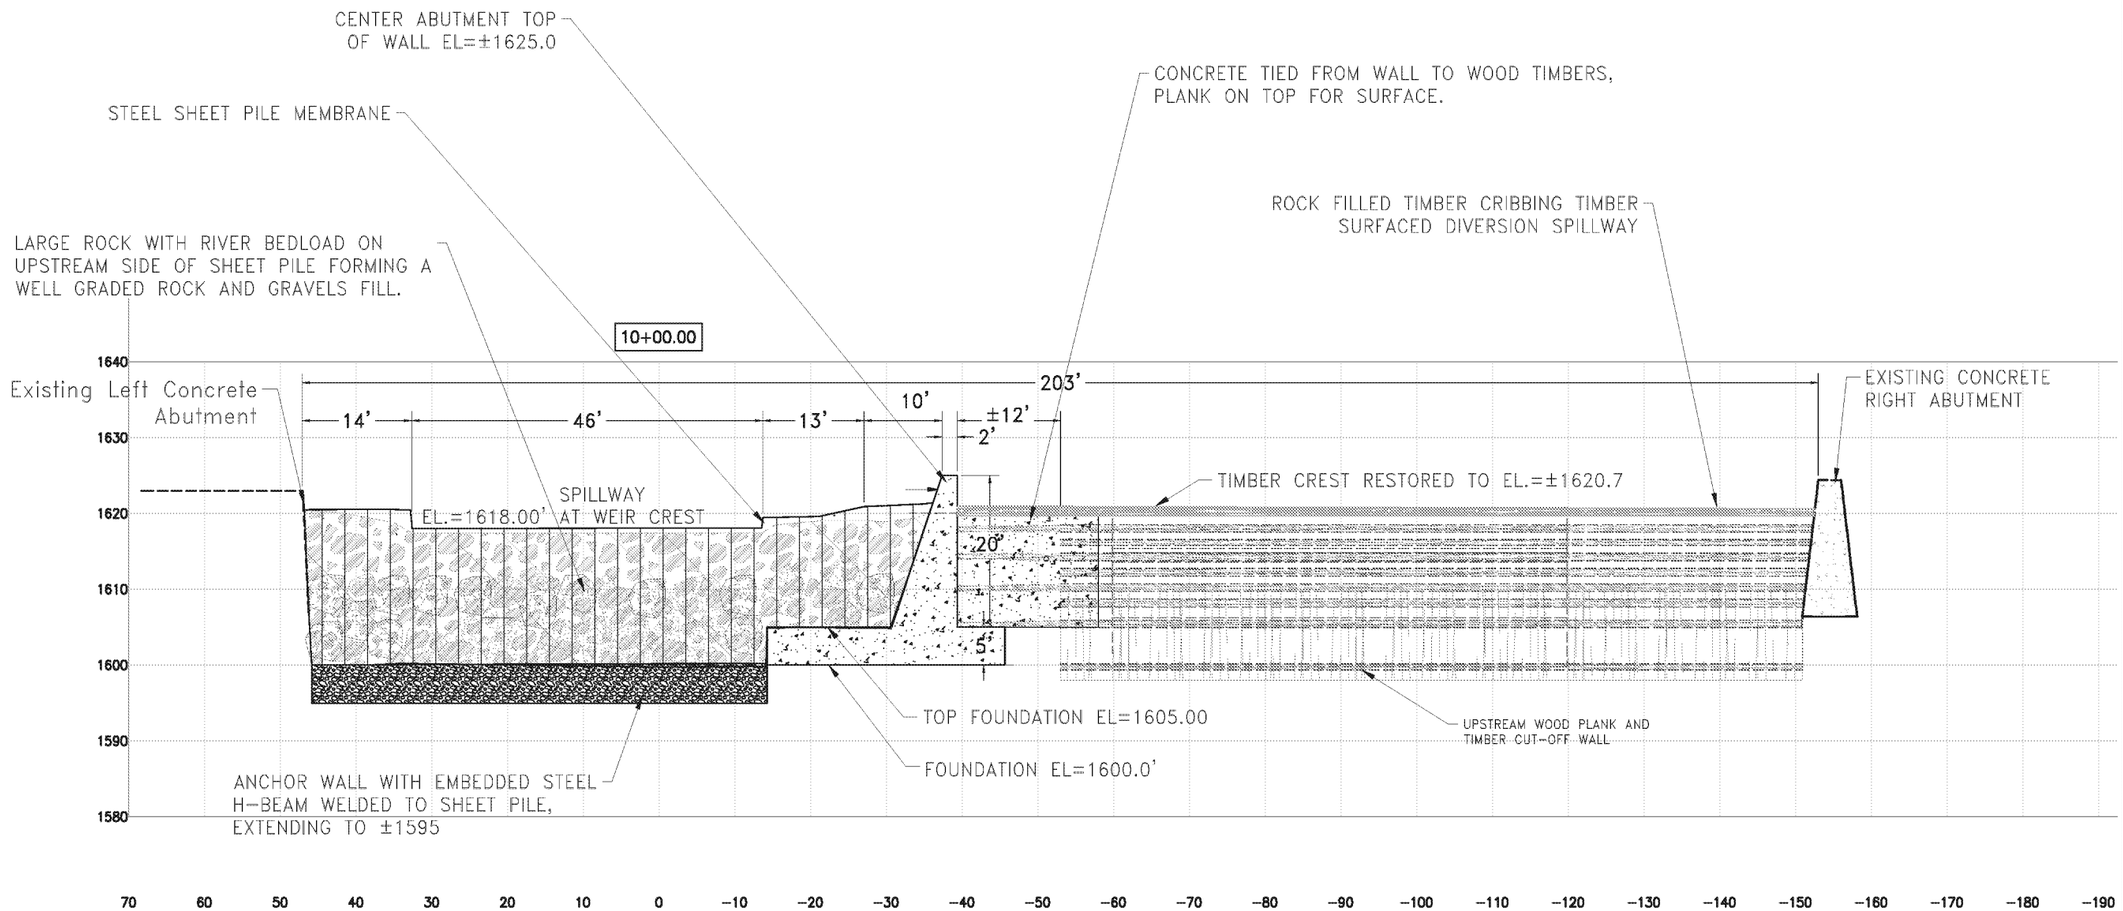

1/3 **RIVER SECTION 12+66.43- CENTER OF ROCK SPILLWAY**
SECTION 1"= 20'

Note:
Information shown is approximate and was prepared for engineering measurements.

NO.	DATE	REVISION	BY	CK
1	11/3/20	PRELIMINARY AS-BUILT	SG	
2				
3				
4				
5				
6				
7				
8				
9				

ELECTRON HYDROELECTRIC PROJECT

TEMPORARY DIVERSION ROCK SPILLWAY, AS-CONSTRUCTED

PIERCE COUNTY WASHINGTON

SCALE: 1" = 20'

DESIGN: SPG
DRAWN: SG
CHECKED: TAF
DATE: 11/03/2020
JOB#: 11011900

SHEET 3 OF 3

DRAWING 3