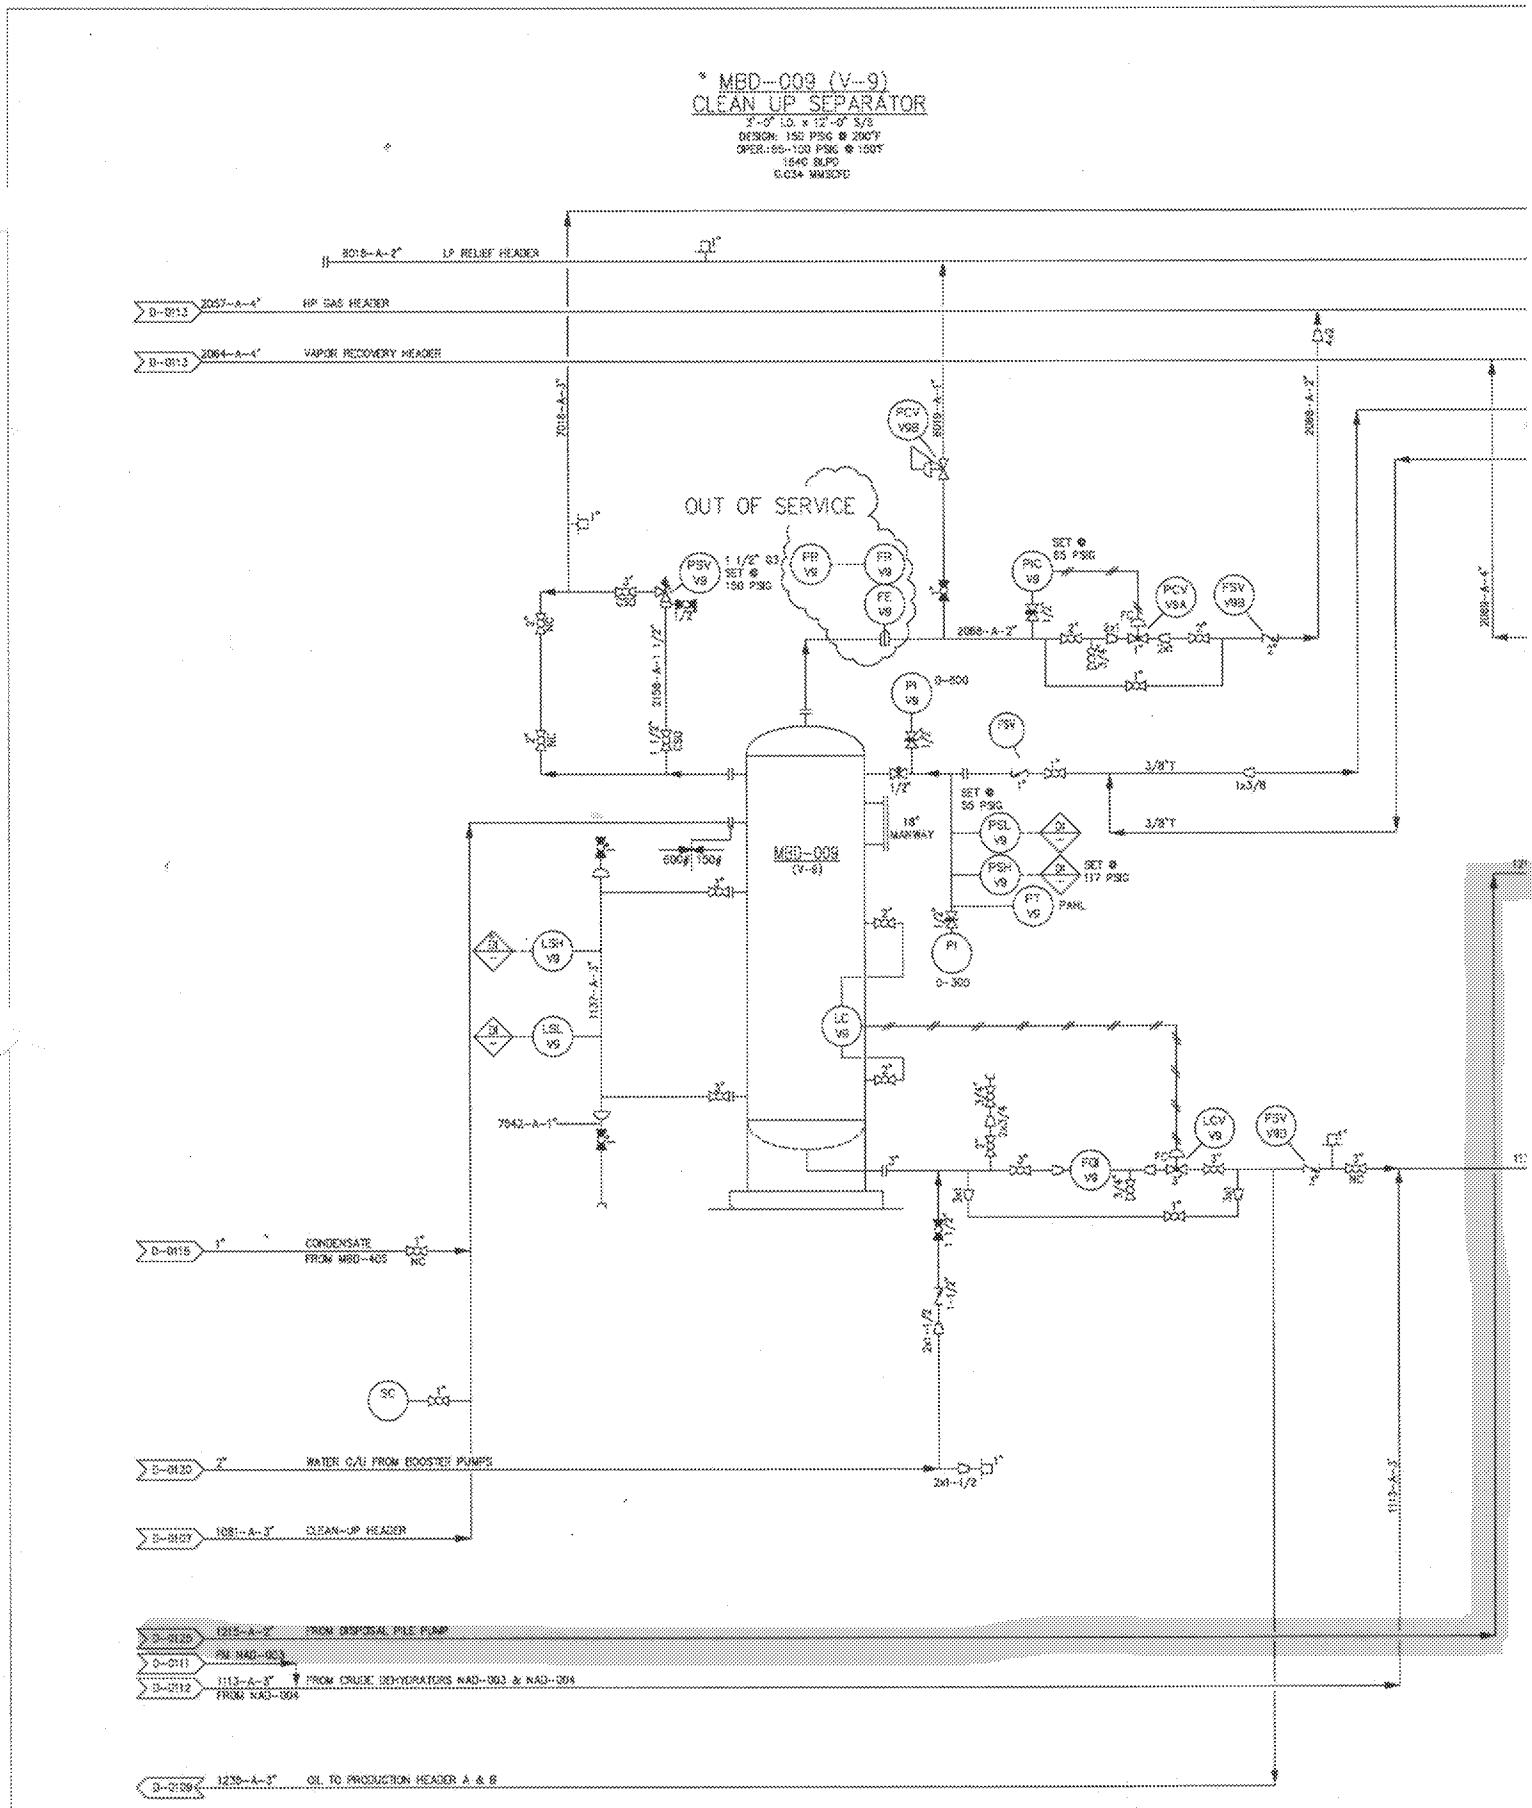

NUMBER	REFERENCE DRAWINGS

VANSON ENGINEERING CO.

ANAHEIM, CALIFORNIA

VANSON DWG NO. D-7064 JOB NO. 2691-06

PROCESSES UNLIMITED DWG NO. E-H-1370 REV. 7A

REV. NO.	DATE	REVISED
8	03/01/16	UPDATED PER OPERATOR REDLINES
7	07/01/15	REVISED
6	04/20/15	UPDATED WITH API RP 14C DESIGNATIONS
5	07/28/14	UPDATED PER OPERATOR REDLINES
4	03/01/12	UPDATED PER FIELD VERIFICATION WORK
3	10/31/11	UPDATED POST-PHA
2	03/25/11	UPDATED PER OPERATOR REDLINES
1	03/04/11	UPDATED PER OPERATOR REDLINES
0	08/09/08	AS-BUILT

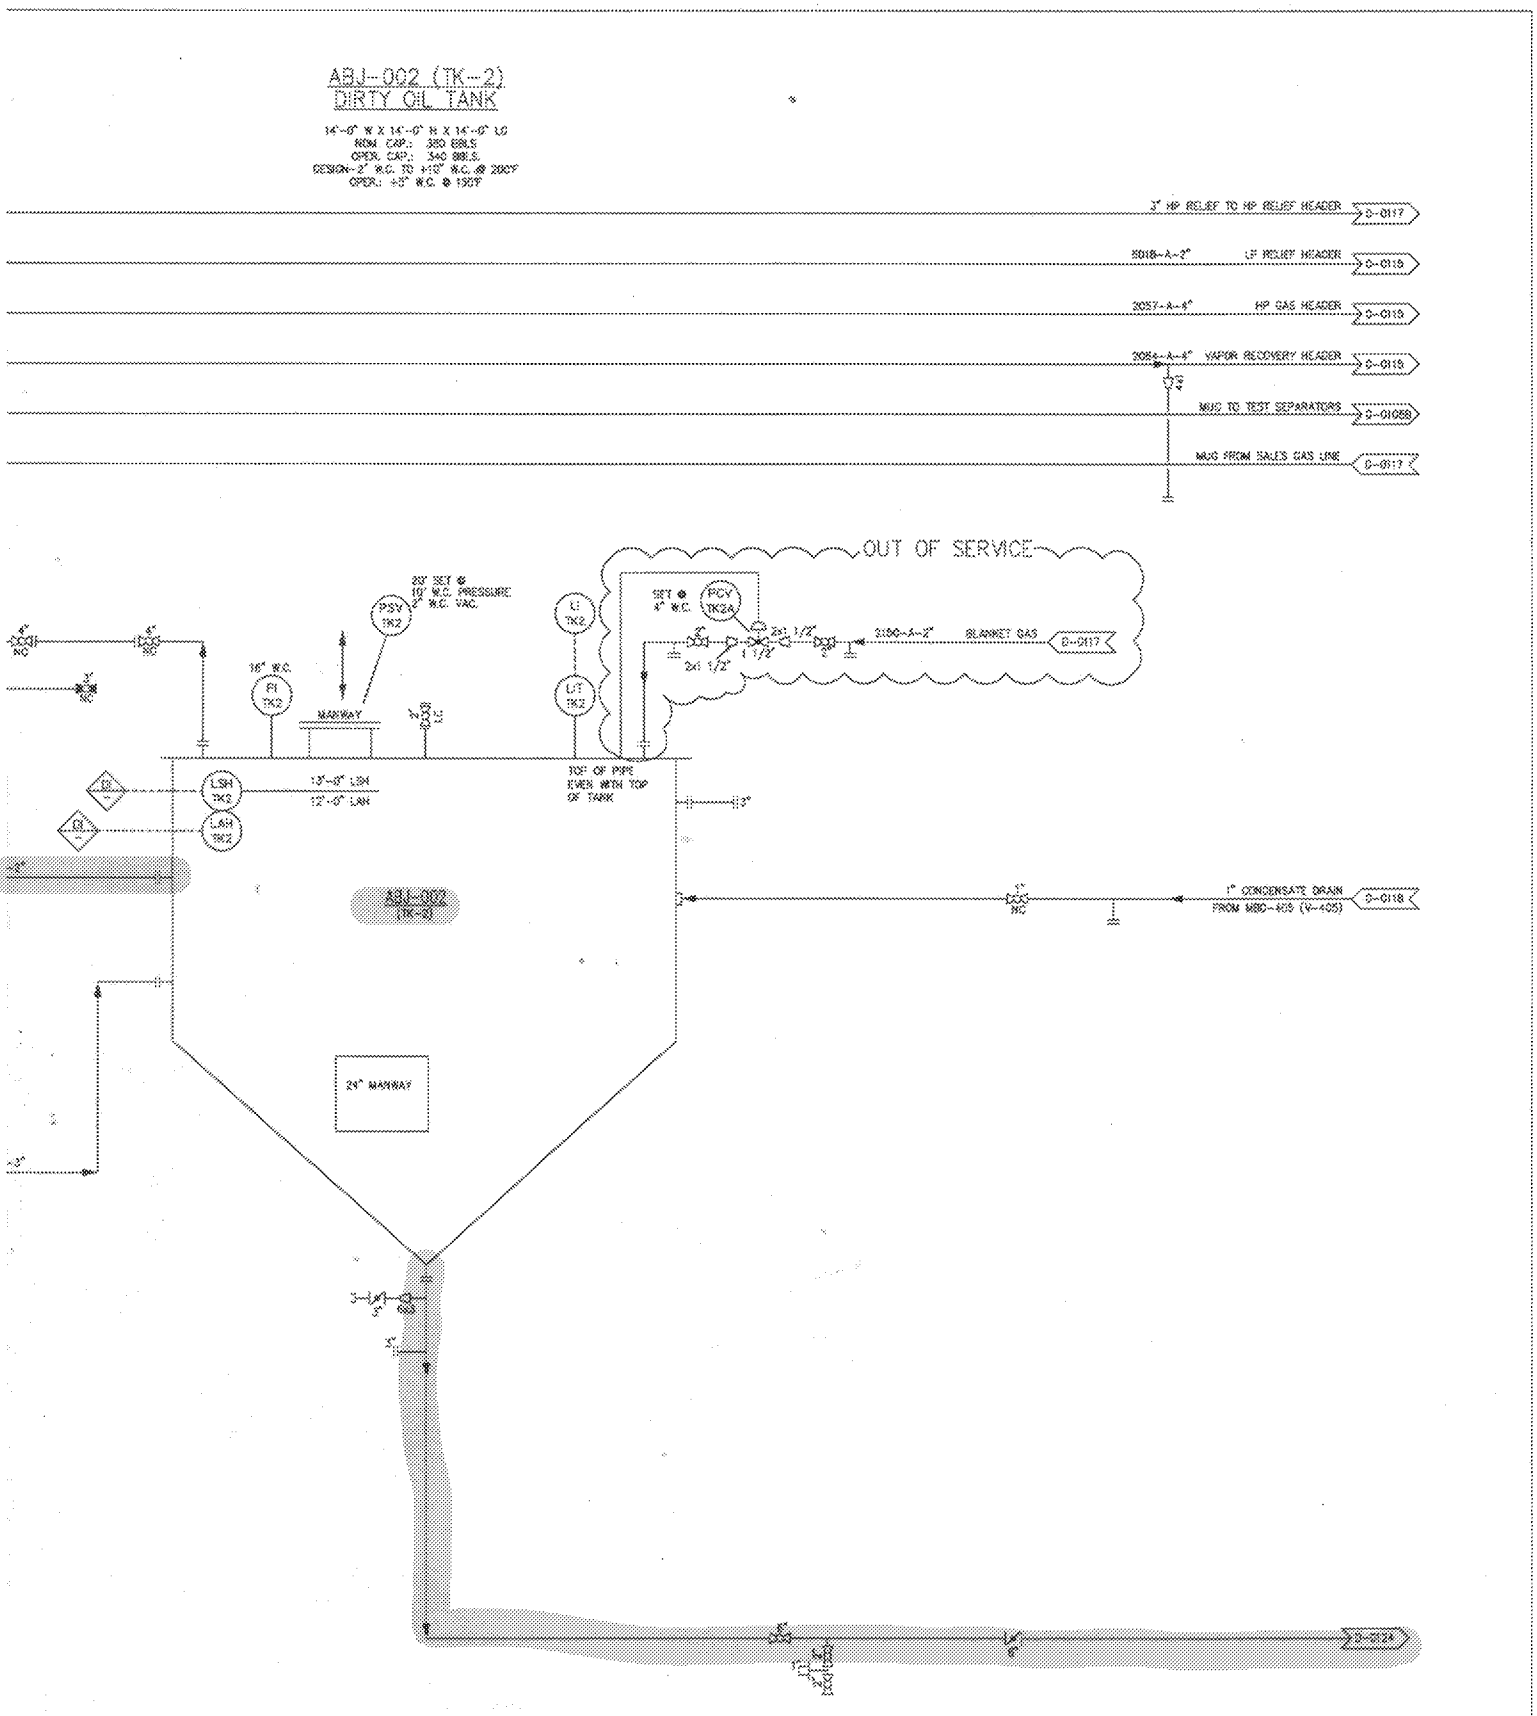

EH			
EH			
EH			
EH			
EC			
EC			
EC			
EC			
MB	DS	EC	
REV. BY	CKD. BY	APP'D	

DOS CUADRAS OFFSHORE RESOURCES, L.L.C.

DCOR

DRAWN BY:	MB	DATE:	8/24/06
DESIGN:	DS	DATE:	8/24/06
CHECK:		DATE:	
ENGINEER:	RLS	DATE:	8/24/06
APPROVED:		DATE:	
APPROVED:		DATE:	
APPROVED:		DATE:	

PIPING & INSTRUMENTATION DIAGRAM
WELL CLEAN-UP SYSTEM
PLATFORM EDITH
SEAL BEACH, CALIFORNIA

SCALE:	DWG NO:	SHT:	REV. NO.
NONE	DCOR-ED-PP-D-0114		8