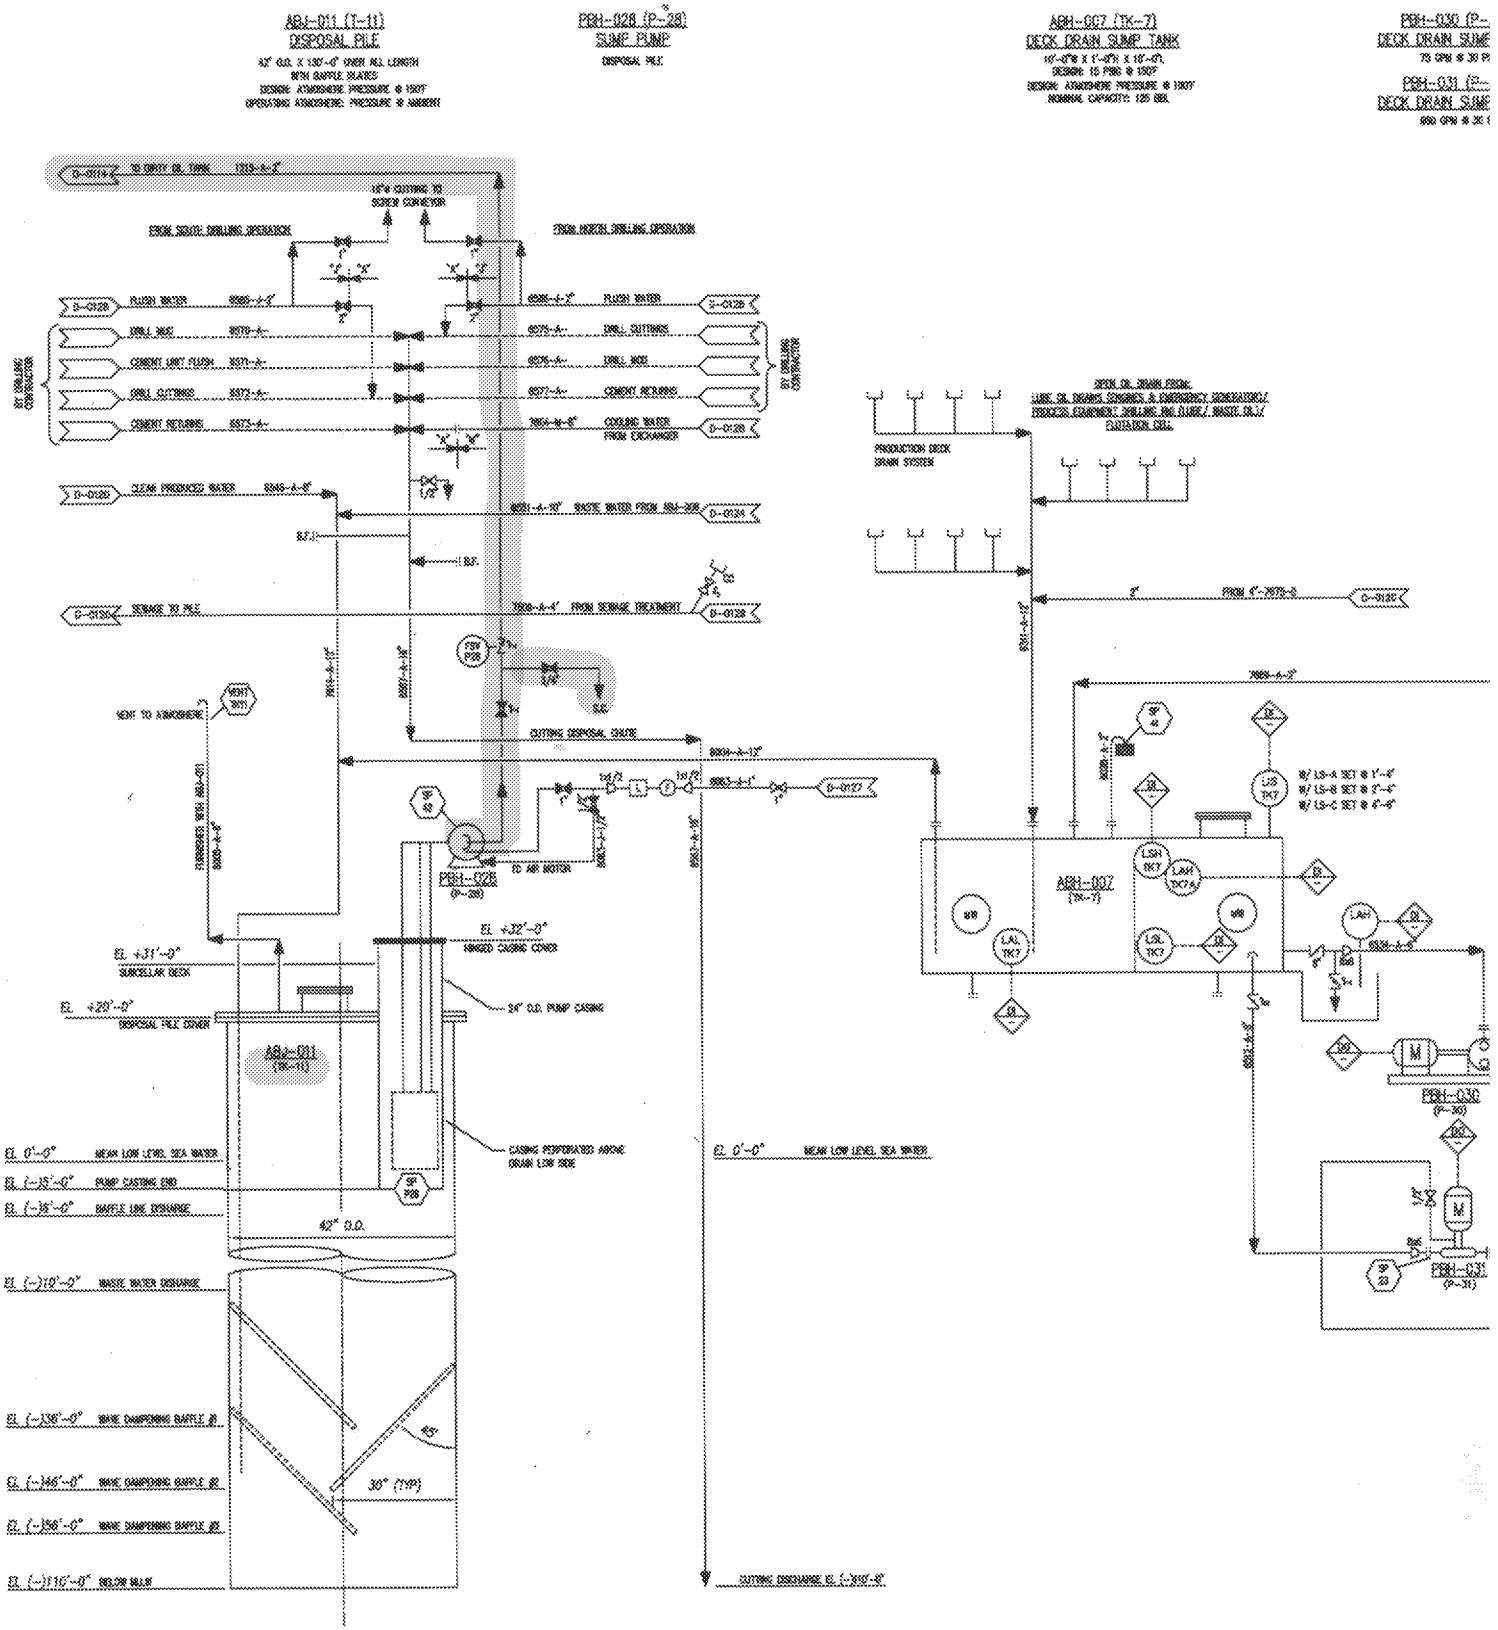

		VANSON ENGINEERING CO.			
		ANAHEIM, CALIFORNIA	5	07/01/15	REVISED
			4	04/20/15	UPDATED WITH API RP 14C DESIGNATIONS
		VANSON DWG NO. D-7075 JOB NO. 2691-06	3	05/01/12	UPDATED PER FIELD VERIFICATION WORK
			2	10/31/11	UPDATED POST-PHA
			1	03/04/11	UPDATED PER OPERATOR REDLINES
		PROCESSES UNLIMITED DWG NO. E-H-1383 REV. 9	0	09/15/06	AS-BUILT
NUMBER	REFERENCE DRAWINGS		REV. NO.	DATE	REVISED