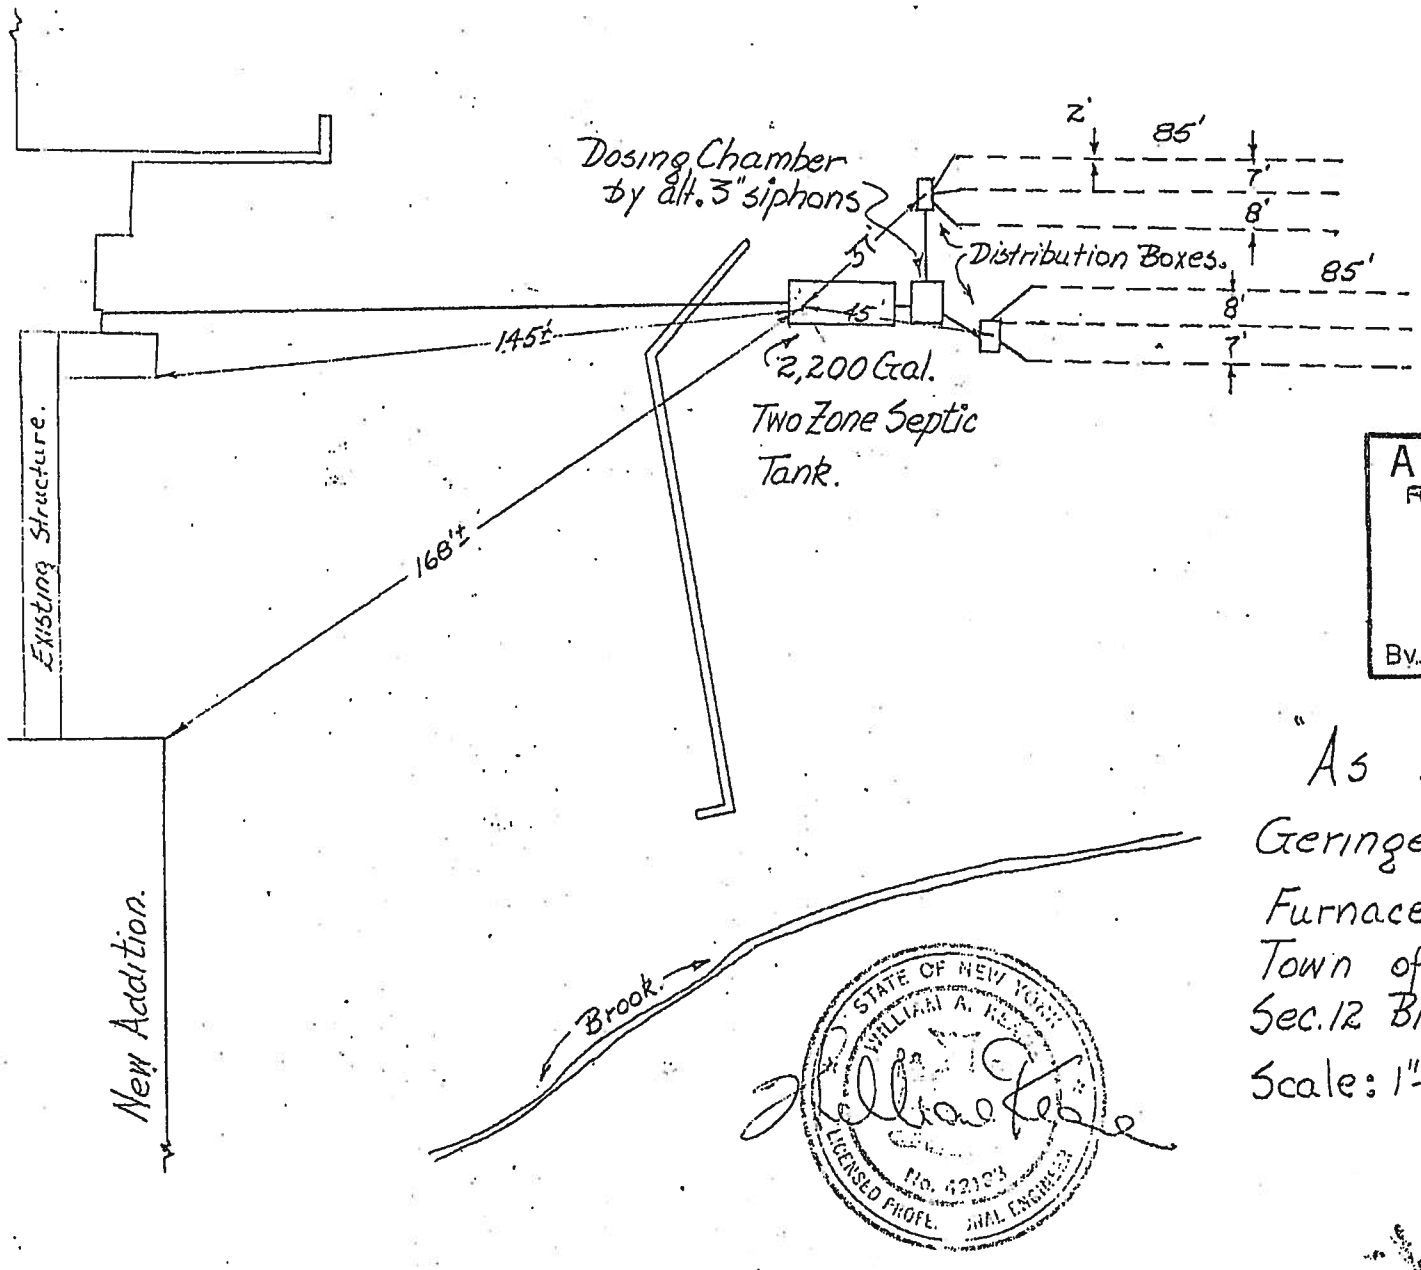

APPROVED
~~FOR CONSTRUCTION~~
NOV 28 1967
West. Co. Dept.
of Health
By V. Violin

"As Built"
Geringer & Sons Mfg. Corp.
Furnace Dock Rd.
Town of Cortlandt
Sec. 12 Blk. 1 Lot 11.
Scale: 1" = 40' C.K. & Assc.

STATE OF NEW YORK
WILLIAM A. KEBLE
No. 42123
LICENSED PROFESSIONAL ENGINEER

BCLP00023