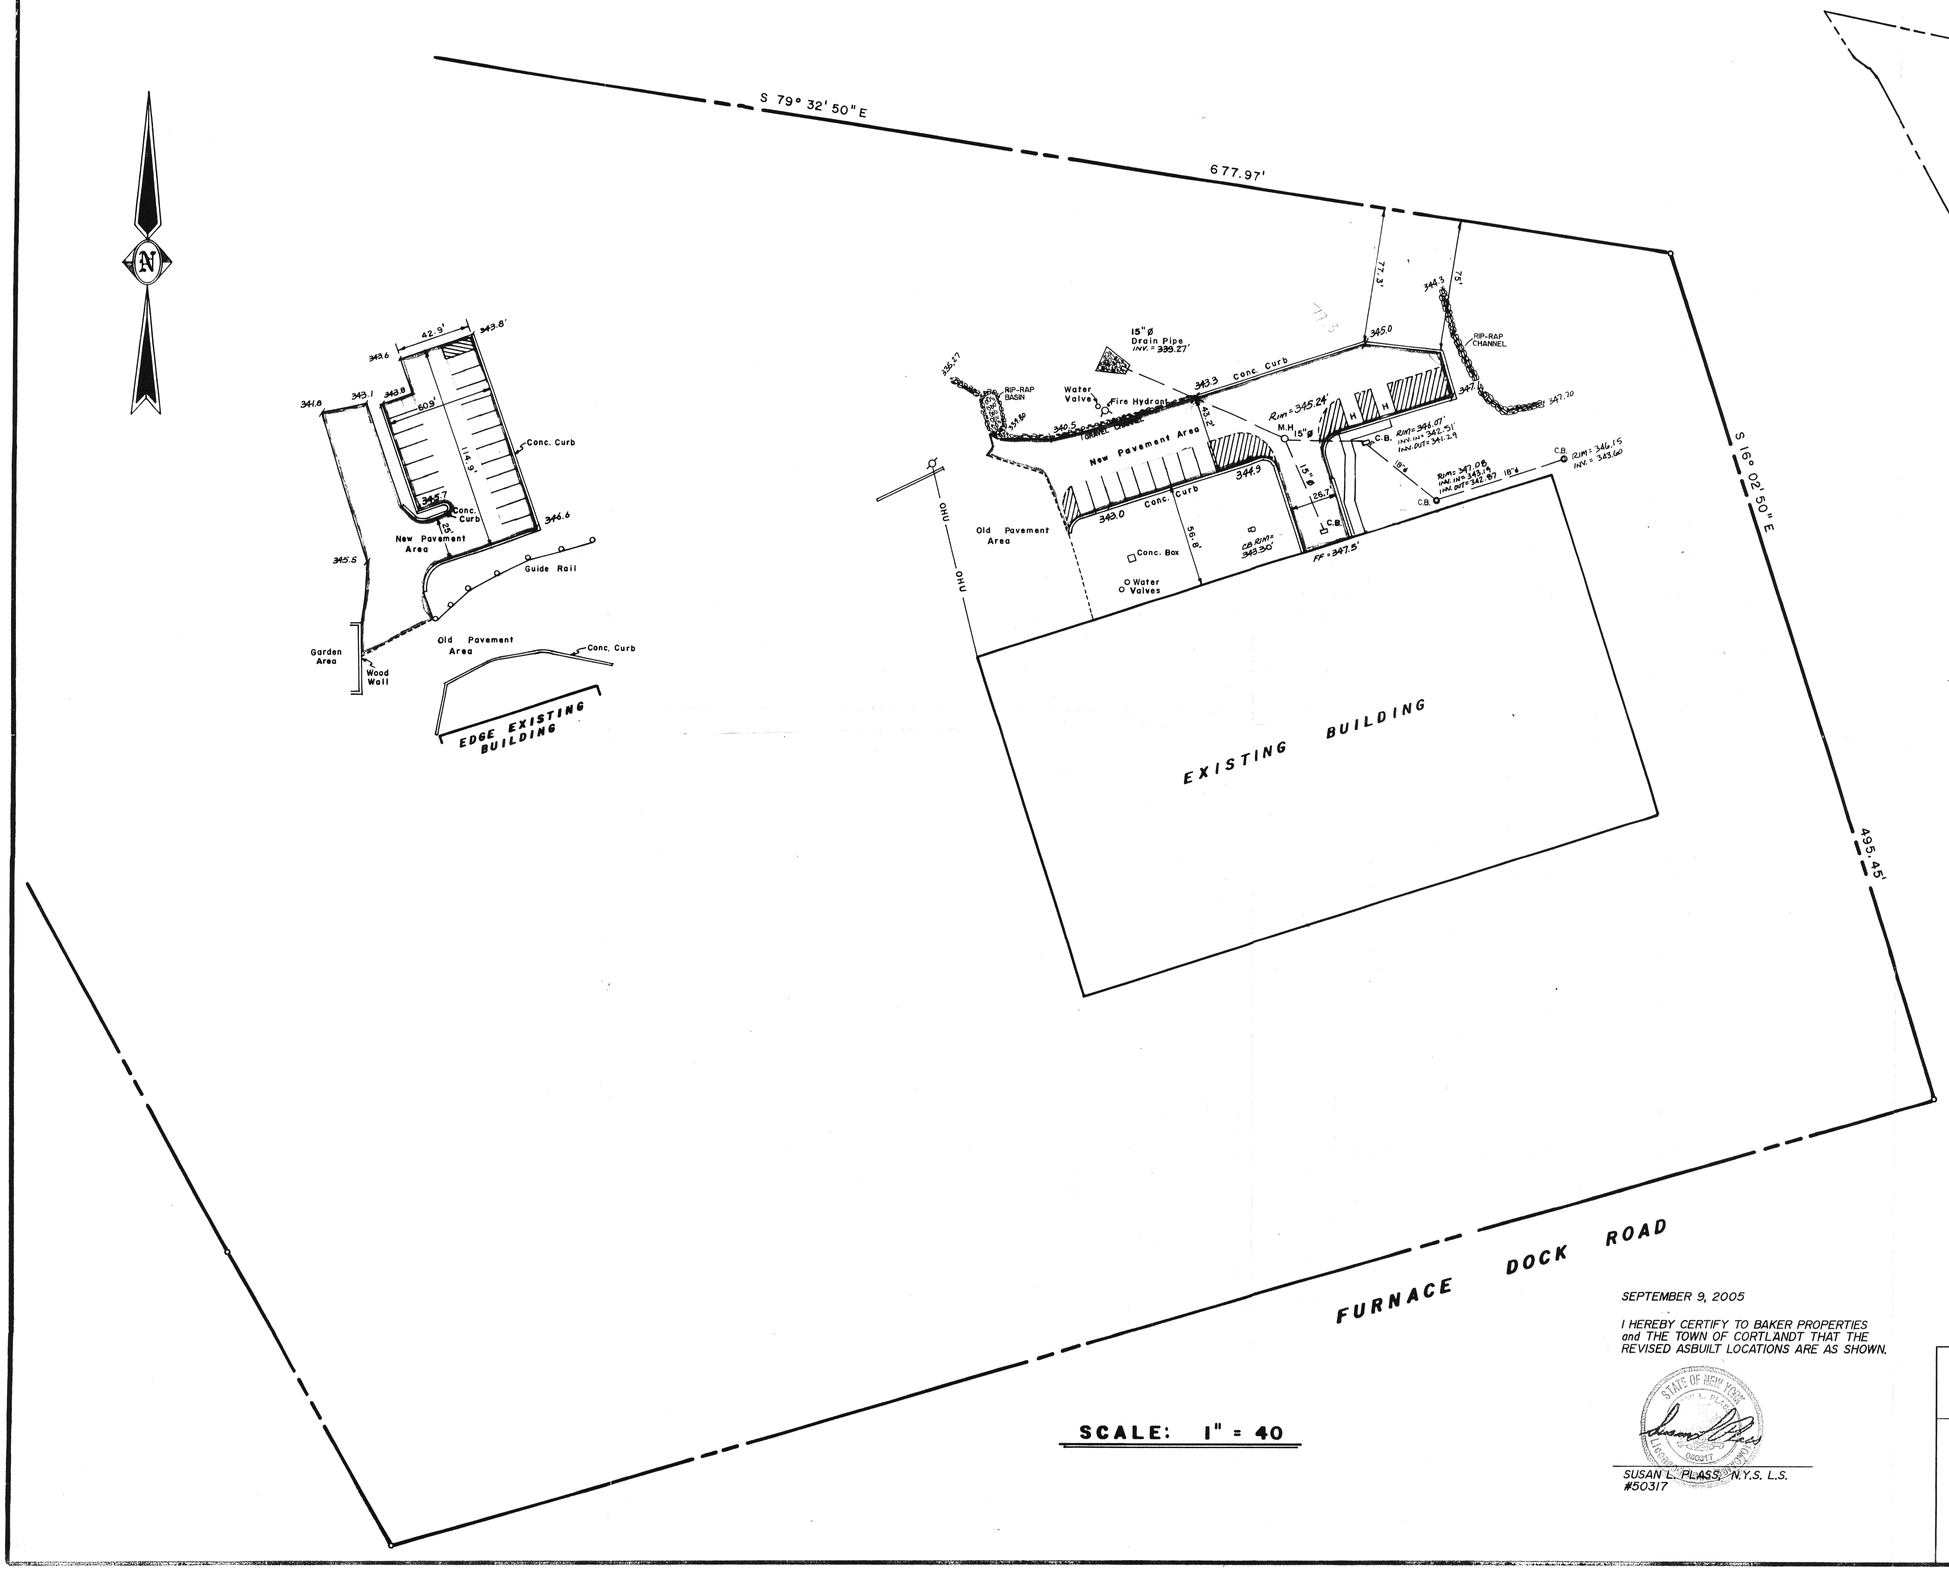

SCALE: 1" = 40

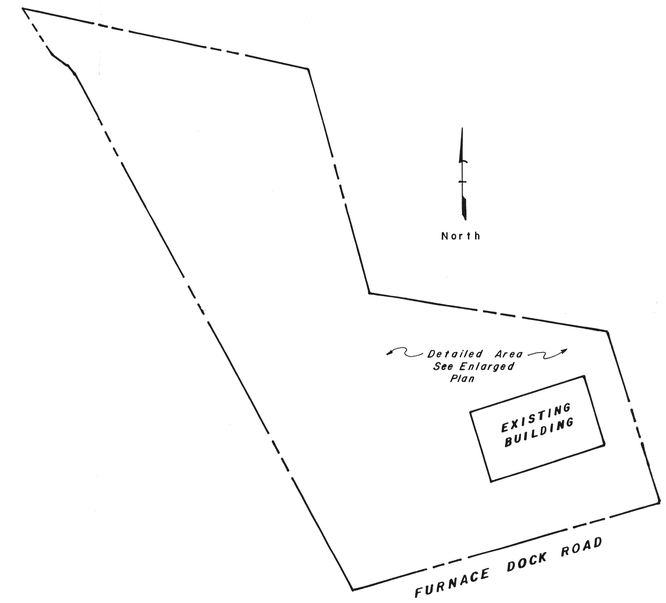

KEY MAP

SCALE: 1" = 200'

NOTE:

SURVEY DATA SHOWN HEREON, SUPPLIED BY TRC RAYMOND KEYES ASSOCIATES, VERIFIED BY BUNNEY ASSOCIATES AND SUBSTANTIATED BY FIELD LOCATIONS.

SEPTEMBER 9, 2005

I HEREBY CERTIFY TO BAKER PROPERTIES and THE TOWN OF CORTLANDT THAT THE REVISED ASBUILT LOCATIONS ARE AS SHOWN.

STATE OF NEW YORK · SUSAN L. PLASS · LICENSED LAND SURVEYOR · 050317

SUSAN L. PLASS, N.Y.S. L.S.
#50317

#2603

LJC

LEO J. CARROLL, P.E., L.S.
& ASSOCIATES
83 Cemetery Rd, Middletown, NY 10940 (845) 343-7994

ASBUILT
of
PARKING IMPROVEMENTS

Located at:
534 Furnace Dock Road
Town of Cortlandt,
Westchester County, New York

REVISED:	9-9-05
SCALE:	As Noted
DATE:	9-27-02
DRAWN:	K.J.L.
CHECKED:	S.L.P.
SHEET NO.	1 OF 1

BCLR00038