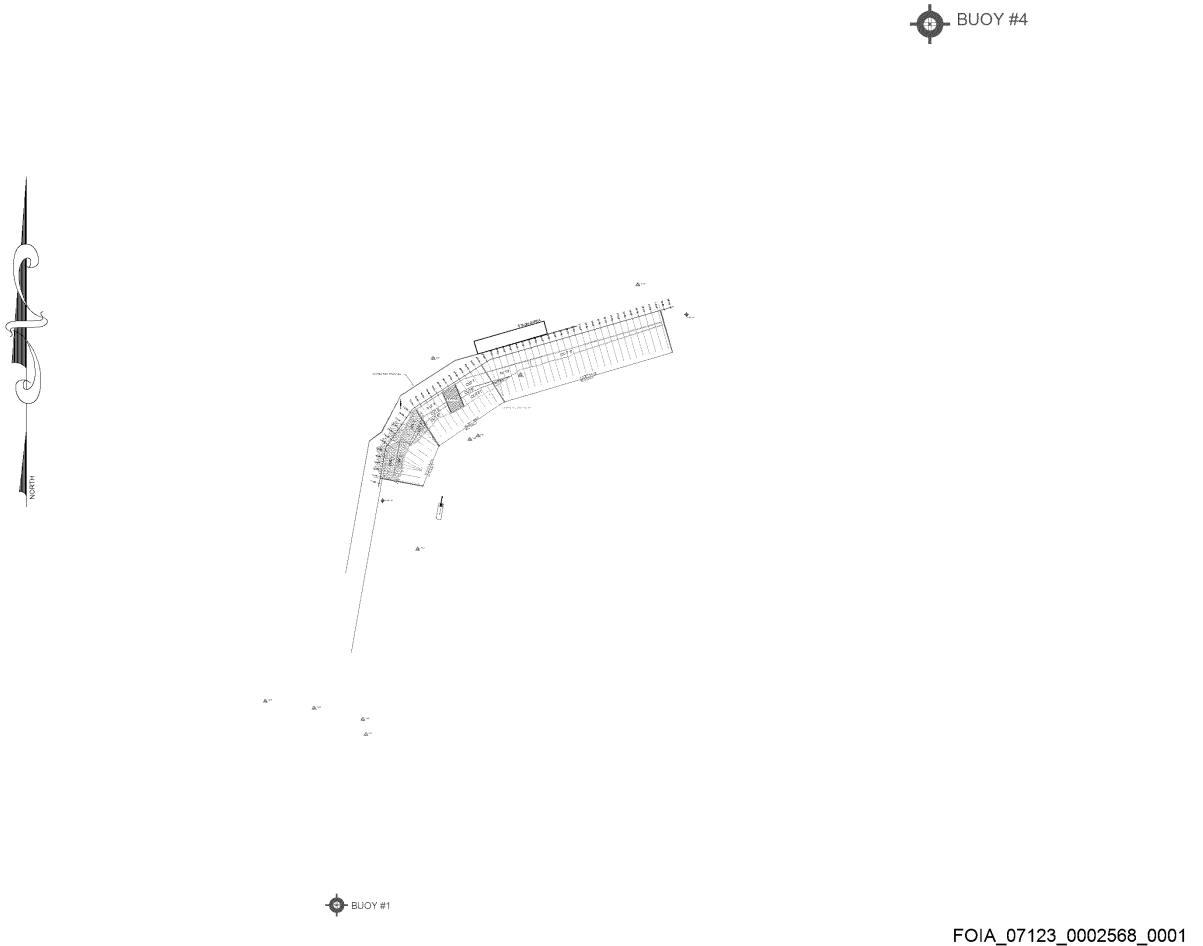
NORTH
BUOY #4
BUOY #1

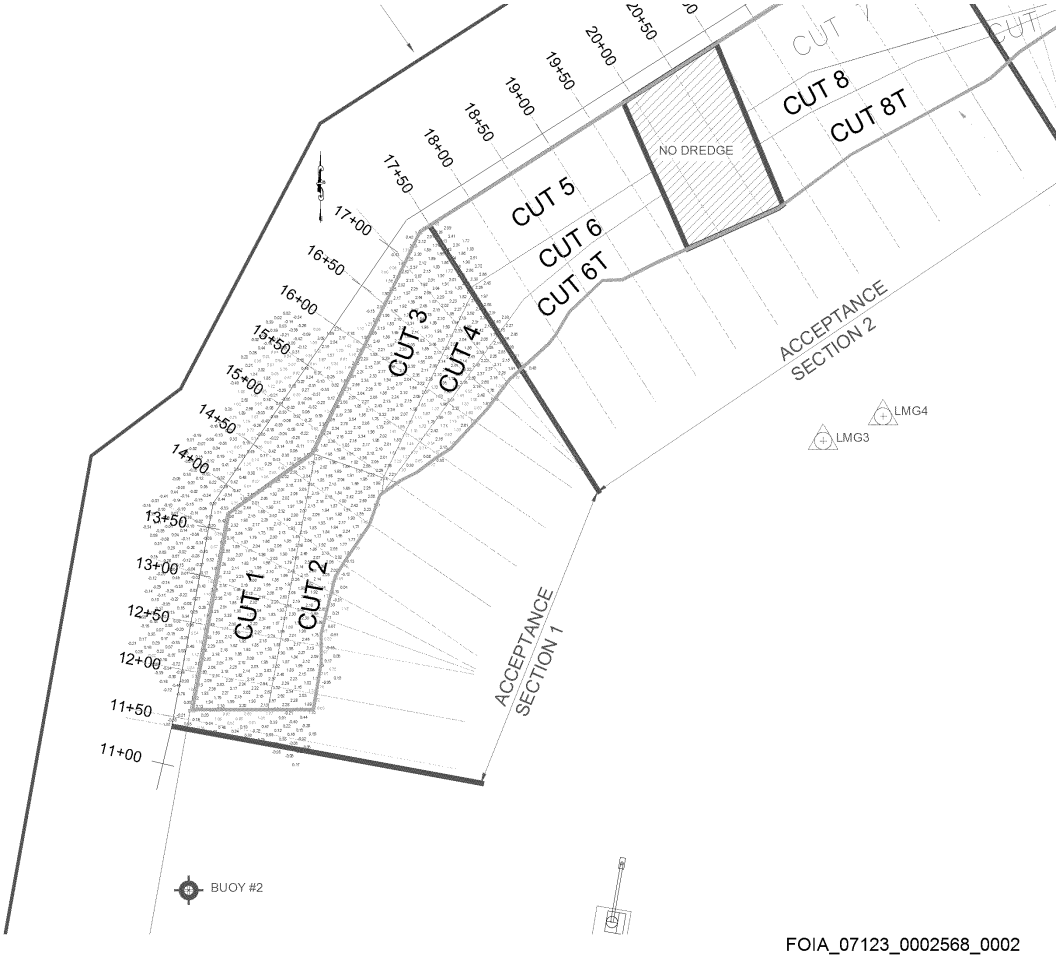
CUT 1
CUT 2
CUT 3
CUT 4
CUT 5
CUT 6
CUT 6T
CUT 8
CUT 8T
NO DREDGE
ACCEPTANCE SECTION 1
ACCEPTANCE SECTION 2
LMG3
LMG4
BUOY #2
11+00
11+50
12+00
12+50
13+00
13+50
14+00
14+50
15+00
15+50
16+00
16+50
17+00
17+50
18+00
18+50
19+00
19+50
20+00
20+50

11+50
12+00
12+50
13+00
13+50
14+00
14+50
15+00
15+50
16+00
16+50
17+00
17+50
CUT 1
CUT 2
CUT 3
CUT 4
GRAPHIC SCALE
(IN FEET)
1 inch = ft.
BD-CND DIFF
< -0.49'
0.50'-0.99'
1.00'-1.24'
1.25'-1.49'
1.50'-1.74'
1.75'-2.00'
>= 2.24'
GREAT LAKES DREDGE AND DOCK COMPANY, LLC
LOWER PASSAIC RIVER, NJ
STUDY AREA PROJECT, RIVER MILE 10.9
AS-CONSTRUCTED DIFFERENCE MAP
01