Figure 5

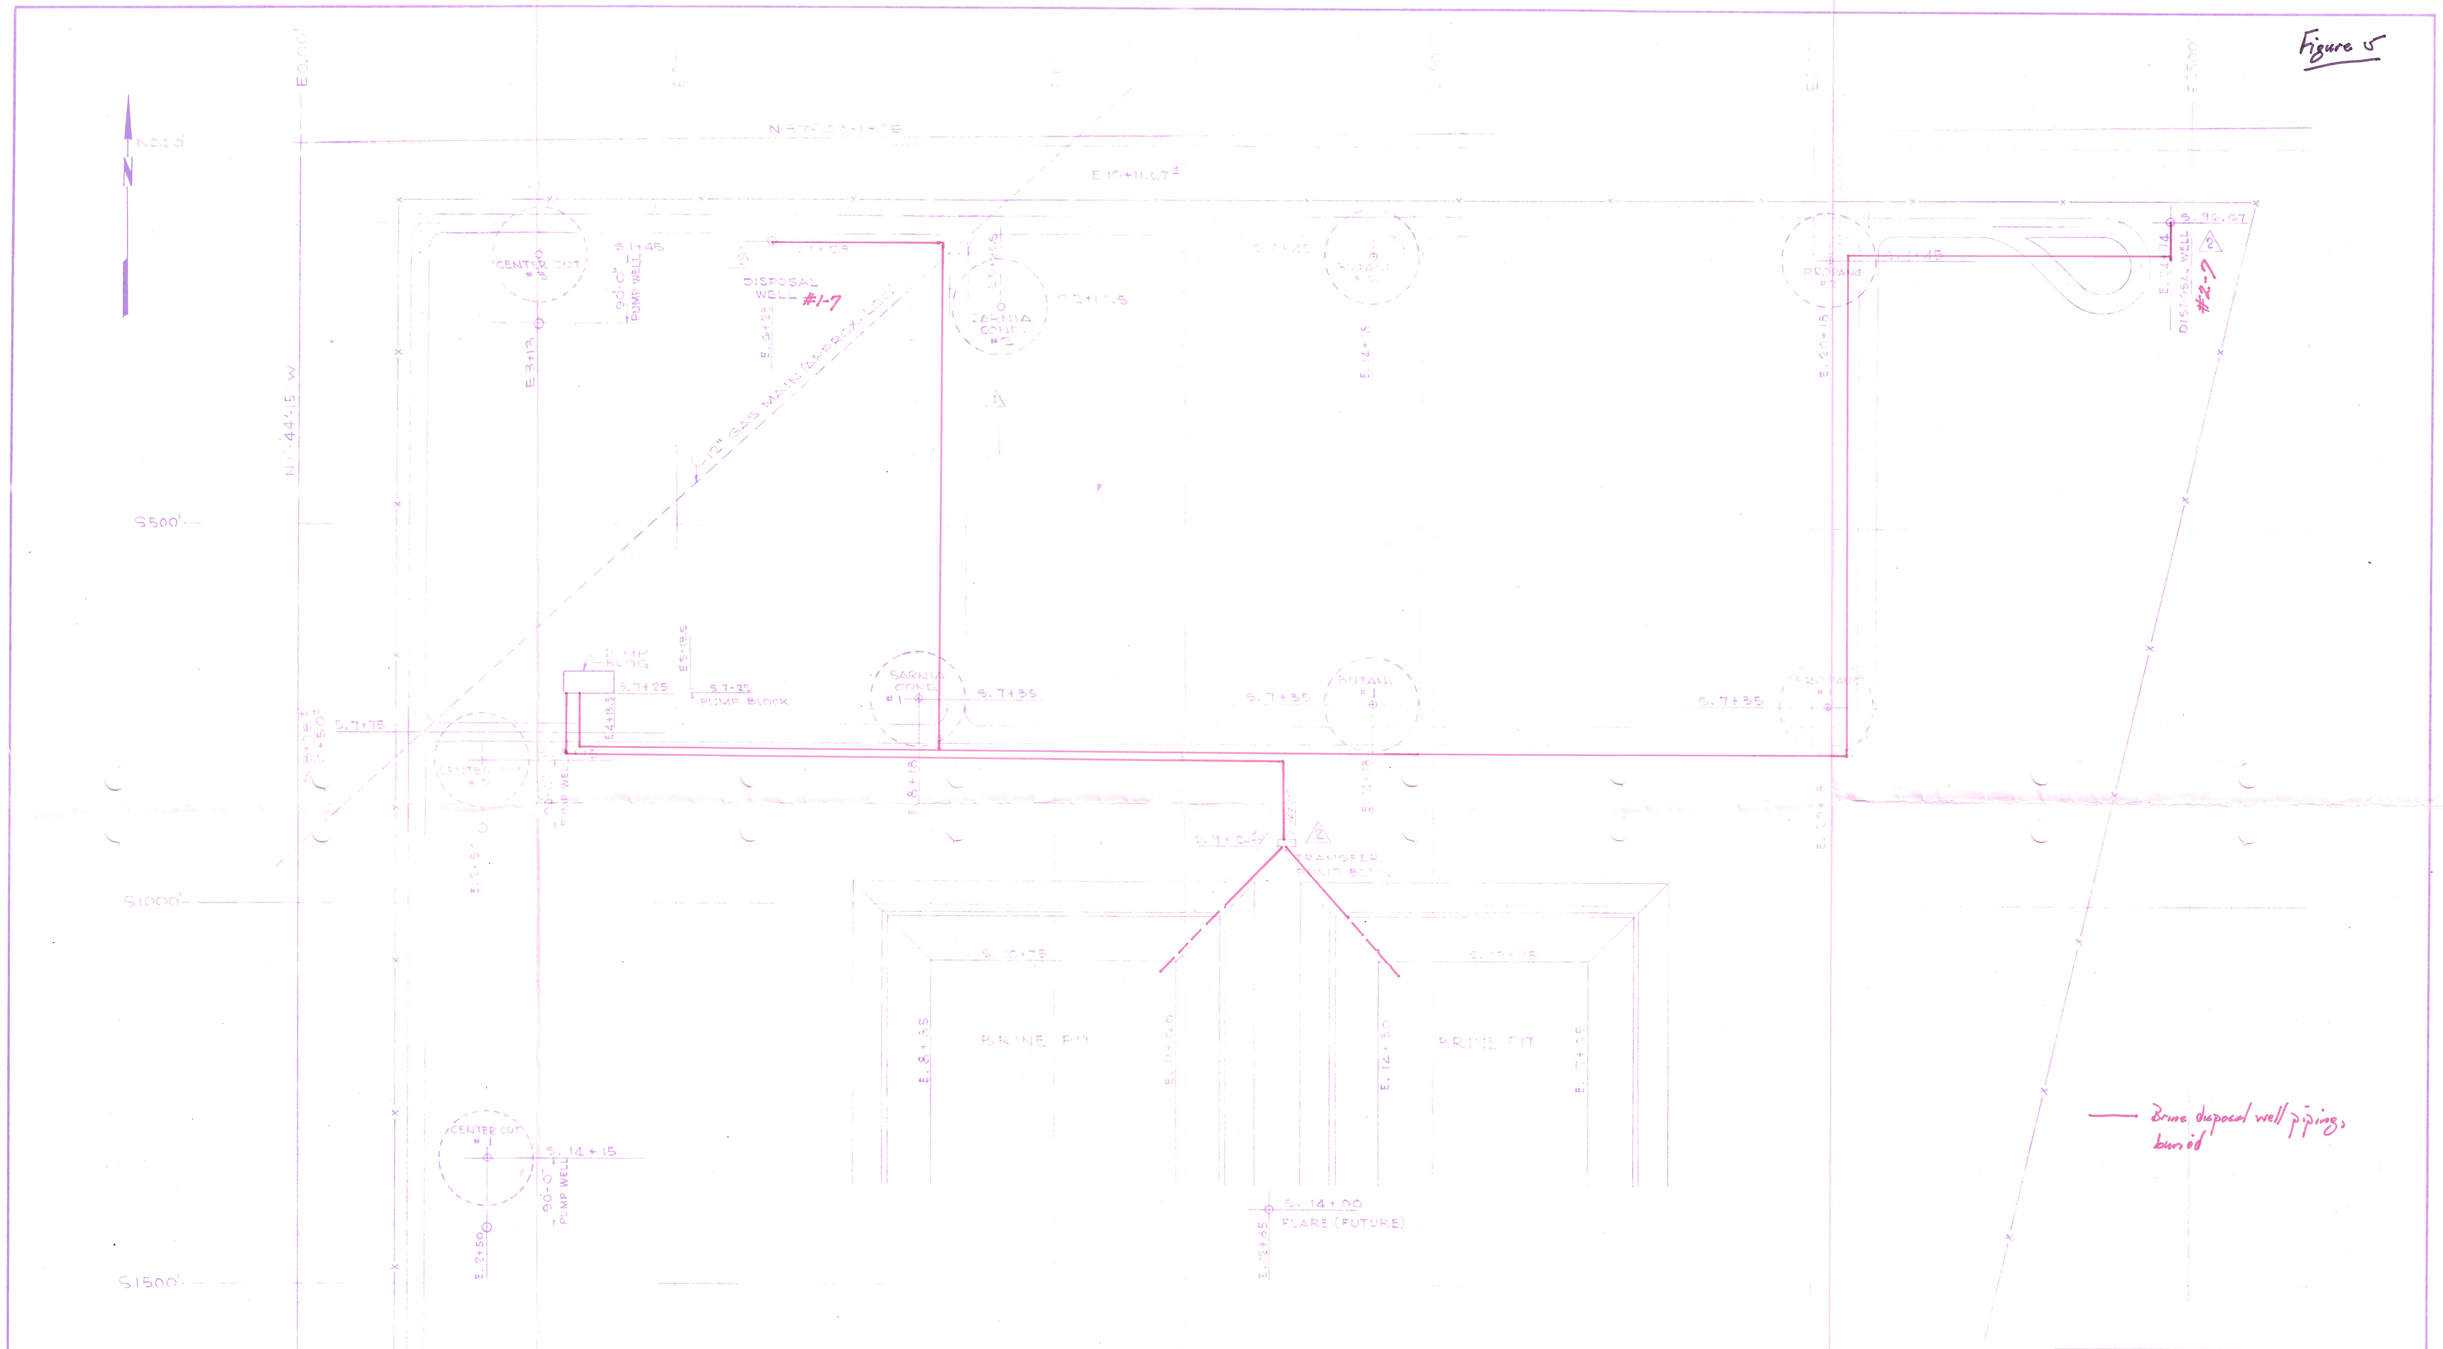

AS-BUILT

REV. NO.	DATE	DESCRIPTION	BY
3	4-12-72	AS BUILT	C.C.
2	9-14-71	SHEET TRANSF. PUMP BLDG - ADDED CO-ORD. RELOCATED DISP. WELLS	R.G.
1	9-8-71	RELOCATED SARNIA COND #2	R.G.

PREPARED BY
FENIX & SCISSON, INC.
ENGINEERS & CONTRACTORS
TULSA, OKLAHOMA

FOR
CONSUMERS POWER COMPANY
MARYSVILLE MICHIGAN

PLOT PLAN

DRAWN	DATE	JOB NO.
JACK DAY	JULY, 1971	200
CHECKED	SCALE	DRAWING NO.
KERMIT ALLEN	1" = 100'	200-3-1

24X36 PRINTED ON RIDEWAY'S NO. 1000-H