CITY OF ELMIRA, NEW YORK

HERITAGE PARK URBAN RENEWAL PROJECT
SITE IMPROVEMENTS CONTRACT No. 2 N.Y. R-174

EAST WATER STREET
STA. 18+00 TO STA. 23+00

NEWMAN & DOLL
WHITE PLAINS, N.Y. — NEW HAVEN, CONN.

Date: Jan. 1972
Scale: 1" = 20' Horiz. 1" = 4' Vert.
Sheet No. 6 of 36

STATE OF NEW YORK — HOWARD G. NEWMAN — No. PE 27493 — LICENSED PROFESSIONAL ENGINEER

AS-BUILT Sept. 1974

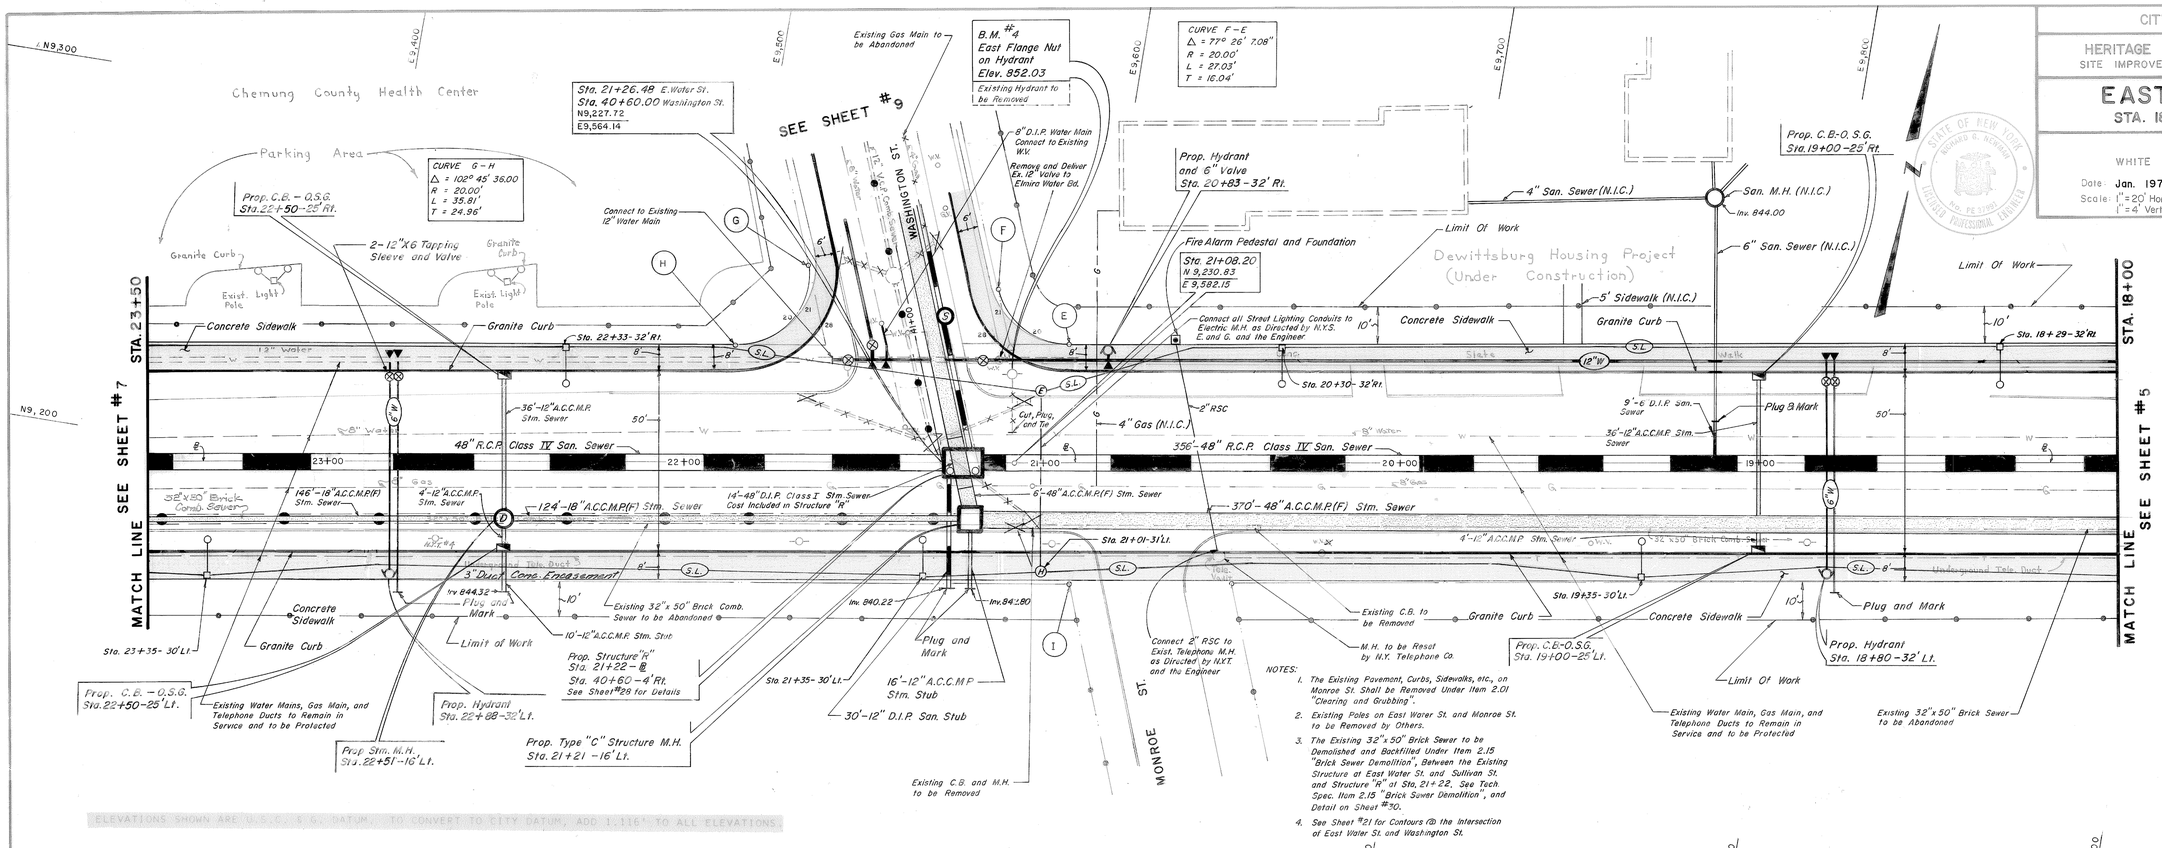

NOTES:

1. The Existing Pavement, Curbs, Sidewalks, etc., on Monroe St. Shall be Removed Under Item 2.01 "Clearing and Grubbing".
2. Existing Poles on East Water St. and Monroe St. to be Removed by Others.
3. The Existing 32"x50" Brick Sewer to be Demolished and Backfilled Under Item 2.15 "Brick Sewer Demolition", Between the Existing Structure at East Water St. and Sullivan St. and Structure "R" at Sta. 21+22. See Tech Spec. Item 2.15 "Brick Sewer Demolition", and Detail on Sheet #30.
4. See Sheet #21 for Contours @ the Intersection of East Water St. and Washington St.

ELEVATIONS SHOWN ARE U.S.C.&G. DATUM. TO CONVERT TO CITY DATUM, ADD 1.116' TO ALL ELEVATIONS.

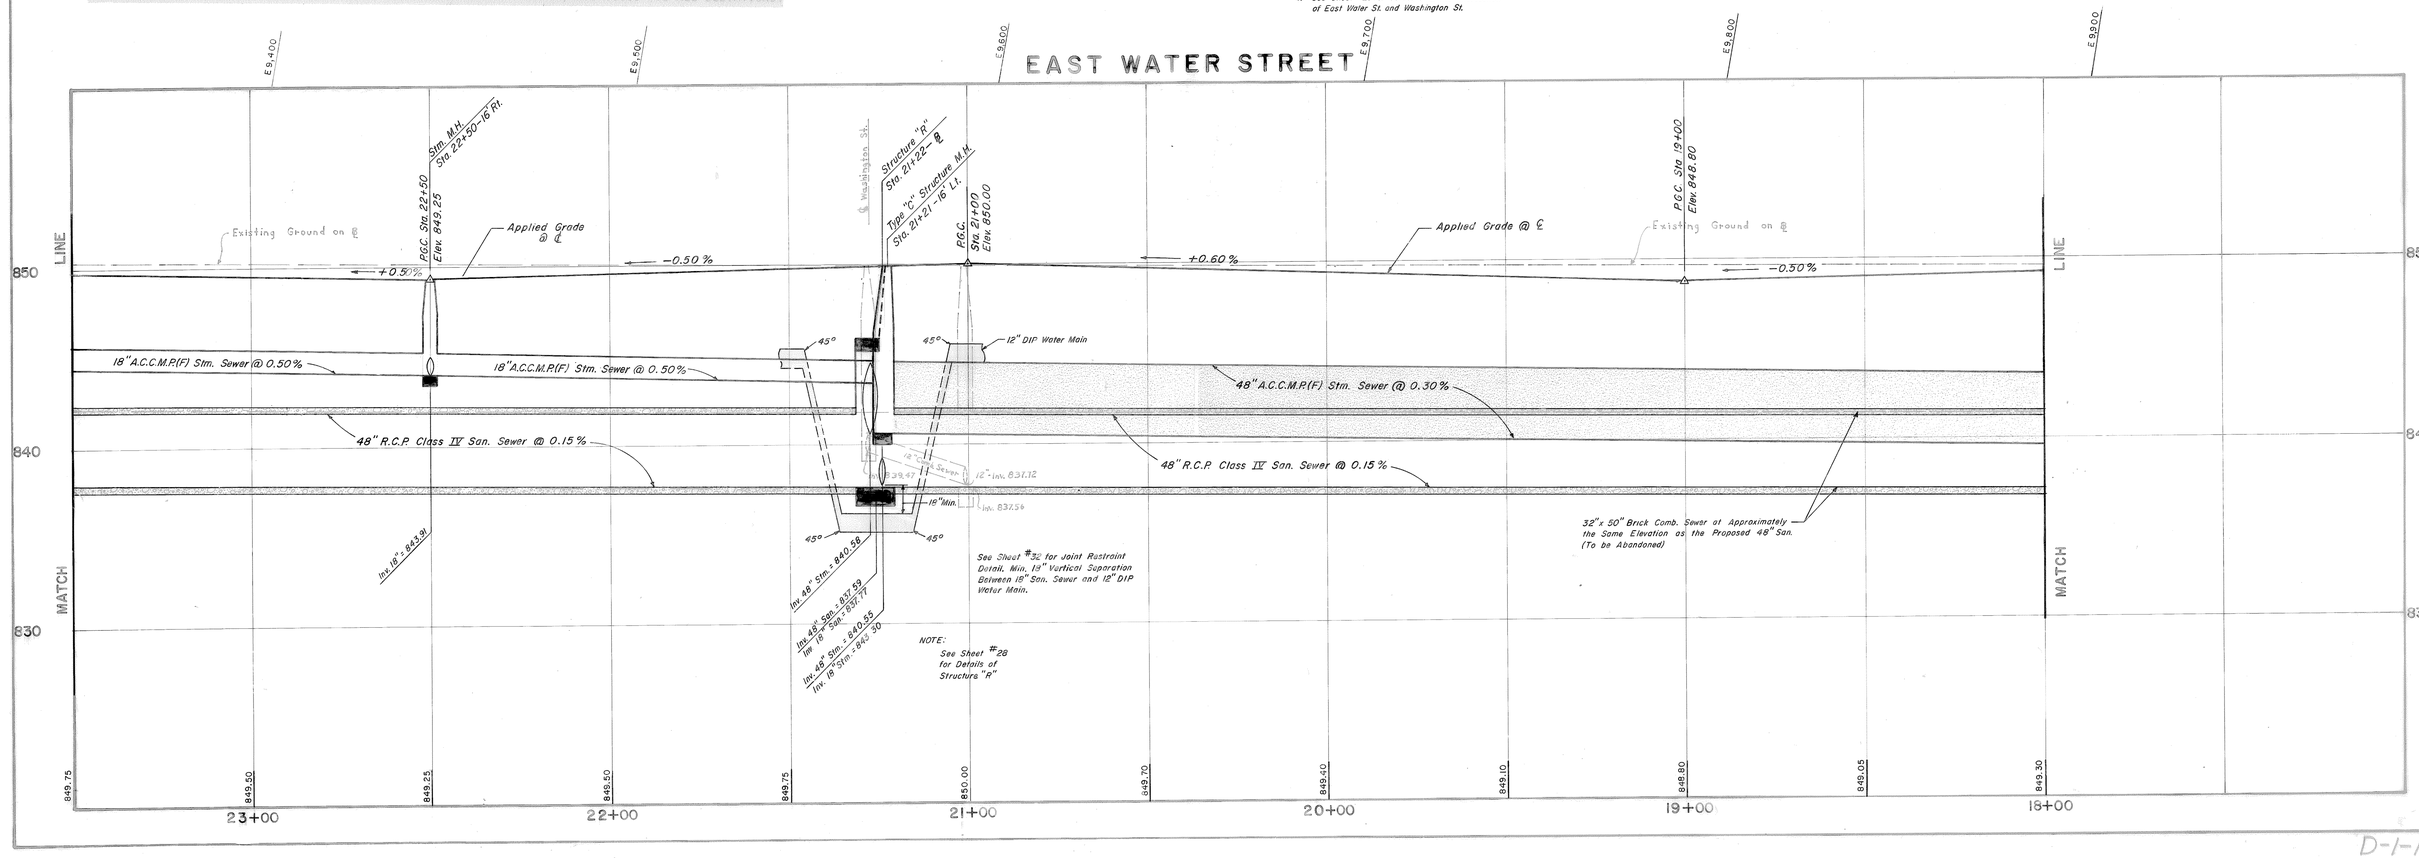

D-1-1905