19 1183 HERCULENE, A. & B. SMITH CO., PGH., PA. J10361-865

IPU-41111

Waste Hydrochloric Acid Injection Well
Hennepin Works
Jones & Laughlin Steel Corp.
RCRA I.D. No. _____

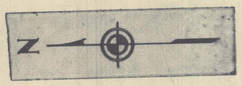

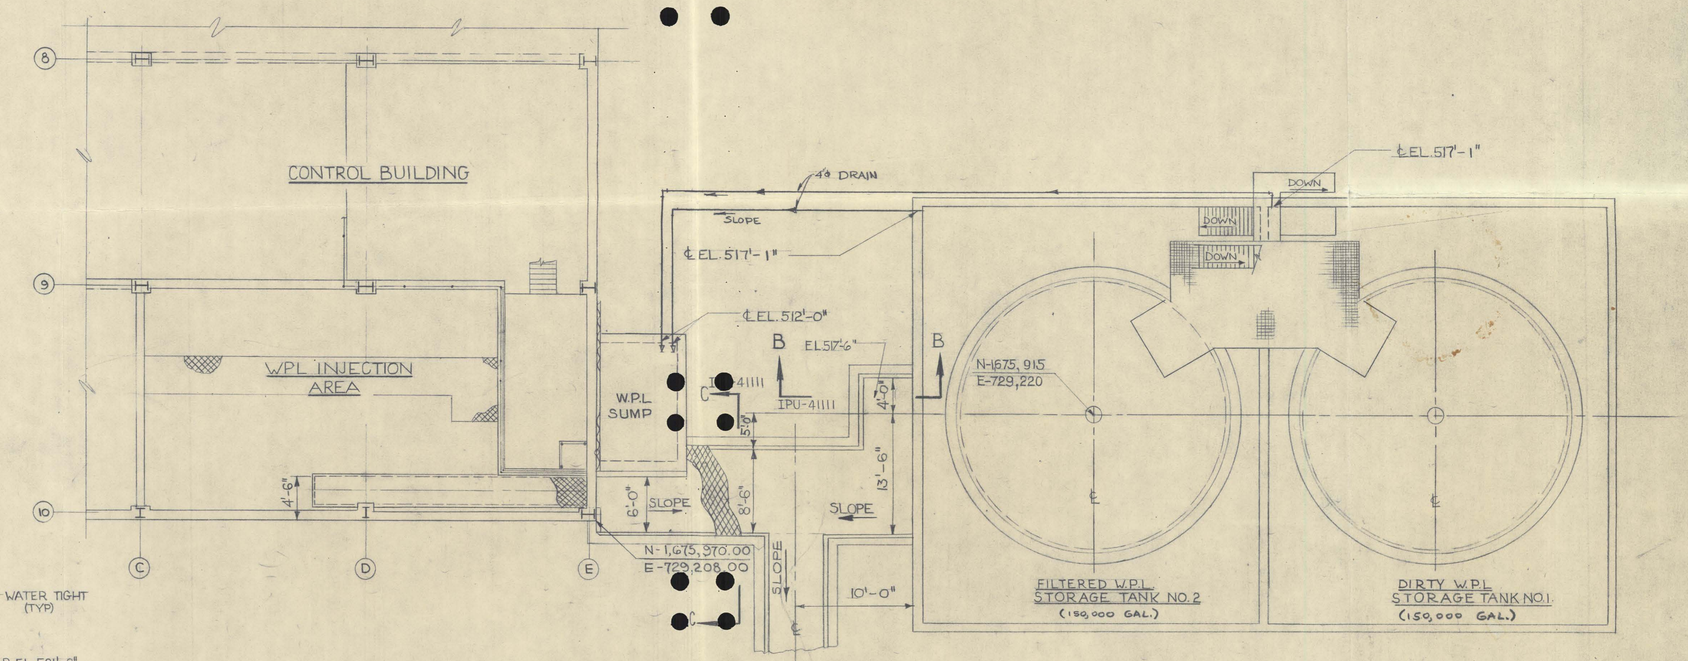

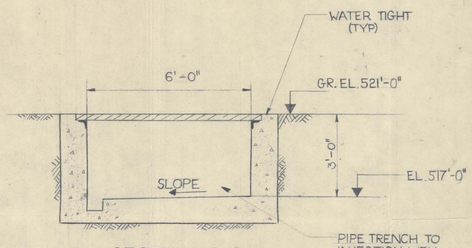

SECTION A-A
SCALE 3/8" = 1'-0"

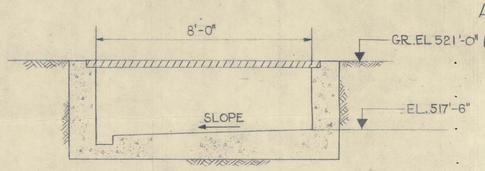

SECTION C-C
SCALE 3/8" = 1'-0"

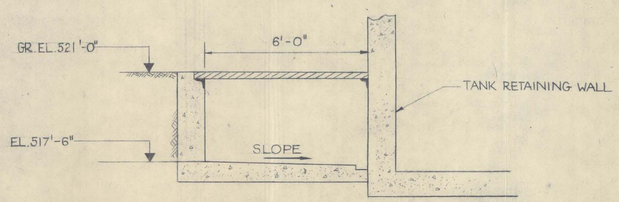

SECTION B-B
SCALE 3/8" = 1'-0"

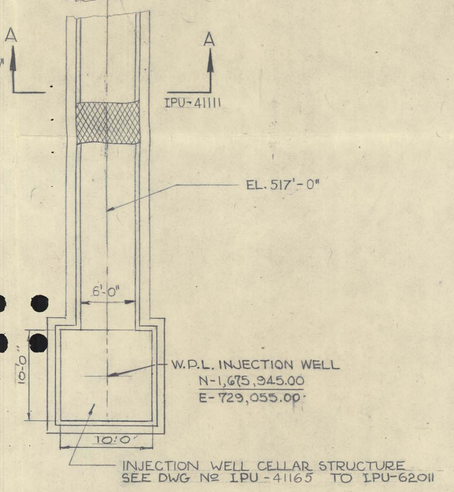

NOTE

1. FOR PIPING ARRG'T OF WPL STORAGE TANKS SEE DWGS Nº IPU-41108 TO IPU-41110
2. FOR PIPING ARRG'T OF WPL DISPOSAL TRENCH SEE DWG Nº IPU-41115
3. FOR PIPING ARRG'T OF WPL SUMP & PUMP PIT SEE DWG Nº IPU-41112 & IPU-41113

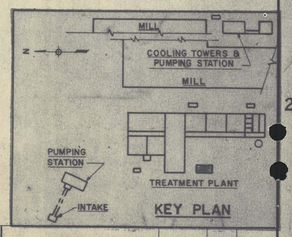

THIS DRAWING WAS FORMERLY DWG. No. IPU - 61226

REV	*	DATE	CHK. BY	REVISIONS	CHARGE ACCOUNT	IMP. FILE	SHEET	E-ORD.
4								
3	1	2-19-68	MHR	AS BUILT				
2		6-30-66	[illegible]					
1	–	6-6-66	J.T.					
ORIG	–	5-15-66	J.T.					

ORDERING DATA

HYDROTECHNIC RELEASE

	0	1	2	3	4	5	6	7
STRUCT. DEPT.								
MECH. DEPT.								
ELECT. DEPT.								
CIVIL DEPT.								
DATE								

HYDROTECHNIC CORPORATION
ENGINEERS
NEW YORK, N.Y. ■ HINSDALE, ILL. □

JONES & LAUGHLIN STEEL CORPORATION
PITTSBURGH, PA.
HENNEPIN WORKS DIVISION
PLANT UTILITIES
MECHANICAL
CONTROL BUILDING
W.P.L. DISPOSAL TRENCH ARRANGEMENT

SCALE 1/8" = 1'-0" DATE 5-15-66 DR. J.D. TR. CK.
APPROVED
IPU-41111

* DENOTES NUMBER OF PLACES REVISION SYMBOL APPEARS

2-178