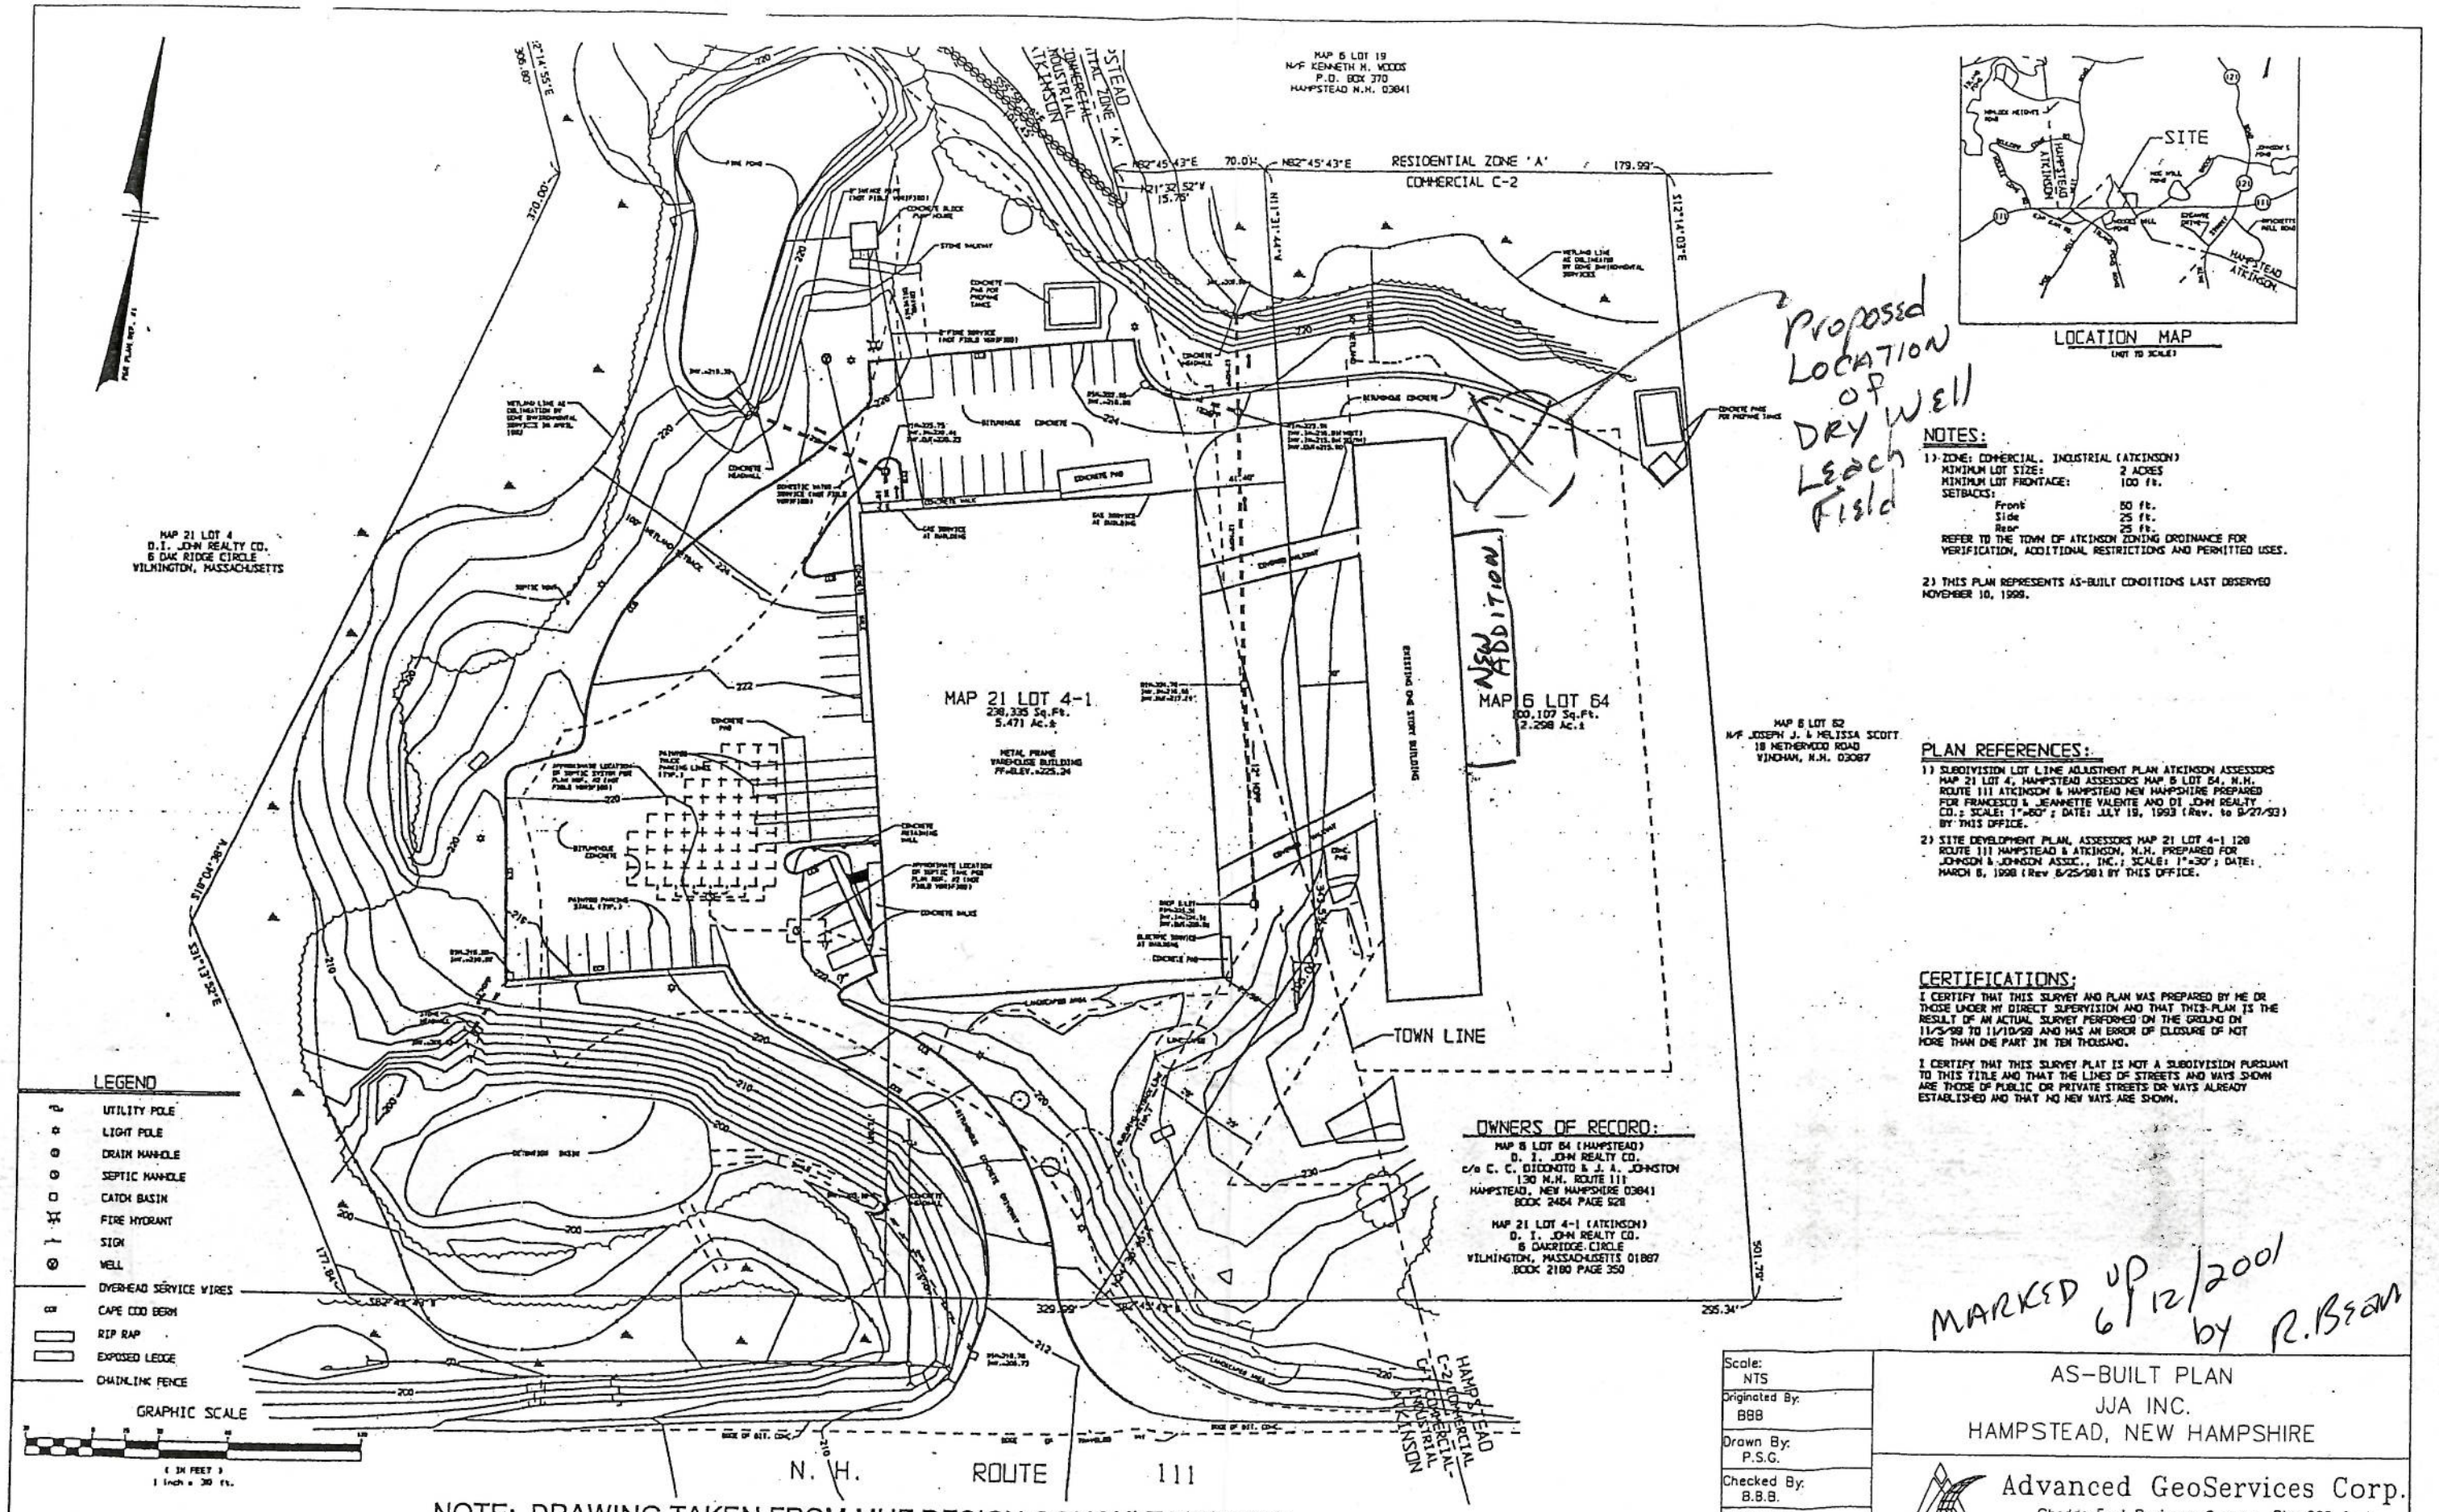

NOTE: DRAWING TAKEN FROM MHF DESIGN CONSULTANTS INC.
AS BUILT PLAN DATED FEBRUARY 9, 2000

J:\GOULD\DRAWINGS\2000-683-00\2000-683-00-04

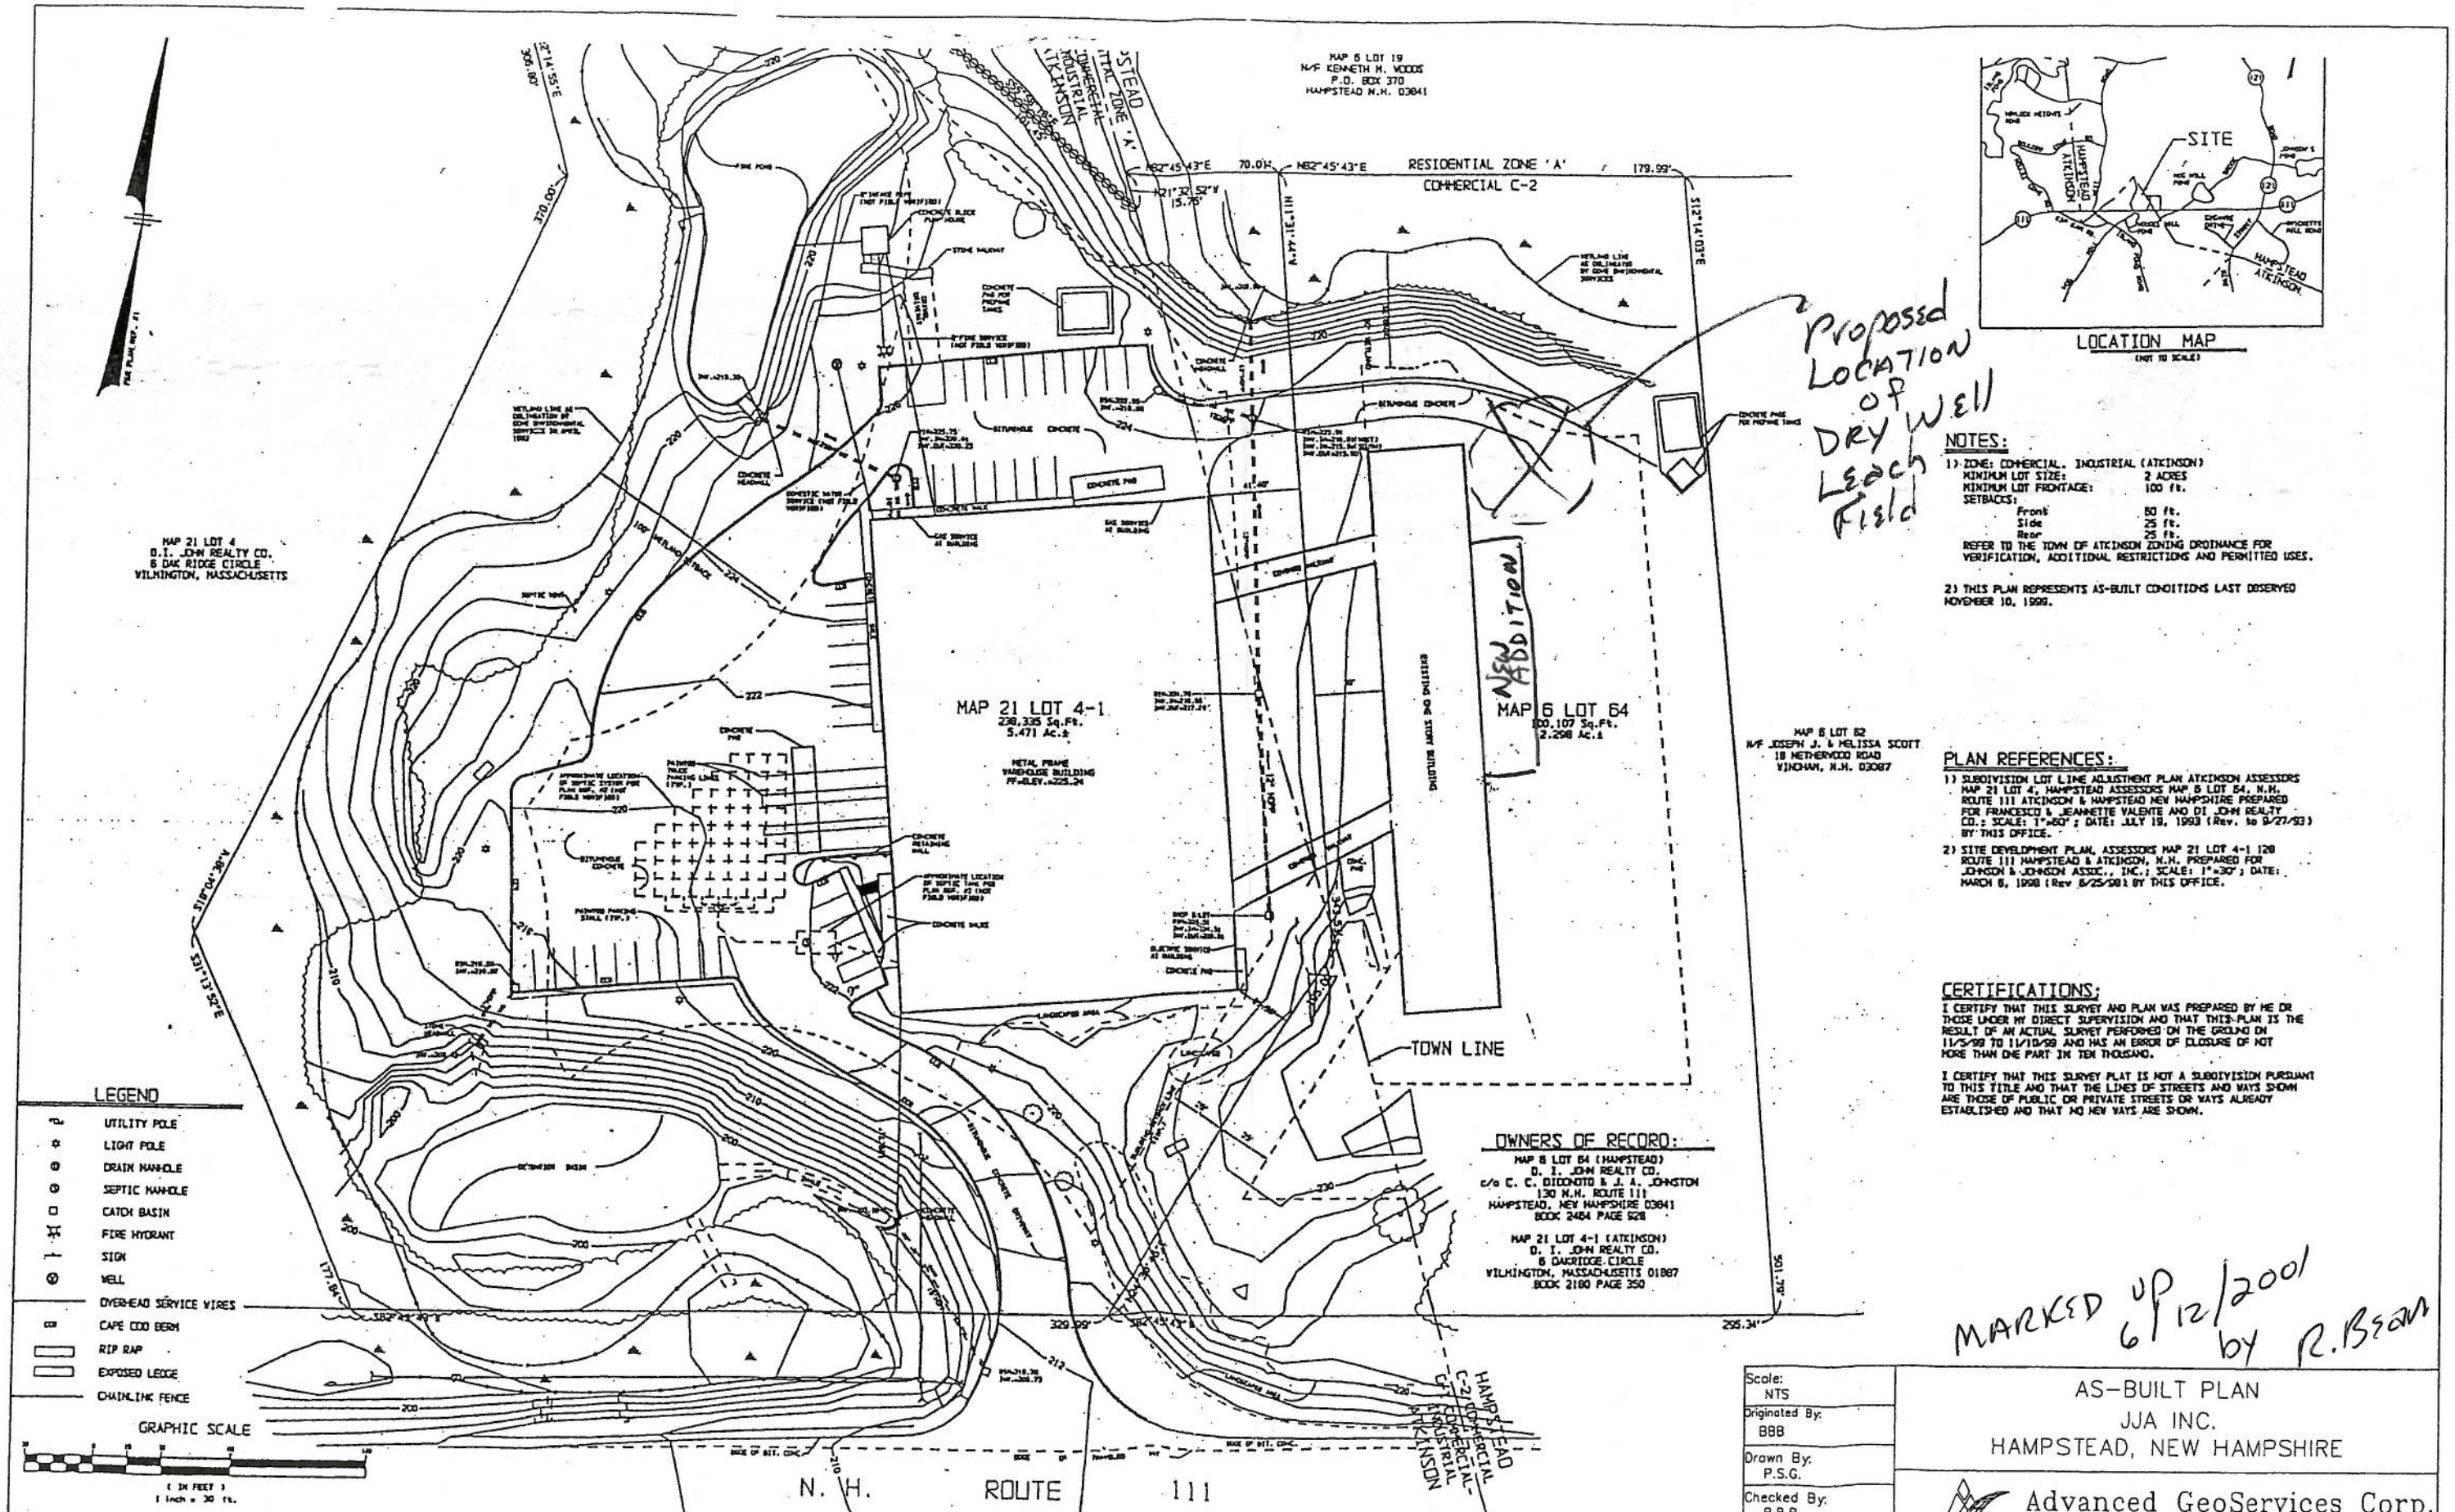

NOTE: DRAWING TAKEN FROM MHF DESIGN CONSULTANTS INC.
AS BUILT PLAN DATED FEBRUARY 9, 2000

J:\GOULD\DRAWINGS\2000-683-00\2000-683-00-04

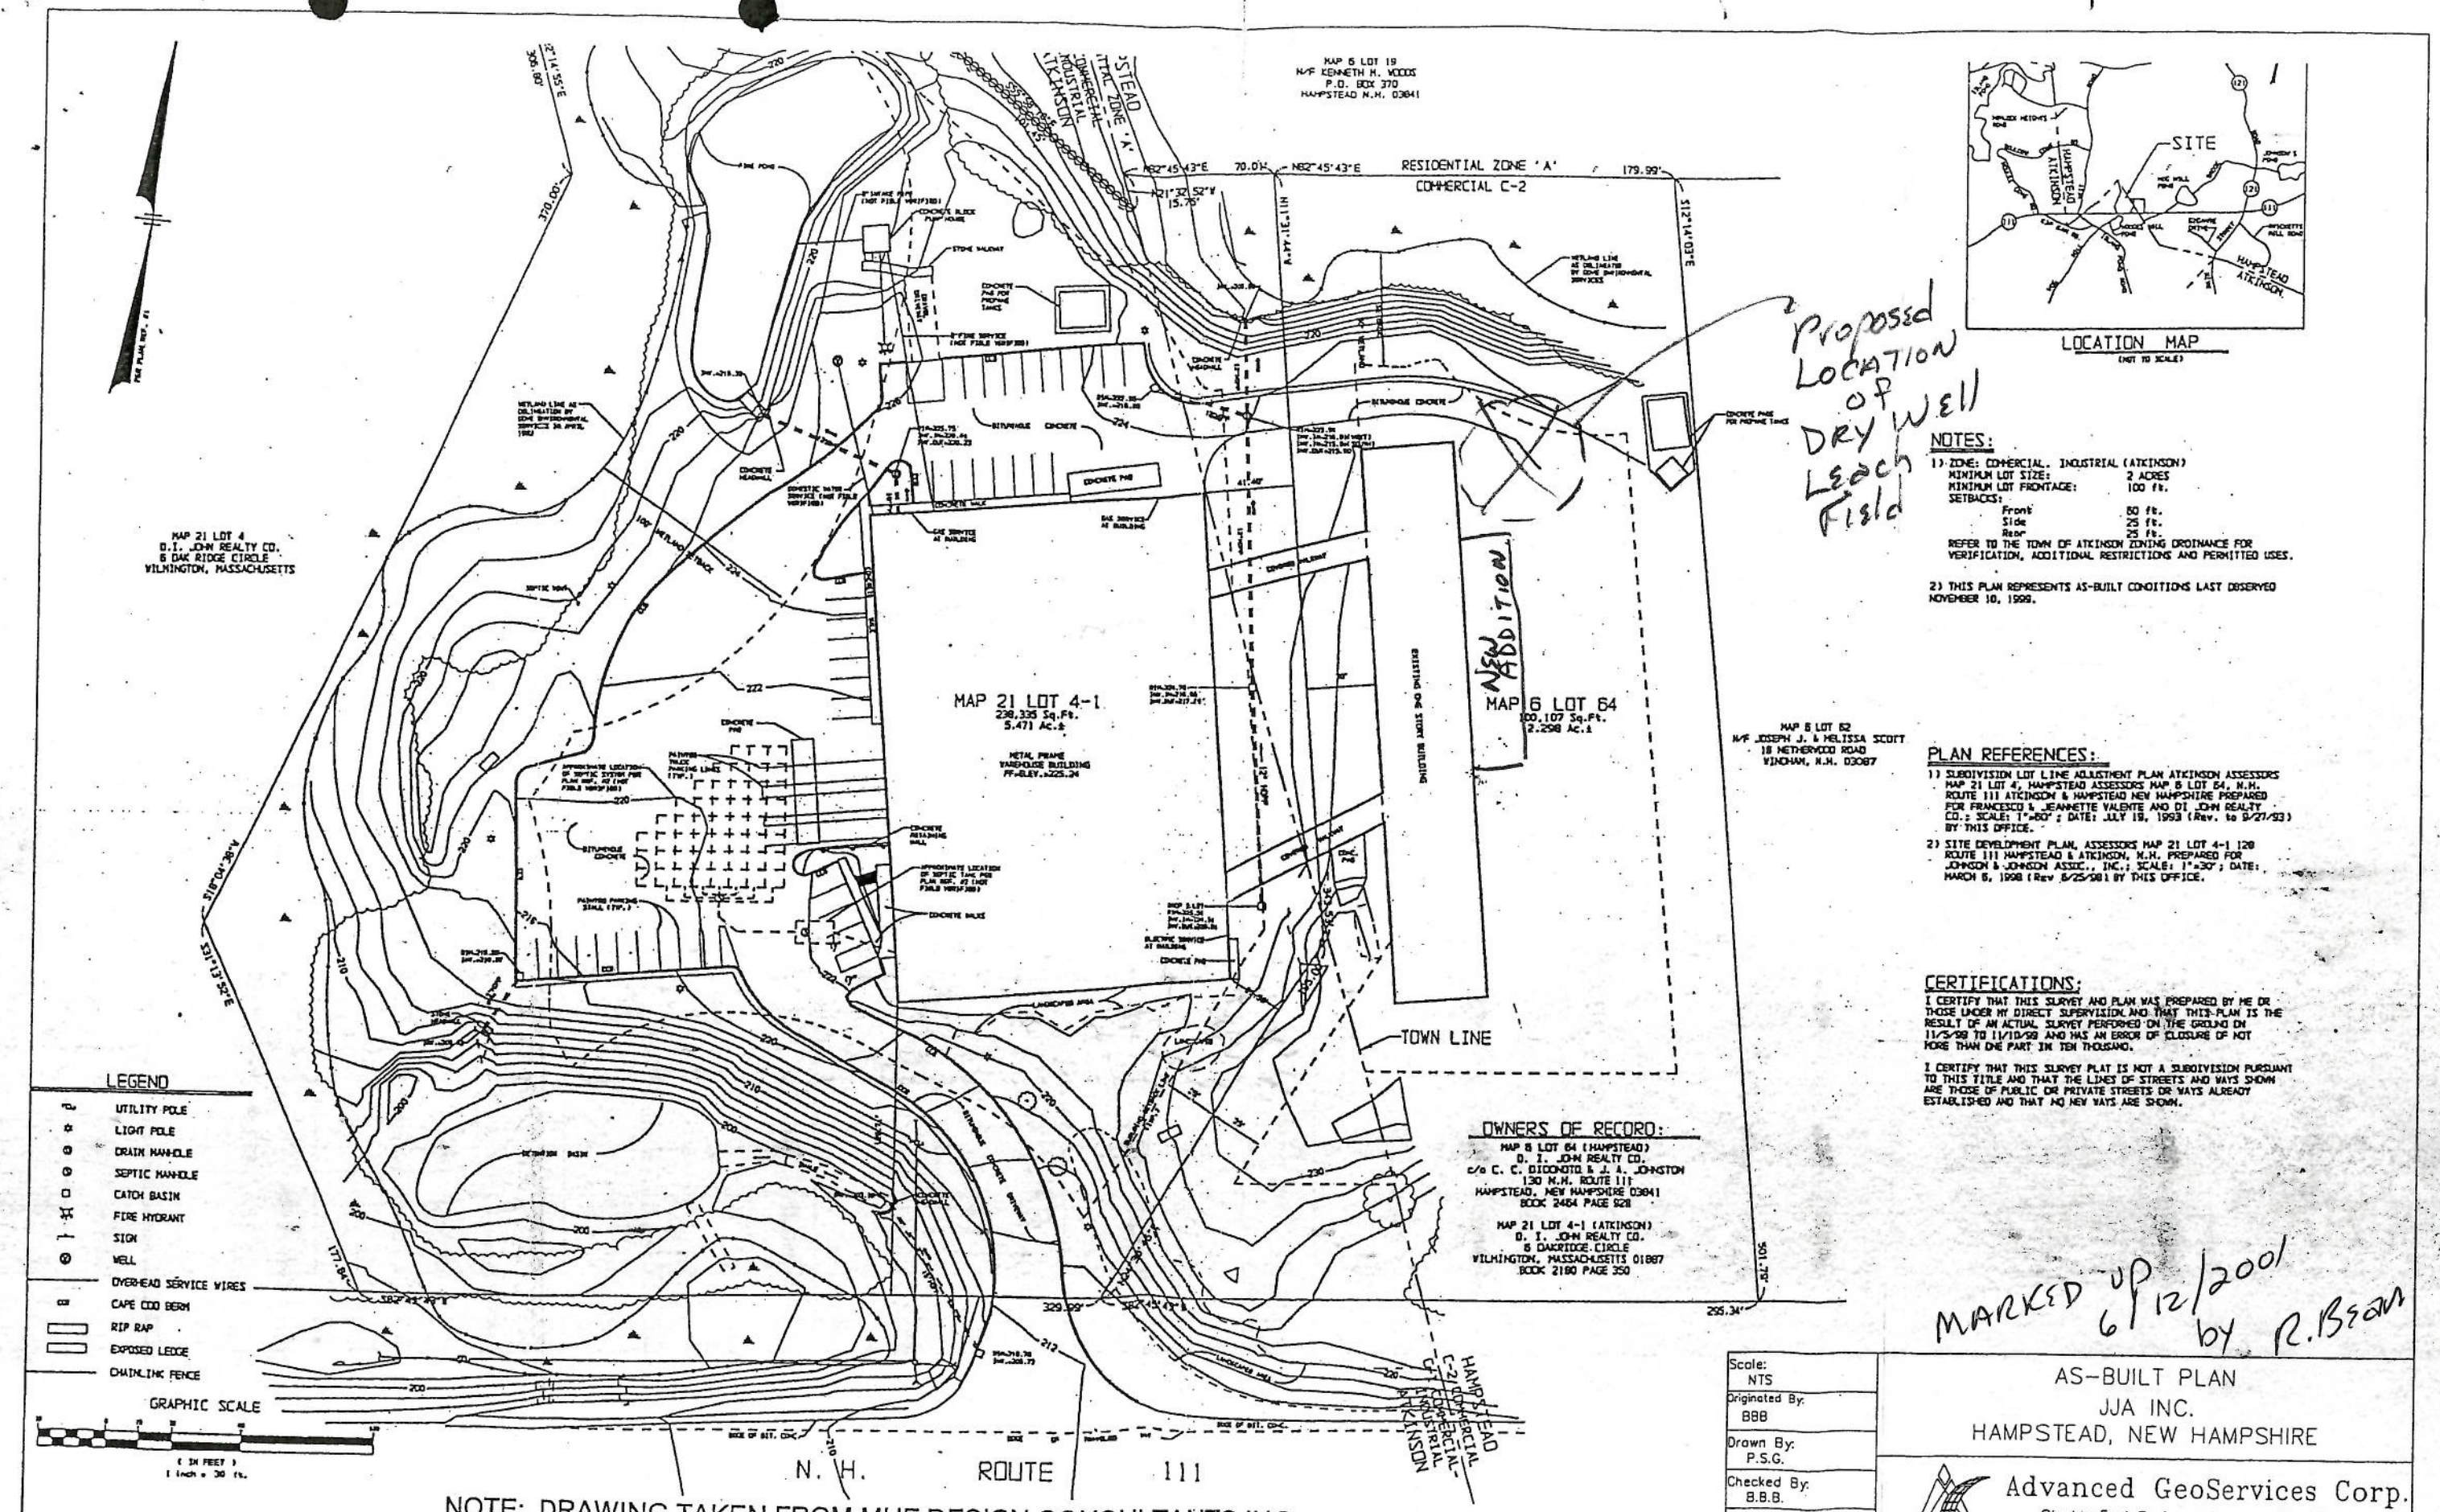

NOTE: DRAWING TAKEN FROM MHF DESIGN CONSULTANTS INC.
AS BUILT PLAN DATED FEBRUARY 9, 2000

Scale: NTS	AS-BUILT PLAN JJA INC. HAMPSTEAD, NEW HAMPSHIRE
Originated By: BBB	
Drawn By: P.S.G.	
Checked By: B.B.B.	Advanced GeoServices Corp. Chadds Ford Business Campus, Rts. 202 & 1 Brandywine One, Suite 202 Chadds Ford, Pennsylvania 19317
Project Mgr: B.L.F.	
Dwg No. 2000-683-00-04	Project No. 2000-683-00
Issued:	FIGURE 1

J:\GOULD\DRAWINGS\2000-683-00\2000-683-00-04