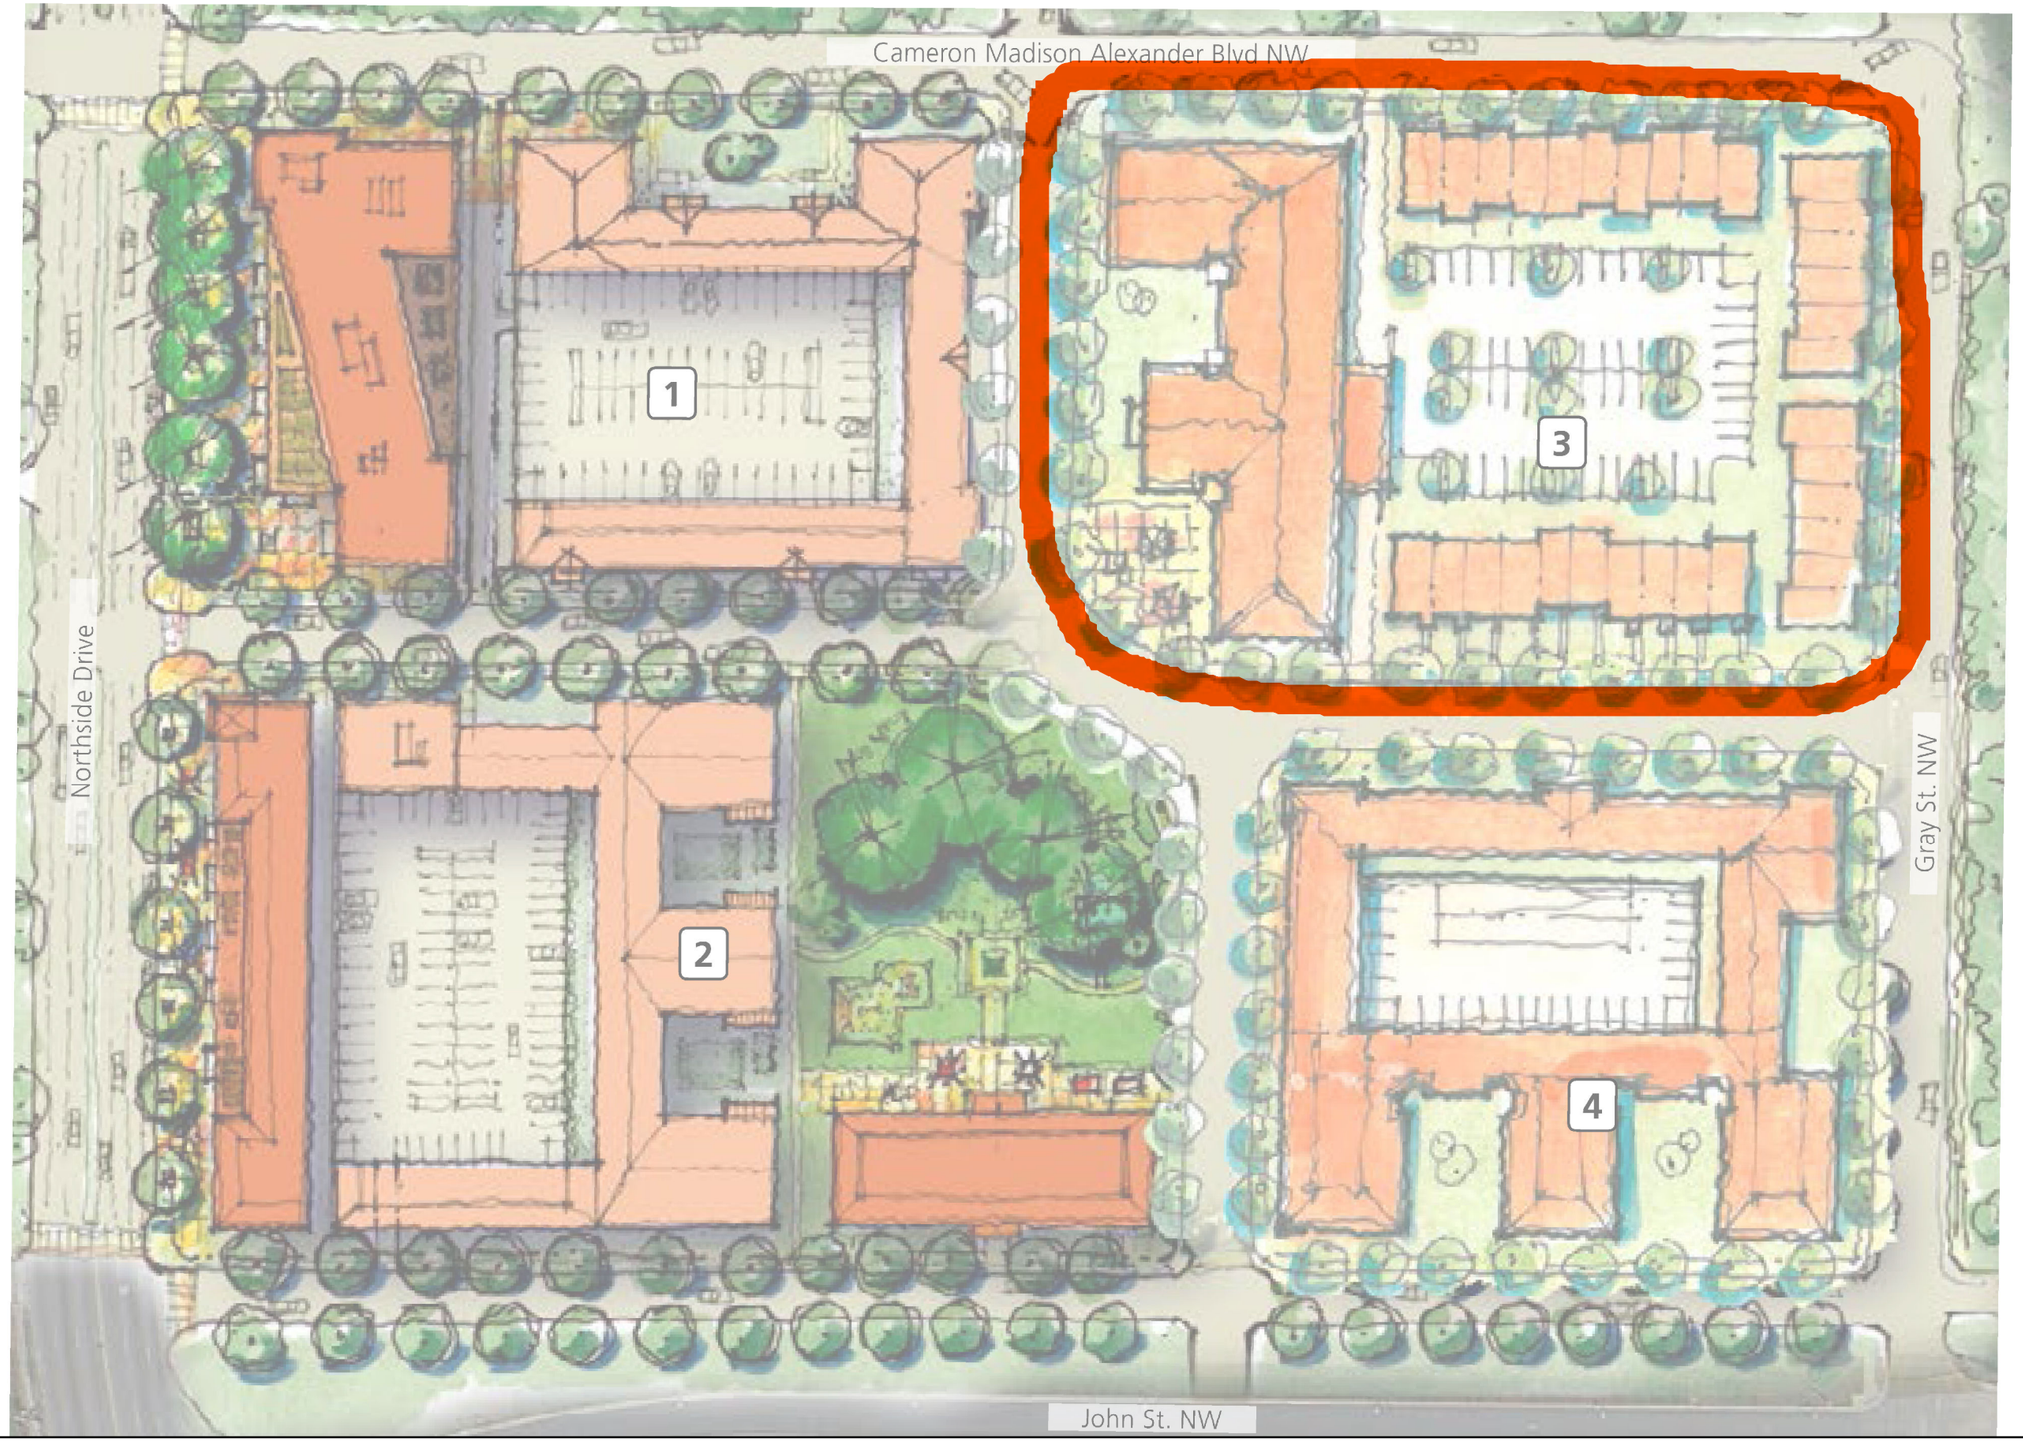

0 40 80
SCALE 1 " = 80 '

GENERAL NOTES/LEGEND

DIMENSIONS AND LOCATIONS ARE APPROXIMATE; ACTUAL MAY VARY. DRAWING SHALL NOT BE USED OUTSIDE THE CONTEXT OF THE REPORT FOR WHICH IT WAS GENERATED.

PROJECT NAME
HERNDON HOMES
ATLANTA, GEORGIA

SITE PLAN (PROPOSED CONDITIONS)

N
W E
S

JOB NUMBER 2017-0146.21

DATE 08/2018

DRAWN BY RCV

CHECKED BY JBK

FIGURE 6