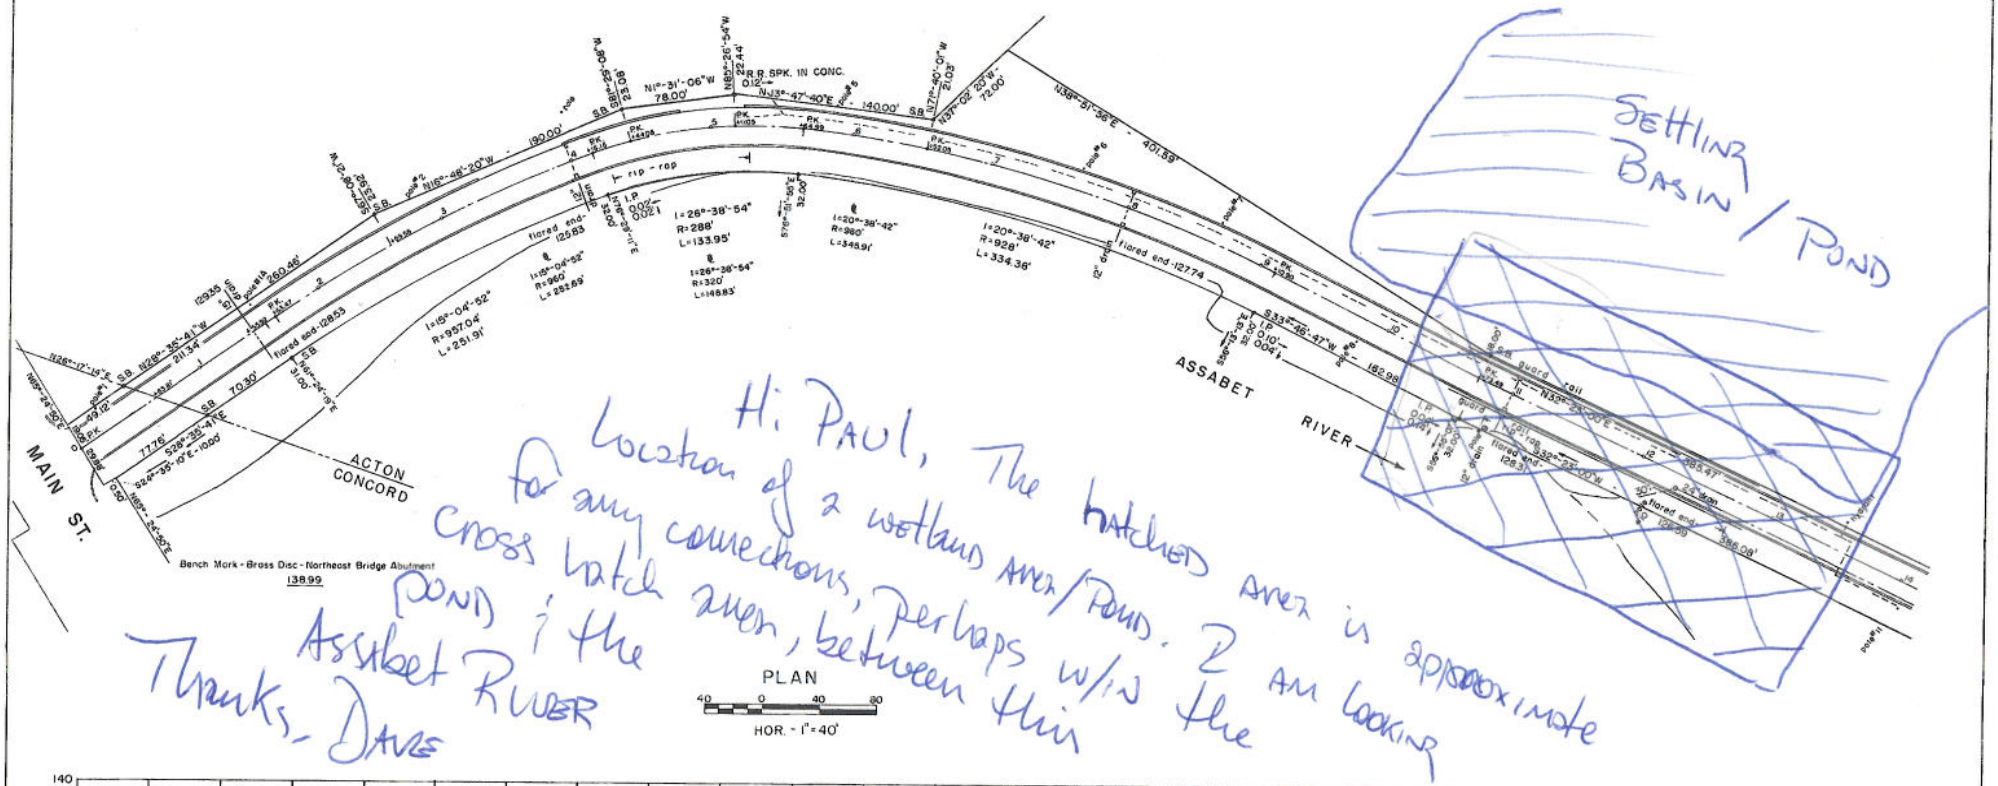

Hi Paul, The hatched area is approximate location of a wetland area/Pond. I am looking for any connections, perhaps w/in the cross hatch area, between this Pond & the Assabet River

Thanks, - Dave

PLAN

HOR. - 1" = 40'

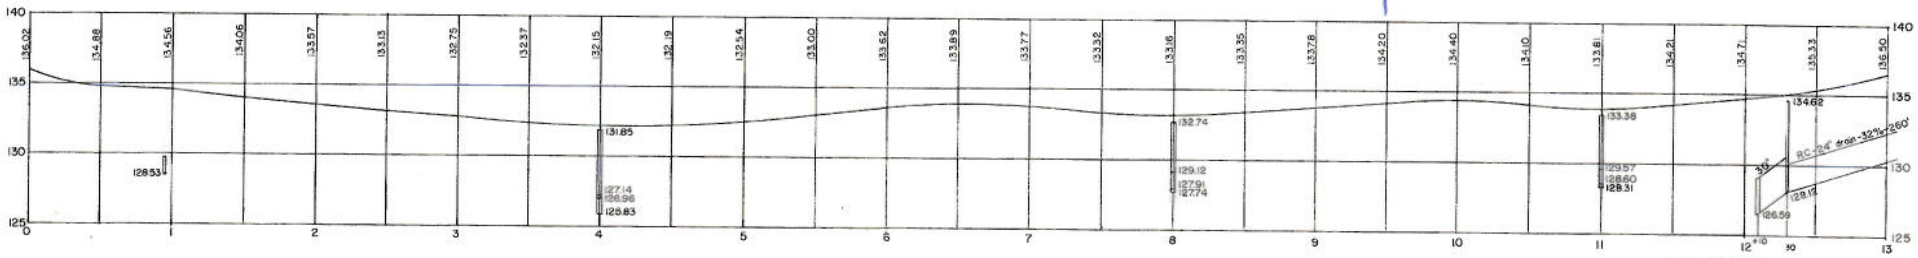

PROFILE

VERT. 1" = 4'

AS BUILT

STREET PLAN & PROFILE

-OF-

KNOX TRAIL

IN ACTON, MASS.

SCALES: AS SHOWN — JULY 28, 1977

WILLIAM R. BINGHAM & ASSOC. - REG. ENGRS. & SURVEYORS

24 COLUMBIA ST. - LEOMINSTER, MASS.