POND "D"

SCALE: 1" = 20'

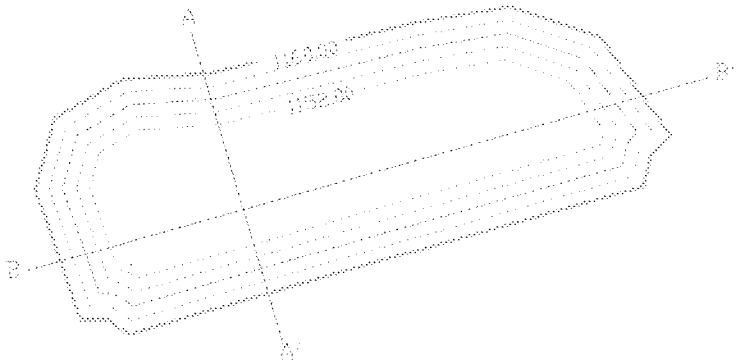

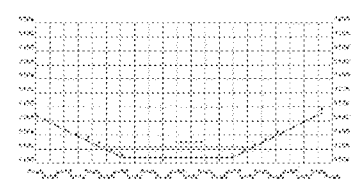

POND D
Cross-Section A-A'
SCALE: AS NOTED

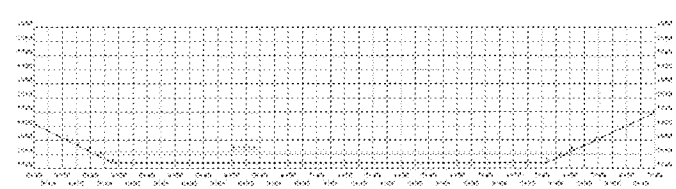

POND D
Cross-Section B-B'

The Ohio Valley Coal Company

No. 2 Dam
Pond 15 As-Built

TOVCC 20794