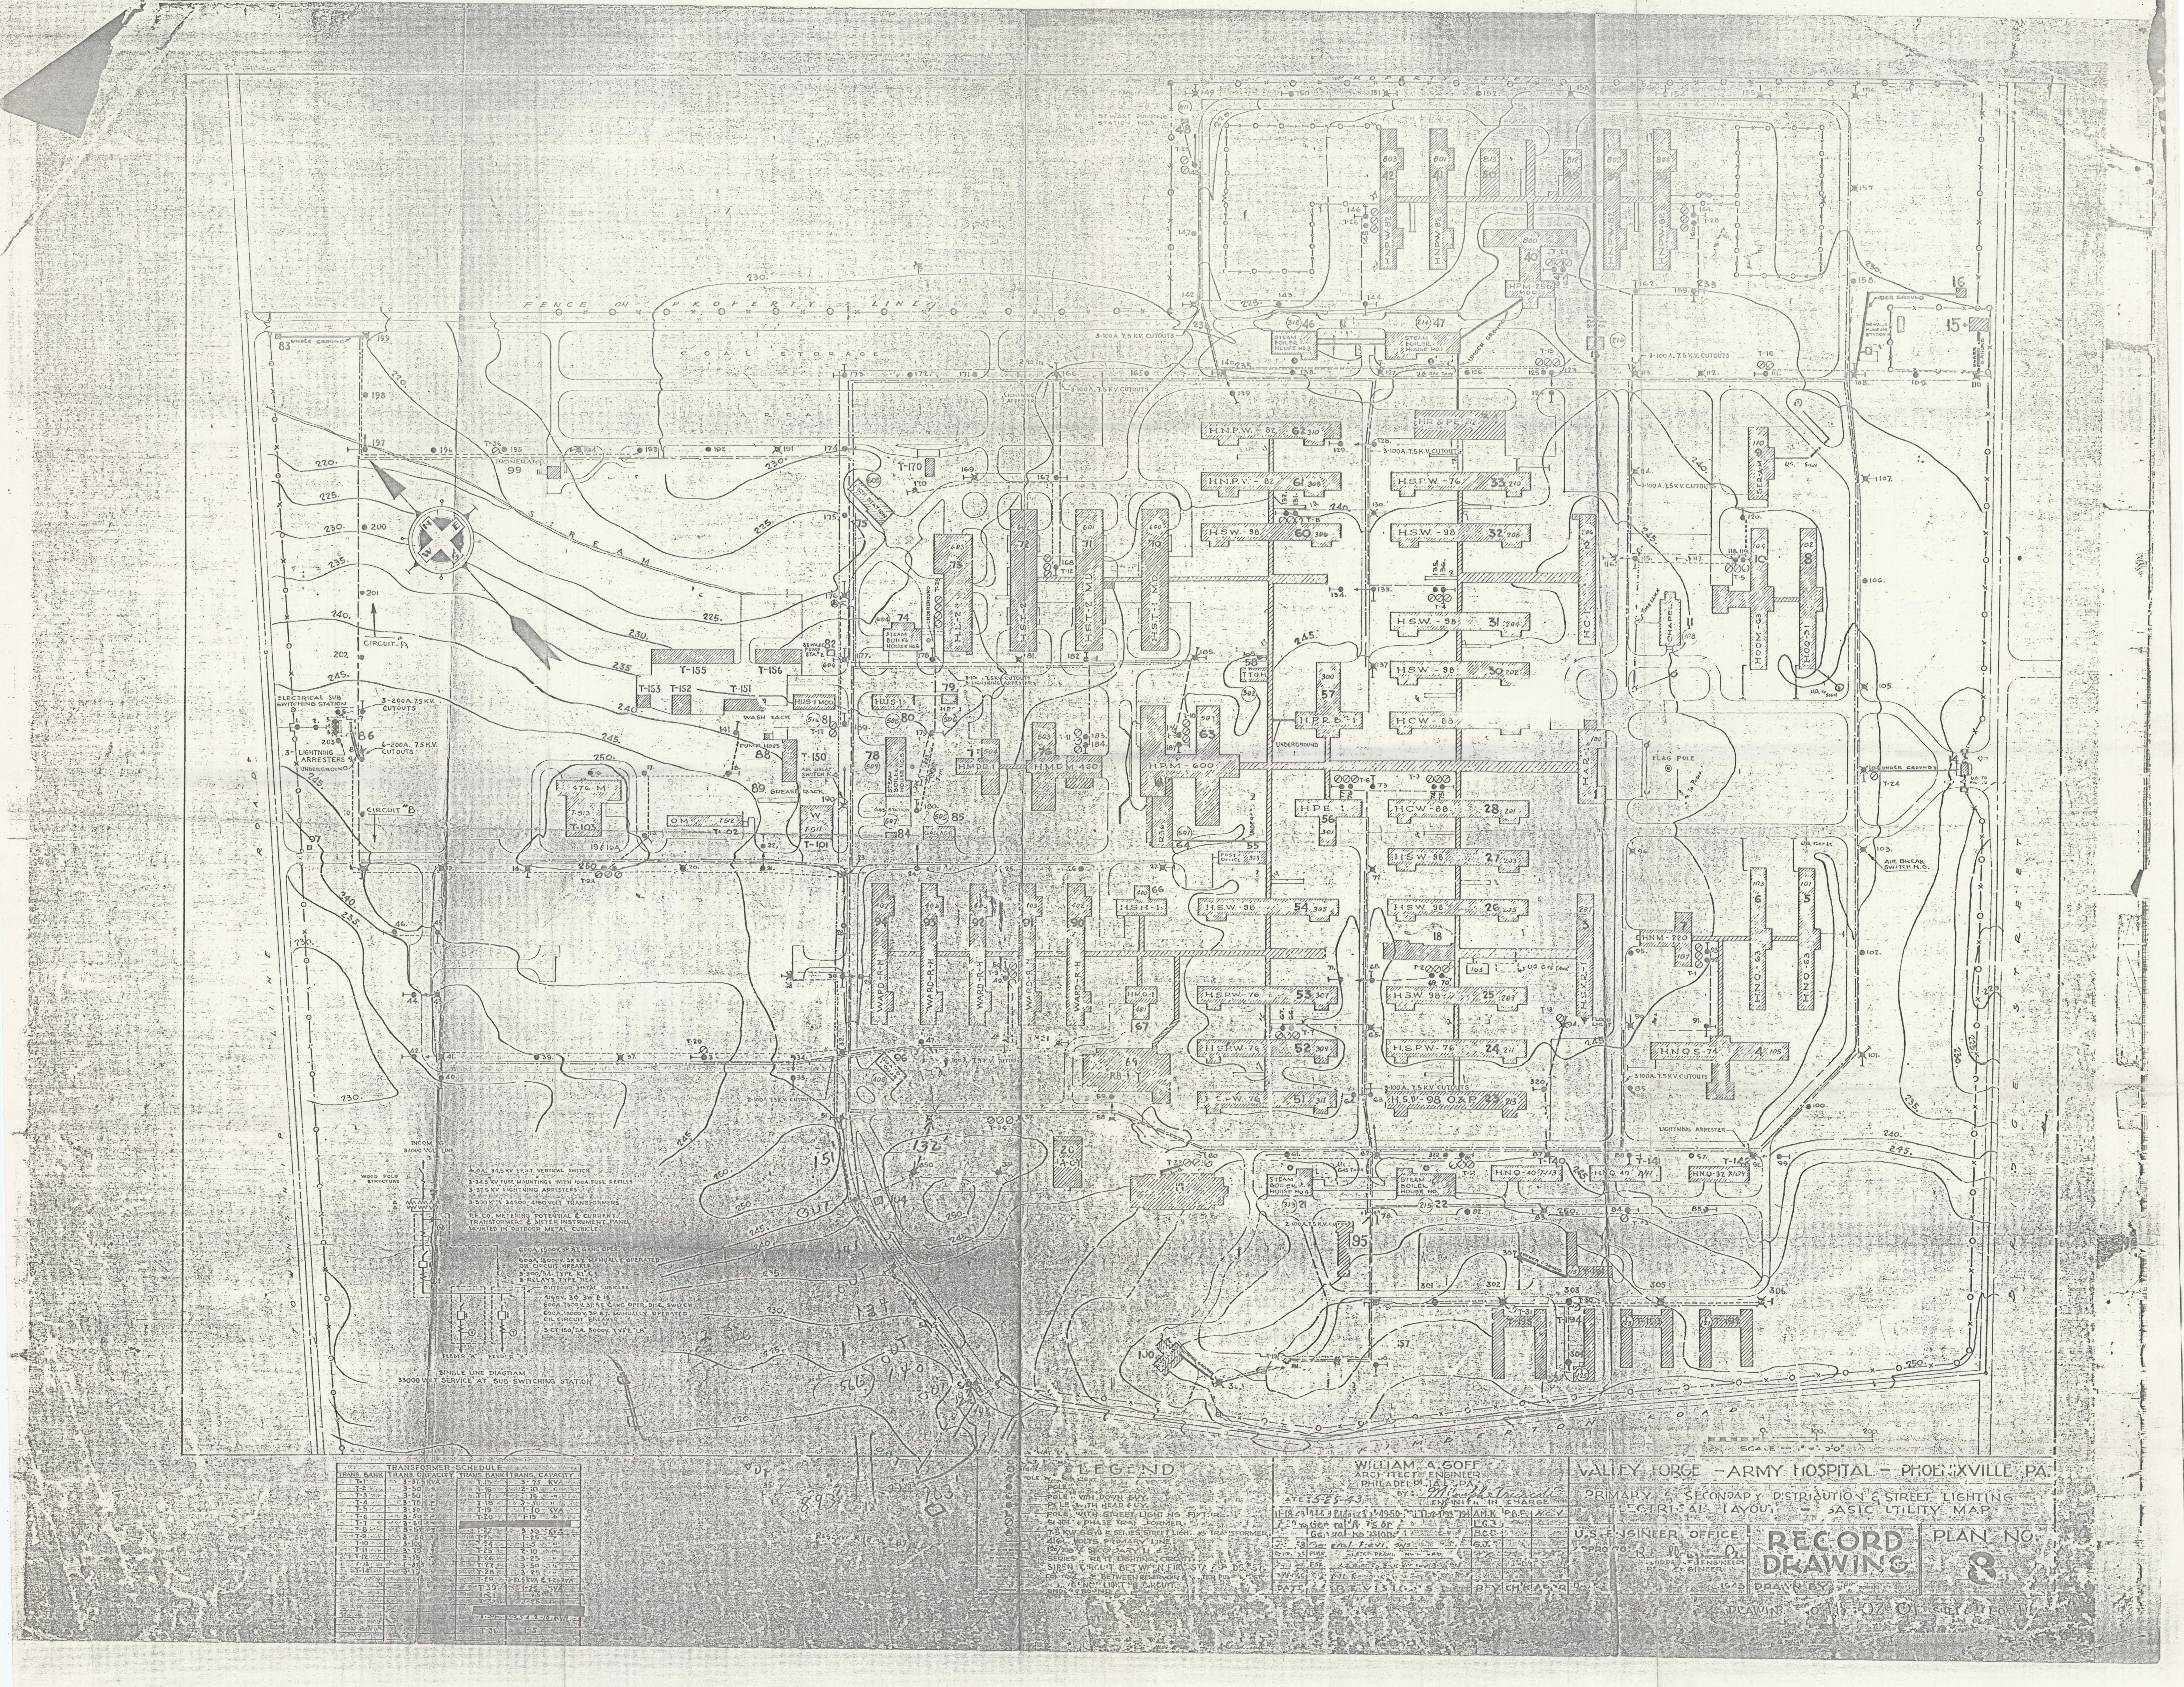

TRANSFORMER SCHEDULE

TRANS. BANK	TRANS. CAPACITY	TRANS. BANK	TRANS. CAPACITY
T-1	3-37.5 KVA	T-15	3-75 KVA
T-2	3-50	T-16	2-10
T-3	3-50	T-17	1-15
T-4	3-75	T-18	3-50
T-5	3-50	T-19	1-10 KVA
T-6	3-50	T-20	1-15
T-7	3-50	[redacted]	
T-8	3-50	T-22	3-50 KVA
T-9	3-50	T-23	1-25
T-10	3-100	T-24	1-5
T-11	3-75	T-25	2-10
T-12	3-15	T-26	3-25
T-13	1-37.5	T-27	3-50
T-14	3-1[illegible]	T-28	3-25
		T-29	3-31.5 KVA & 1-25 KVA
		T-30	1-25 KVA
		T-31	1-15
		T-32	3-25
		[redacted]	
		T-34	3-25 & 2-10 KVA
		T-36	1-5

WILLIAM A. GOFF
ARCHITECT ENGINEER
PHILADELPHIA, PA.

DATE: 5-25-43

ENGINEER IN CHARGE

DATE	REVISIONS	BY	CH'K'D
11-18-43	Bldgs. (?) 49-50-(?) T1-12-193-194	AM.K.	H.C.V.
	General Rev.	L.G.J.	
	General Revisions	B.C.E.	
	General Revisions	G.J.	

VALLEY FORGE - ARMY HOSPITAL - PHOENIXVILLE PA.

PRIMARY & SECONDARY DISTRIBUTION & STREET LIGHTING
ELECTRICAL LAYOUT - BASIC UTILITY MAP

U.S. ENGINEER OFFICE
APPROVED:
CORPS OF ENGINEERS
DISTRICT ENGINEER
1943

RECORD DRAWING

DRAWN BY

PLAN NO. 8

DRAWING No. 13-02-01 SHEET 1 OF 1

ORIGINAL (Red)