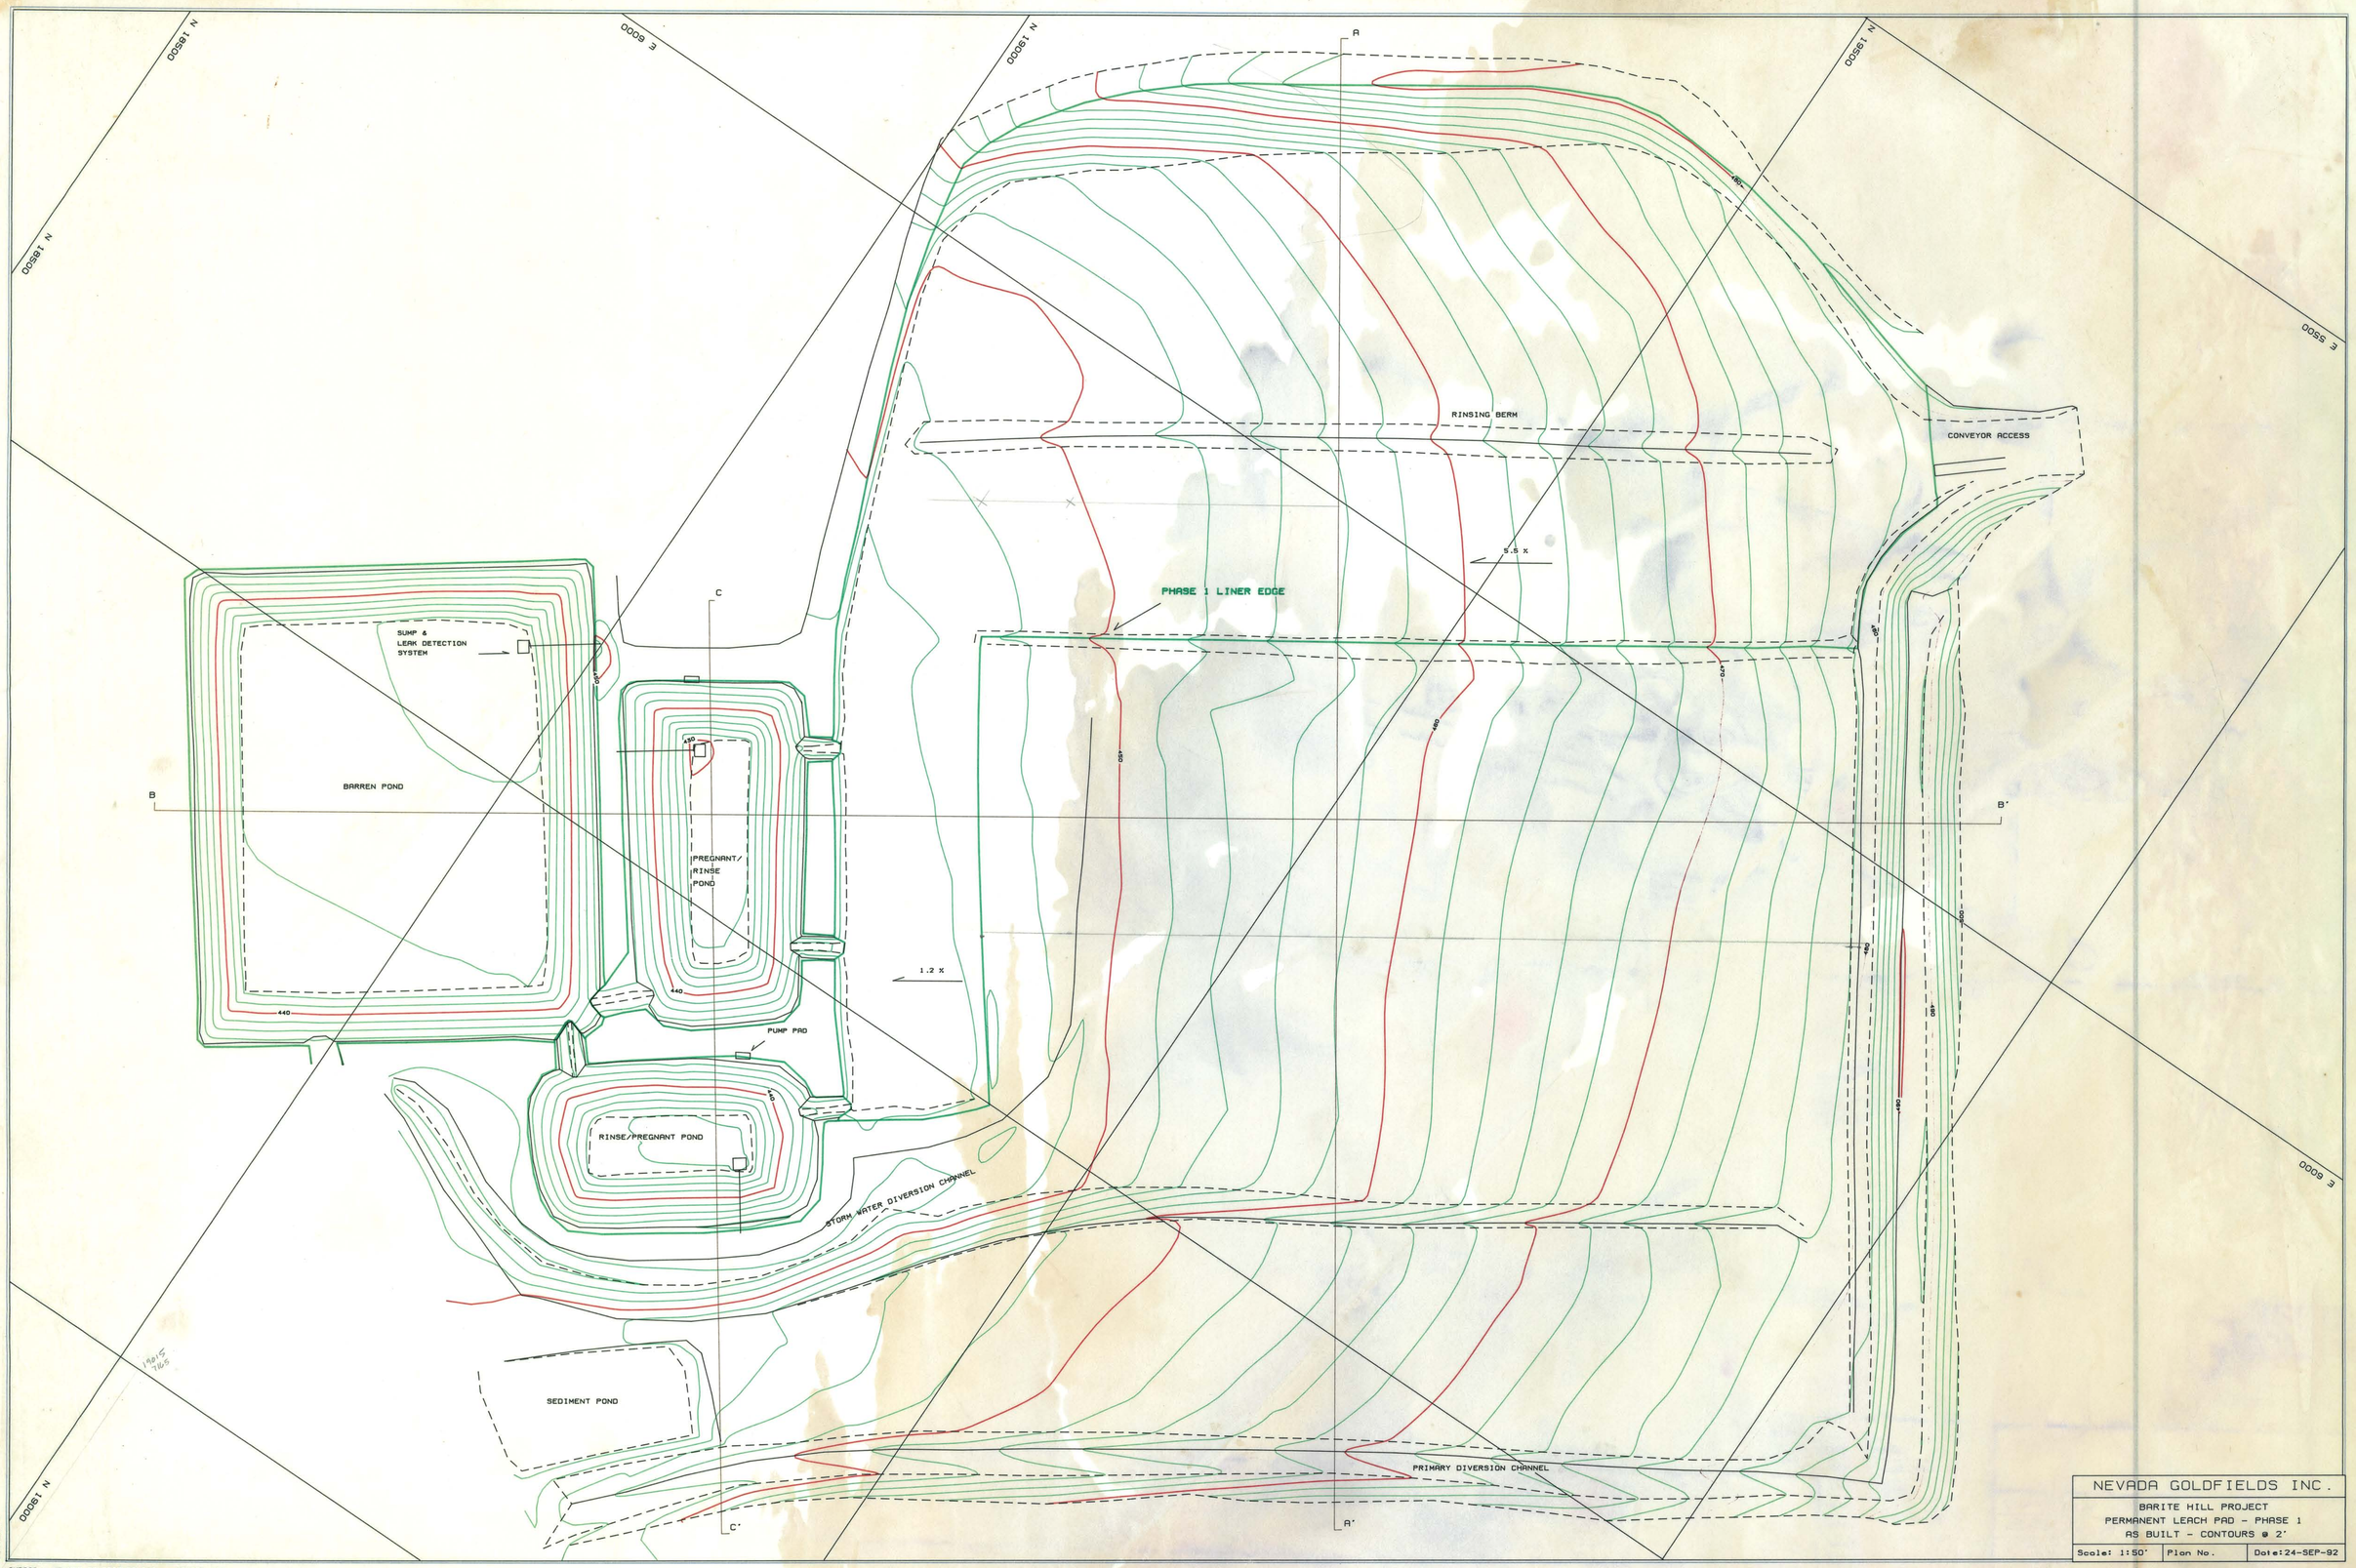

NEVADA GOLDFIELDS INC.		
BARITE HILL PROJECT PERMANENT LEACH PAD - PHASE 1 AS BUILT - CONTOURS @ 2'		
Scale: 1:50'	Plan No.	Date:24-SEP-92

SURPAC - NEVADA GOLDFIELDS INC. - BARITE HILL

PLPHSB.PF