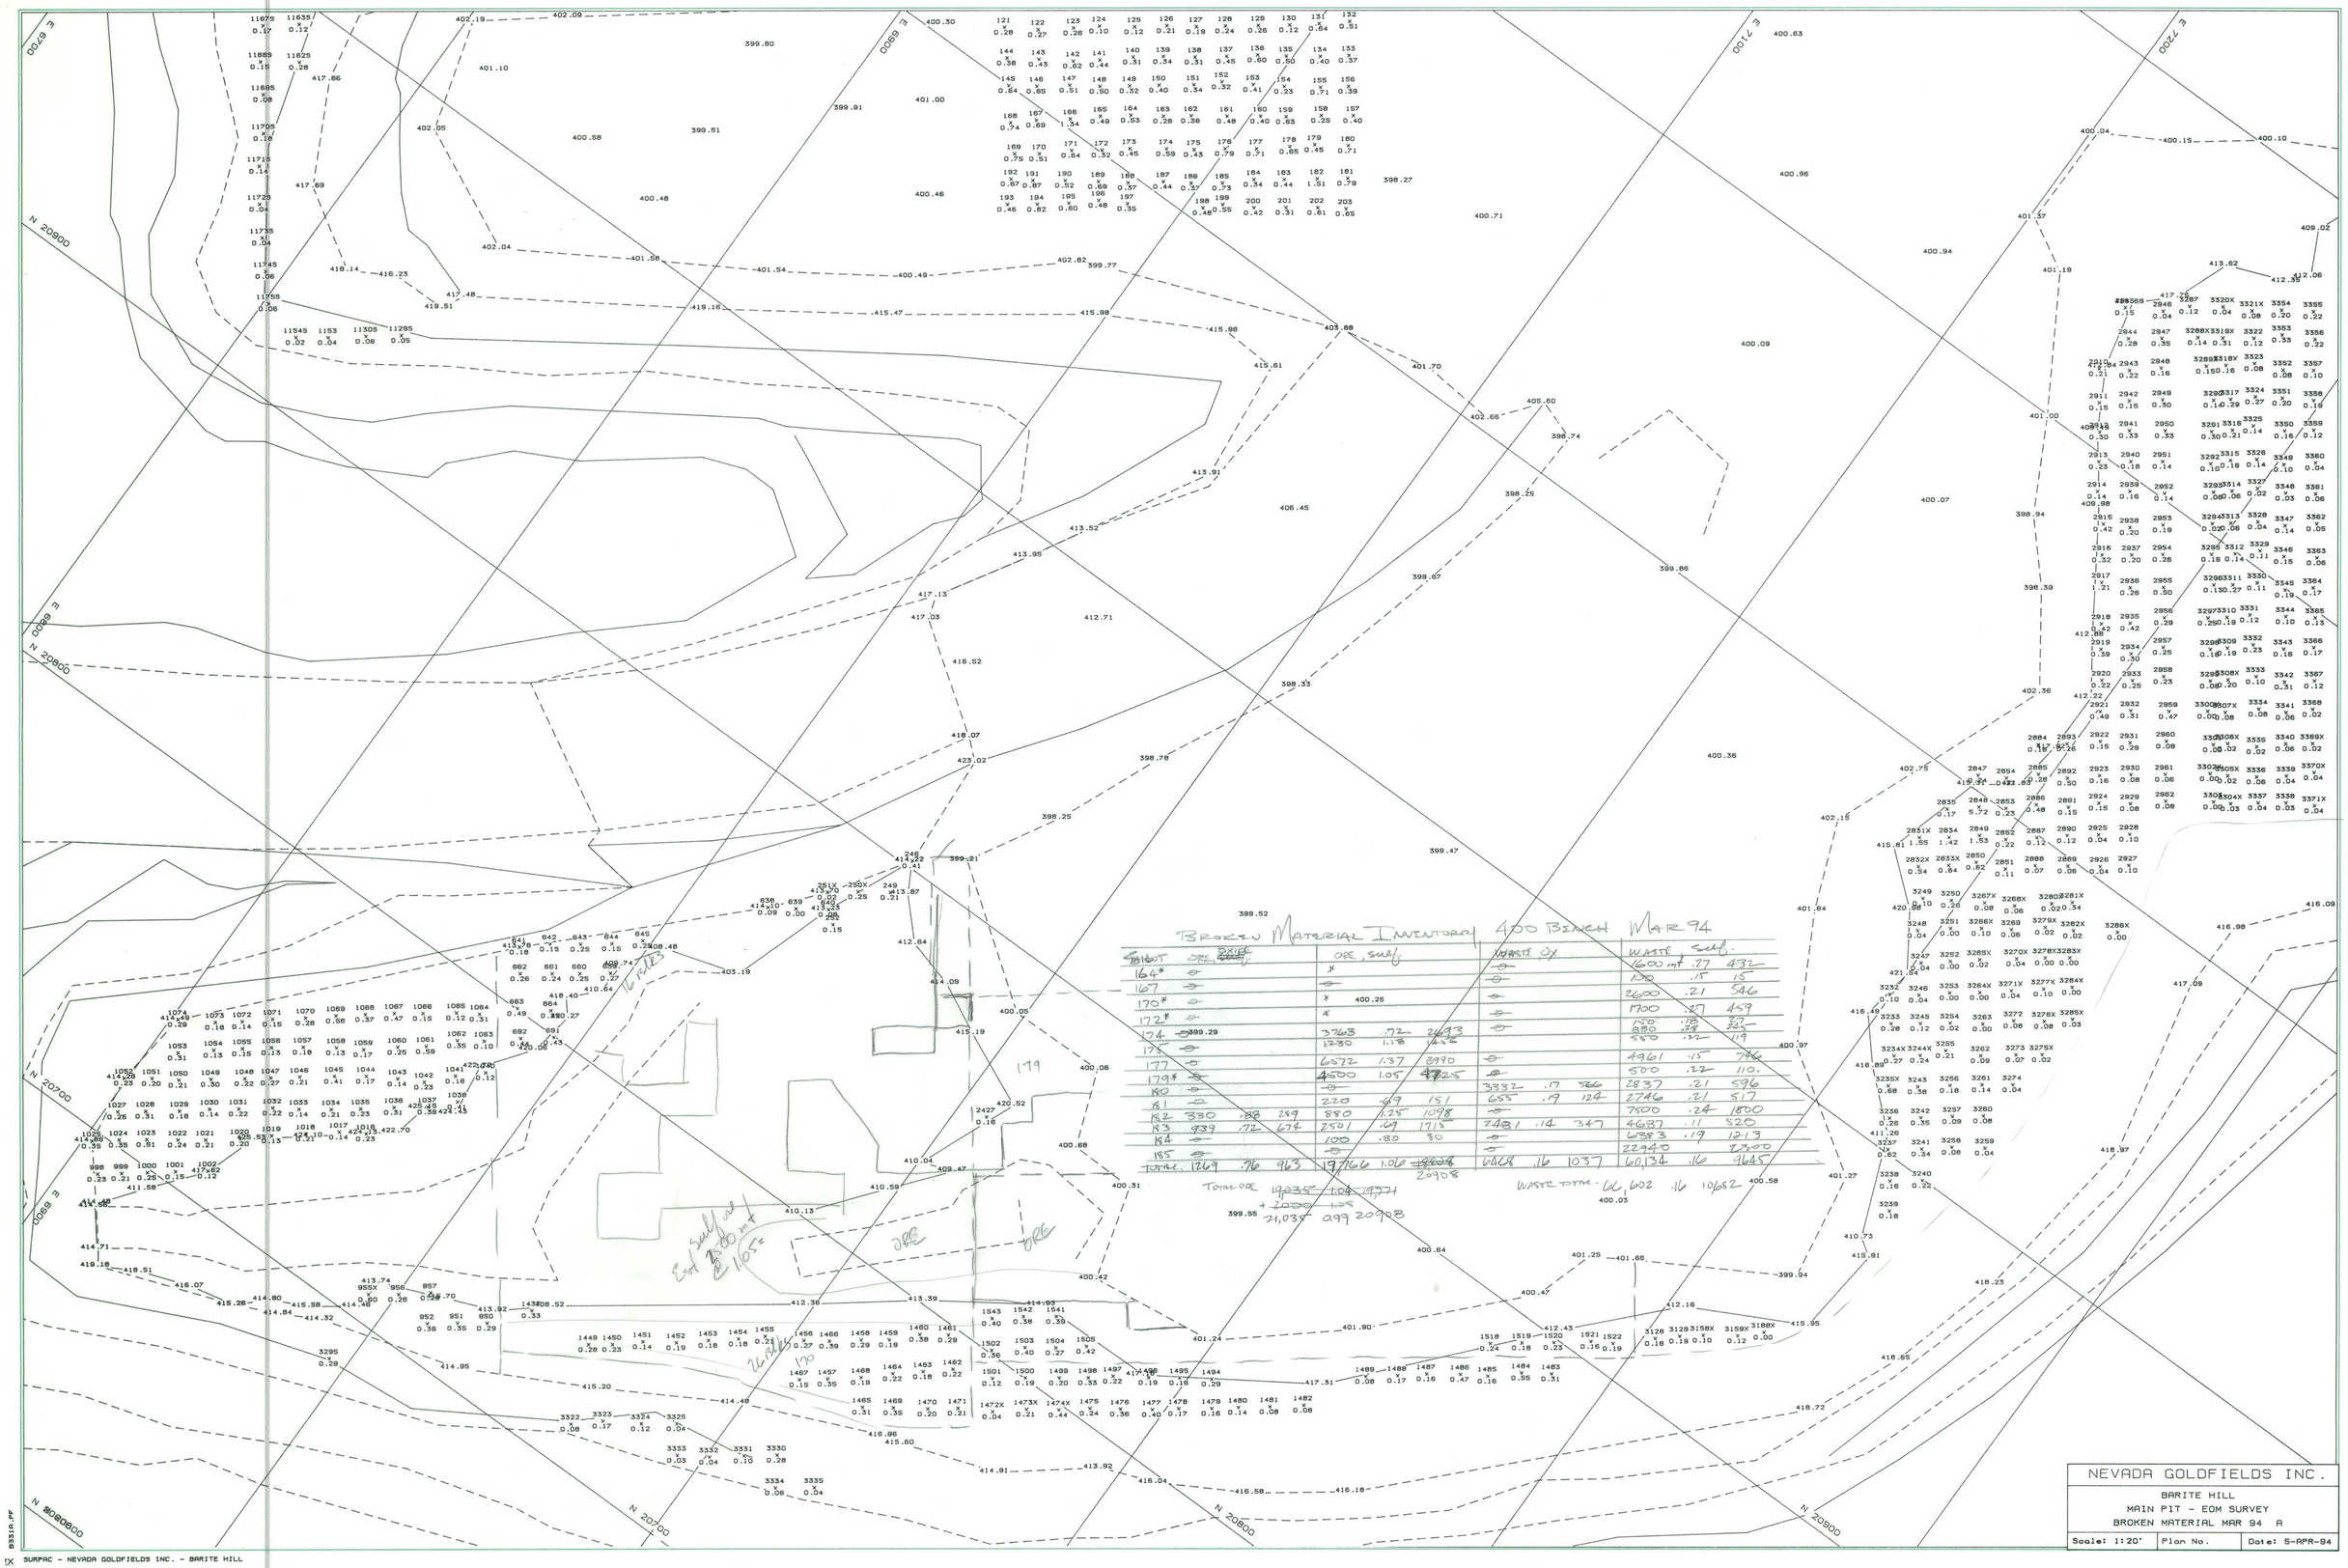

BROKEN MATERIAL INVENTORY 400 BENCH MAR 94

SHOT	ORE, OXIDE			ORE, sulf.			WASTE OX			WASTE, sulf.		
164*	⊖			x			⊖			1600 mt	.27	432
167	⊖			⊖			⊖			100	.15	15
170*	⊖			x			⊖			2600	.21	546
172*	⊖			x			⊖			1700	.27	459
174	⊖			3763	.72	2693	⊖			150	.18	27
175	⊖			1230	1.18	1452				880	.28	245
177	⊖			6572	1.37	3990	⊖			550	.22	119
179*	⊖			4500	1.05	4725	⊖			4961	.15	746
180	⊖			⊖			3332	.17	566	500	.22	110.
181	⊖			220	.69	151	655	.19	124	2837	.21	596
182	330	.88	289	880	1.25	1098	⊖			2746	.21	517
183	939	.72	674	2501	.69	1715	2481	.14	347	7500	.24	1800
184	⊖			100	.80	80	⊖			4687	.11	520
185	⊖			⊖			⊖			6383	.19	1213
TOTAL	1269	.76	963	19766	1.06	~~18808~~ 20908	6468	.16	1037	22940		7300
										60,134	.16	9645

TOTAL ORE ~~19,035~~ ~~1.04~~ ~~19,771~~
+ ~~2000~~ ~~1.05~~
21,035 0.99 20908

WASTE TOTAL 66,602 .16 10,682

NEVADA GOLDFIELDS INC.

BARITE HILL
MAIN PIT - EOM SURVEY
BROKEN MATERIAL MAR 94 A

Scale: 1:20' | Plan No. | Date: 5-APR-94

B331A.PF

SURPAC - NEVADA GOLDFIELDS INC. - BARITE HILL