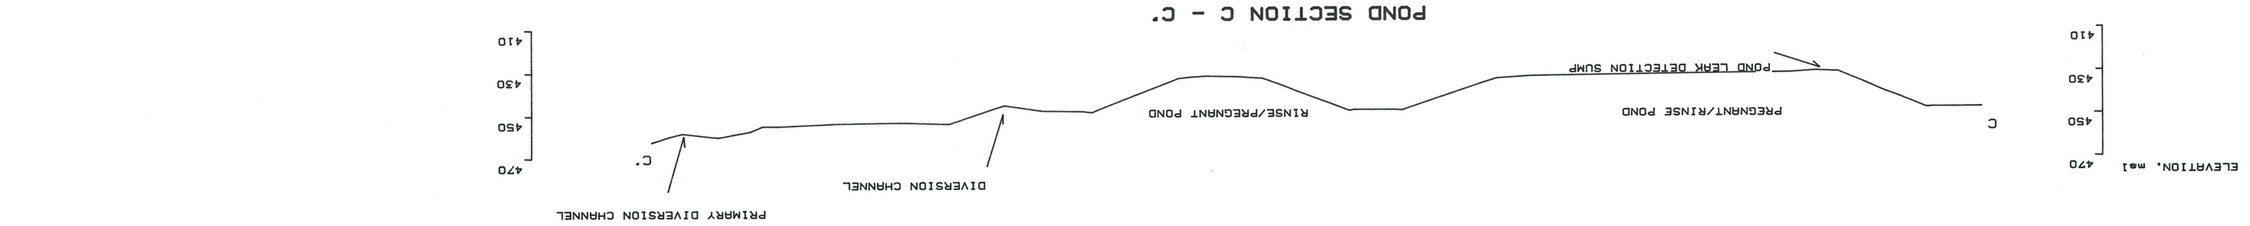

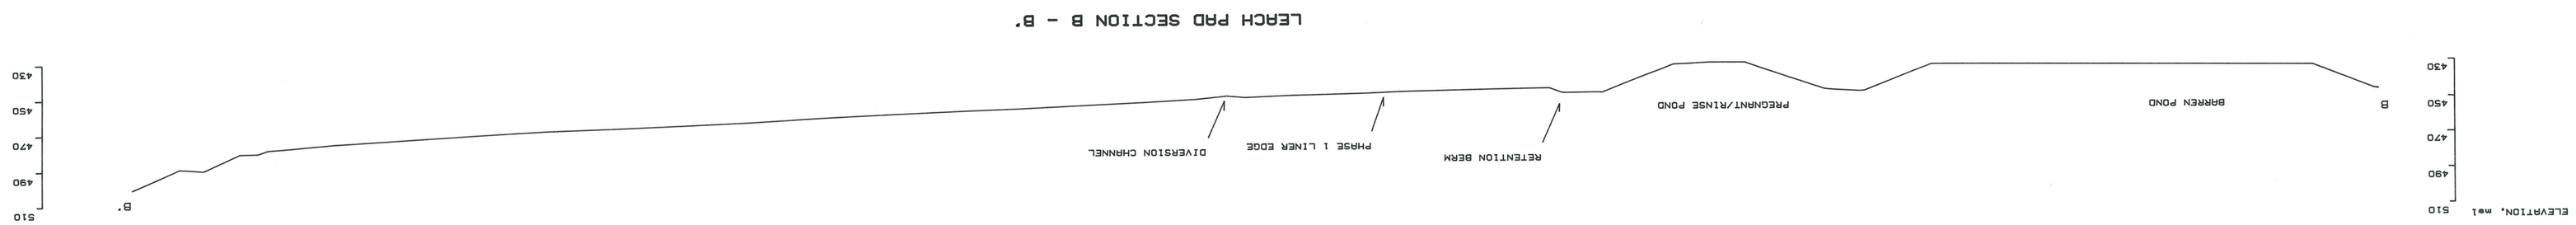

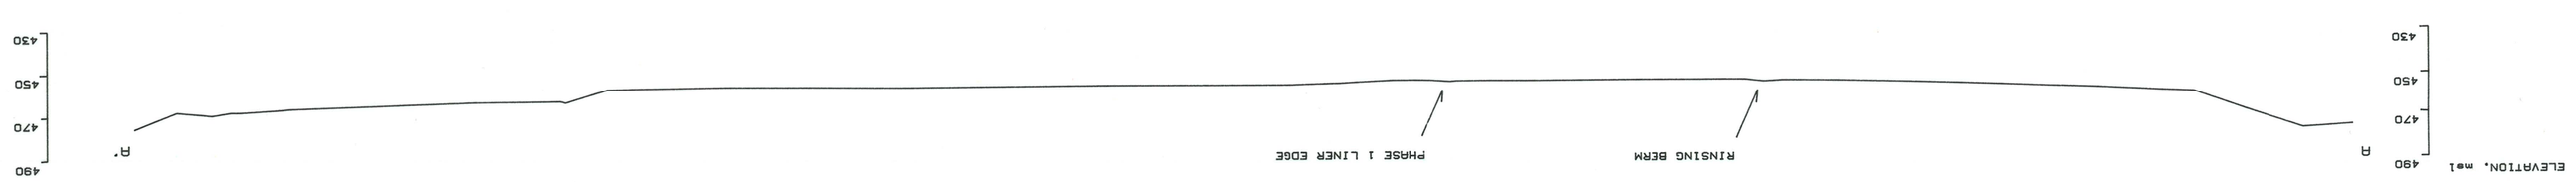

NEVADA GOLDFIELDS INC.

BARRITE HILL PROJECT
PERMANENT LEACH PAD
AS BUILT CROSS SECTIONS

Scale: 1:50'	Plan No.	Date:23-SEP-92

N O

N O

E O