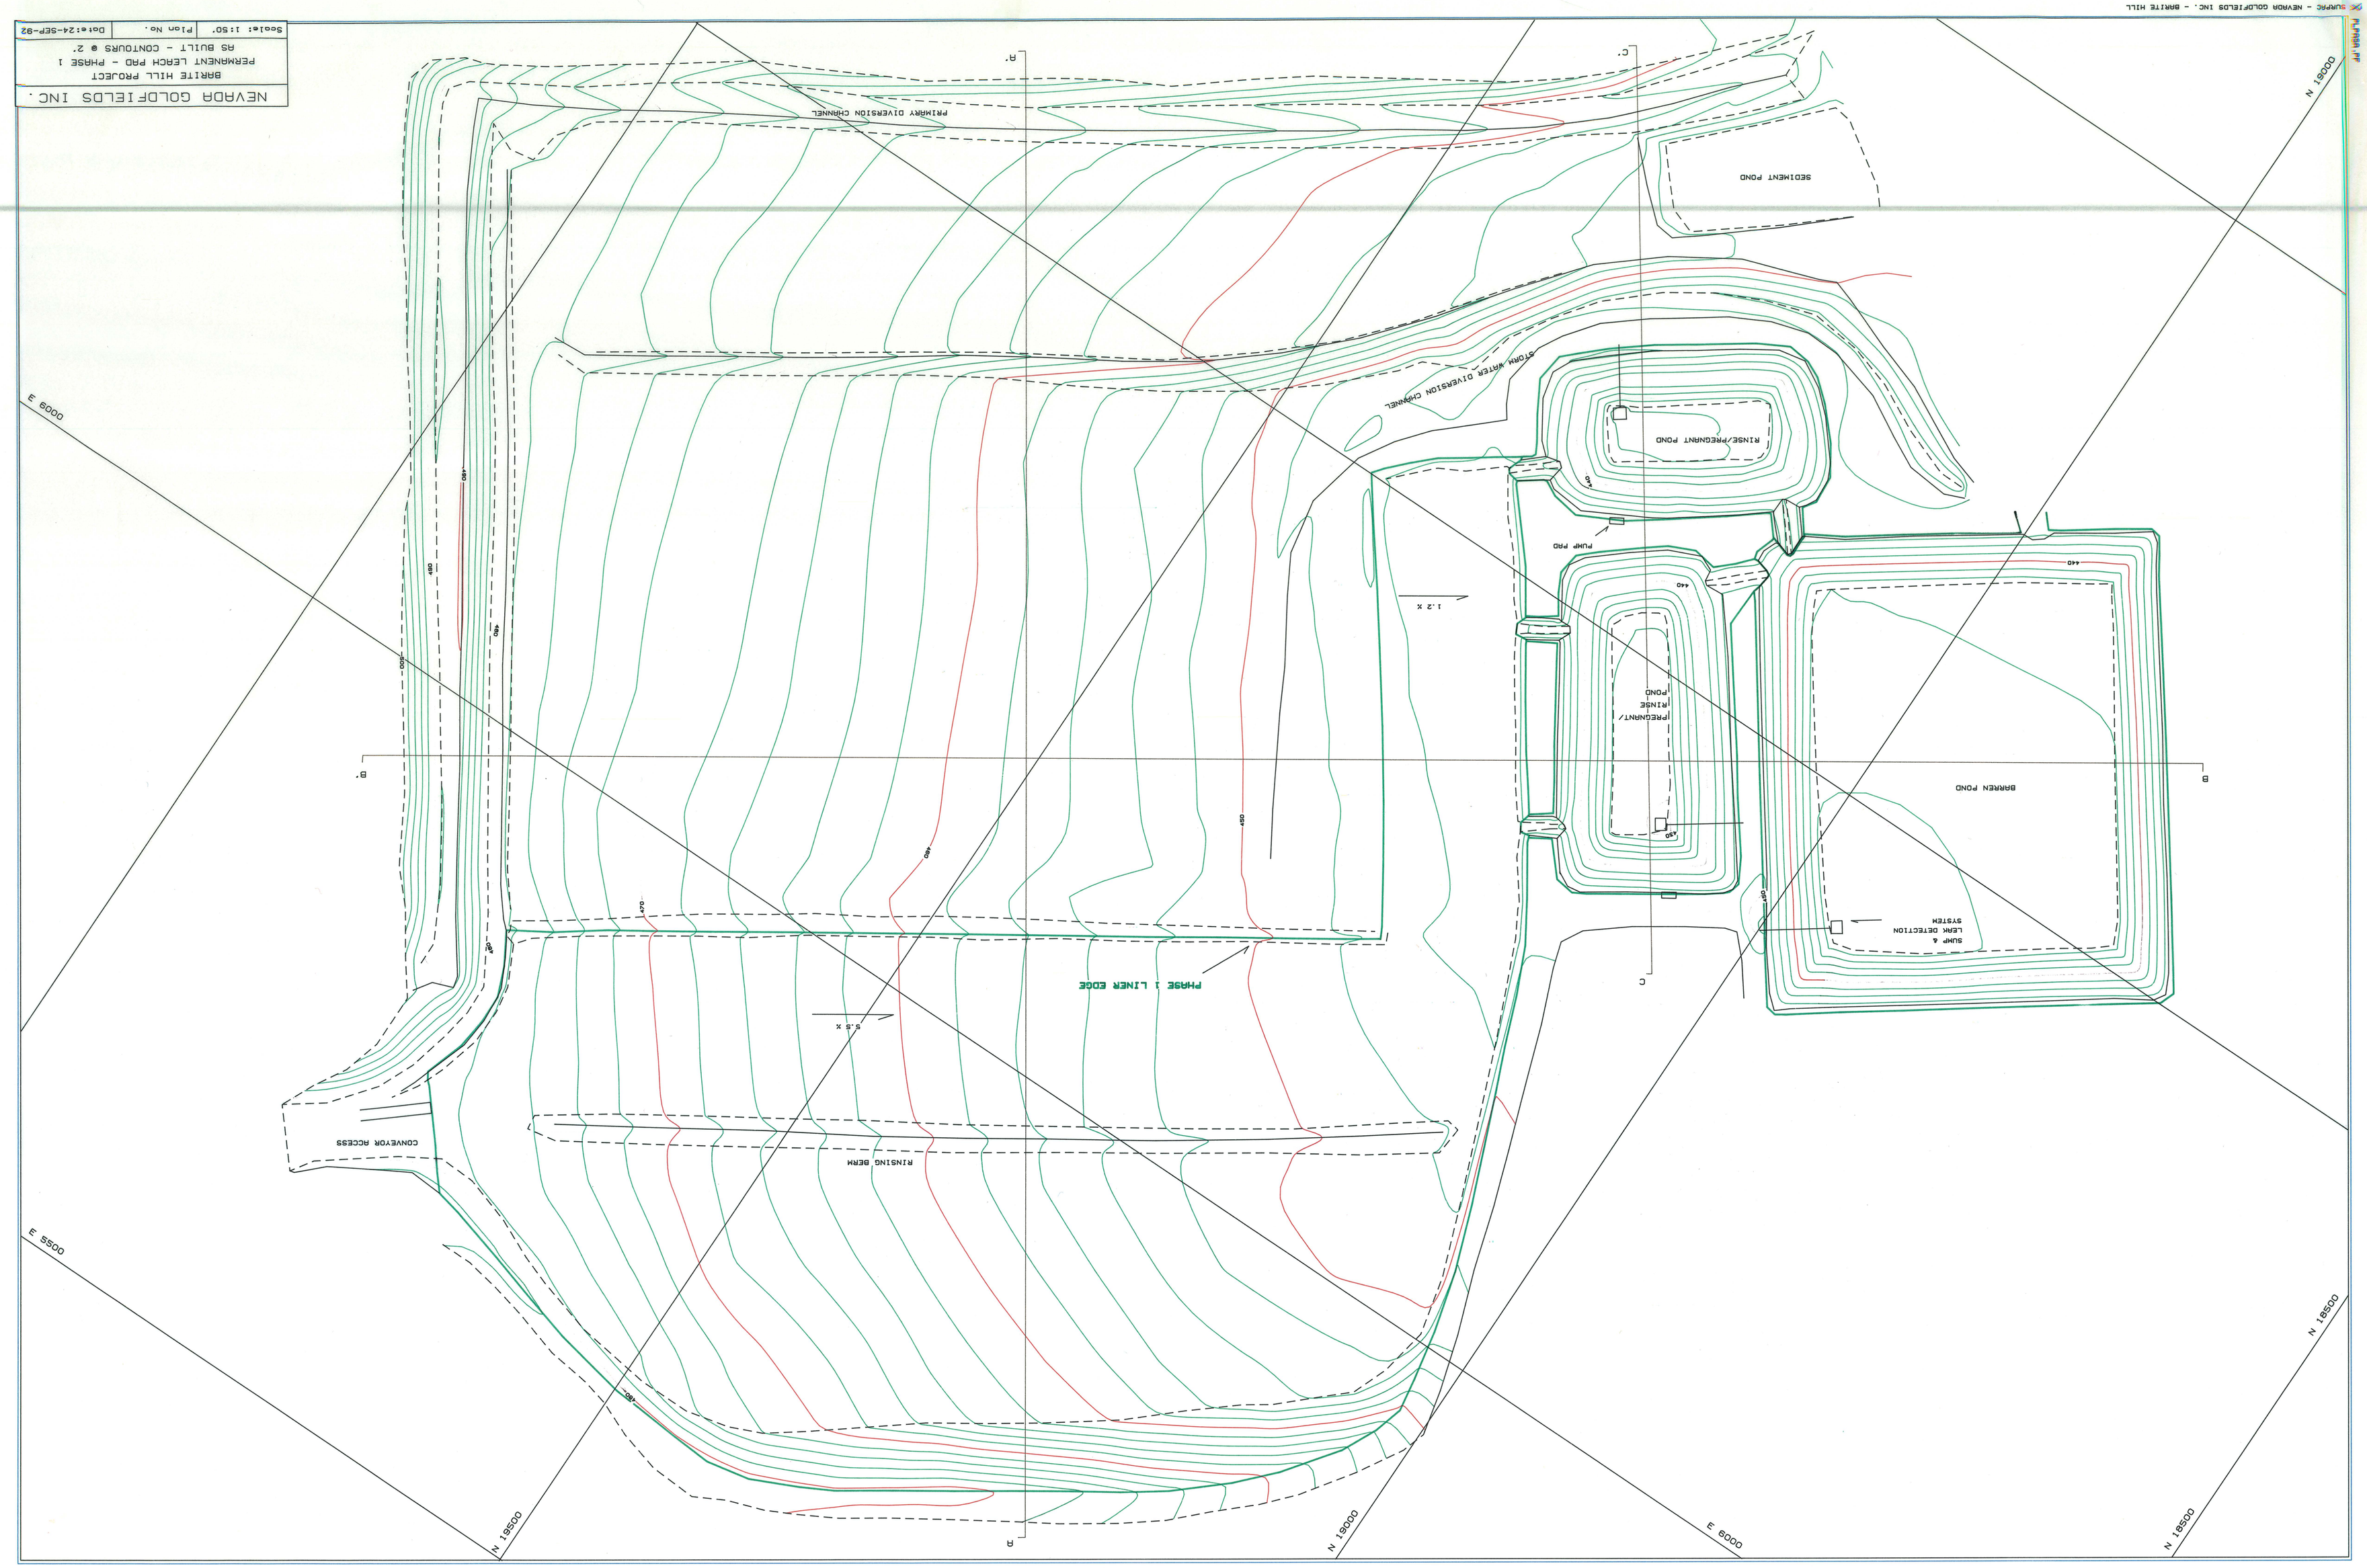
NEVADA GOLDFIELDS INC.
BARITE HILL PROJECT
PERMANENT LEACH PAD - PHASE 1
AS BUILT - CONTOURS @ 2'
Scale: 1:50'
Plan No.
Date:24-SEP-92
PRIMARY DIVERSION CHANNEL
SEDIMENT POND
STORM WATER DIVERSION CHANNEL
RINSE/PREGNANT POND
PUMP PAD
PREGNANT/ RINSE POND
BARREN POND
SUMP & LEAK DETECTION SYSTEM
PHASE 1 LINER EDGE
CONVEYOR ACCESS
RINSING BERM
1.2 %
5.5 %
E 6000
E 5500
N 19500
N 19000
N 18500
N 18500
A
A'
B
B'
C
C'