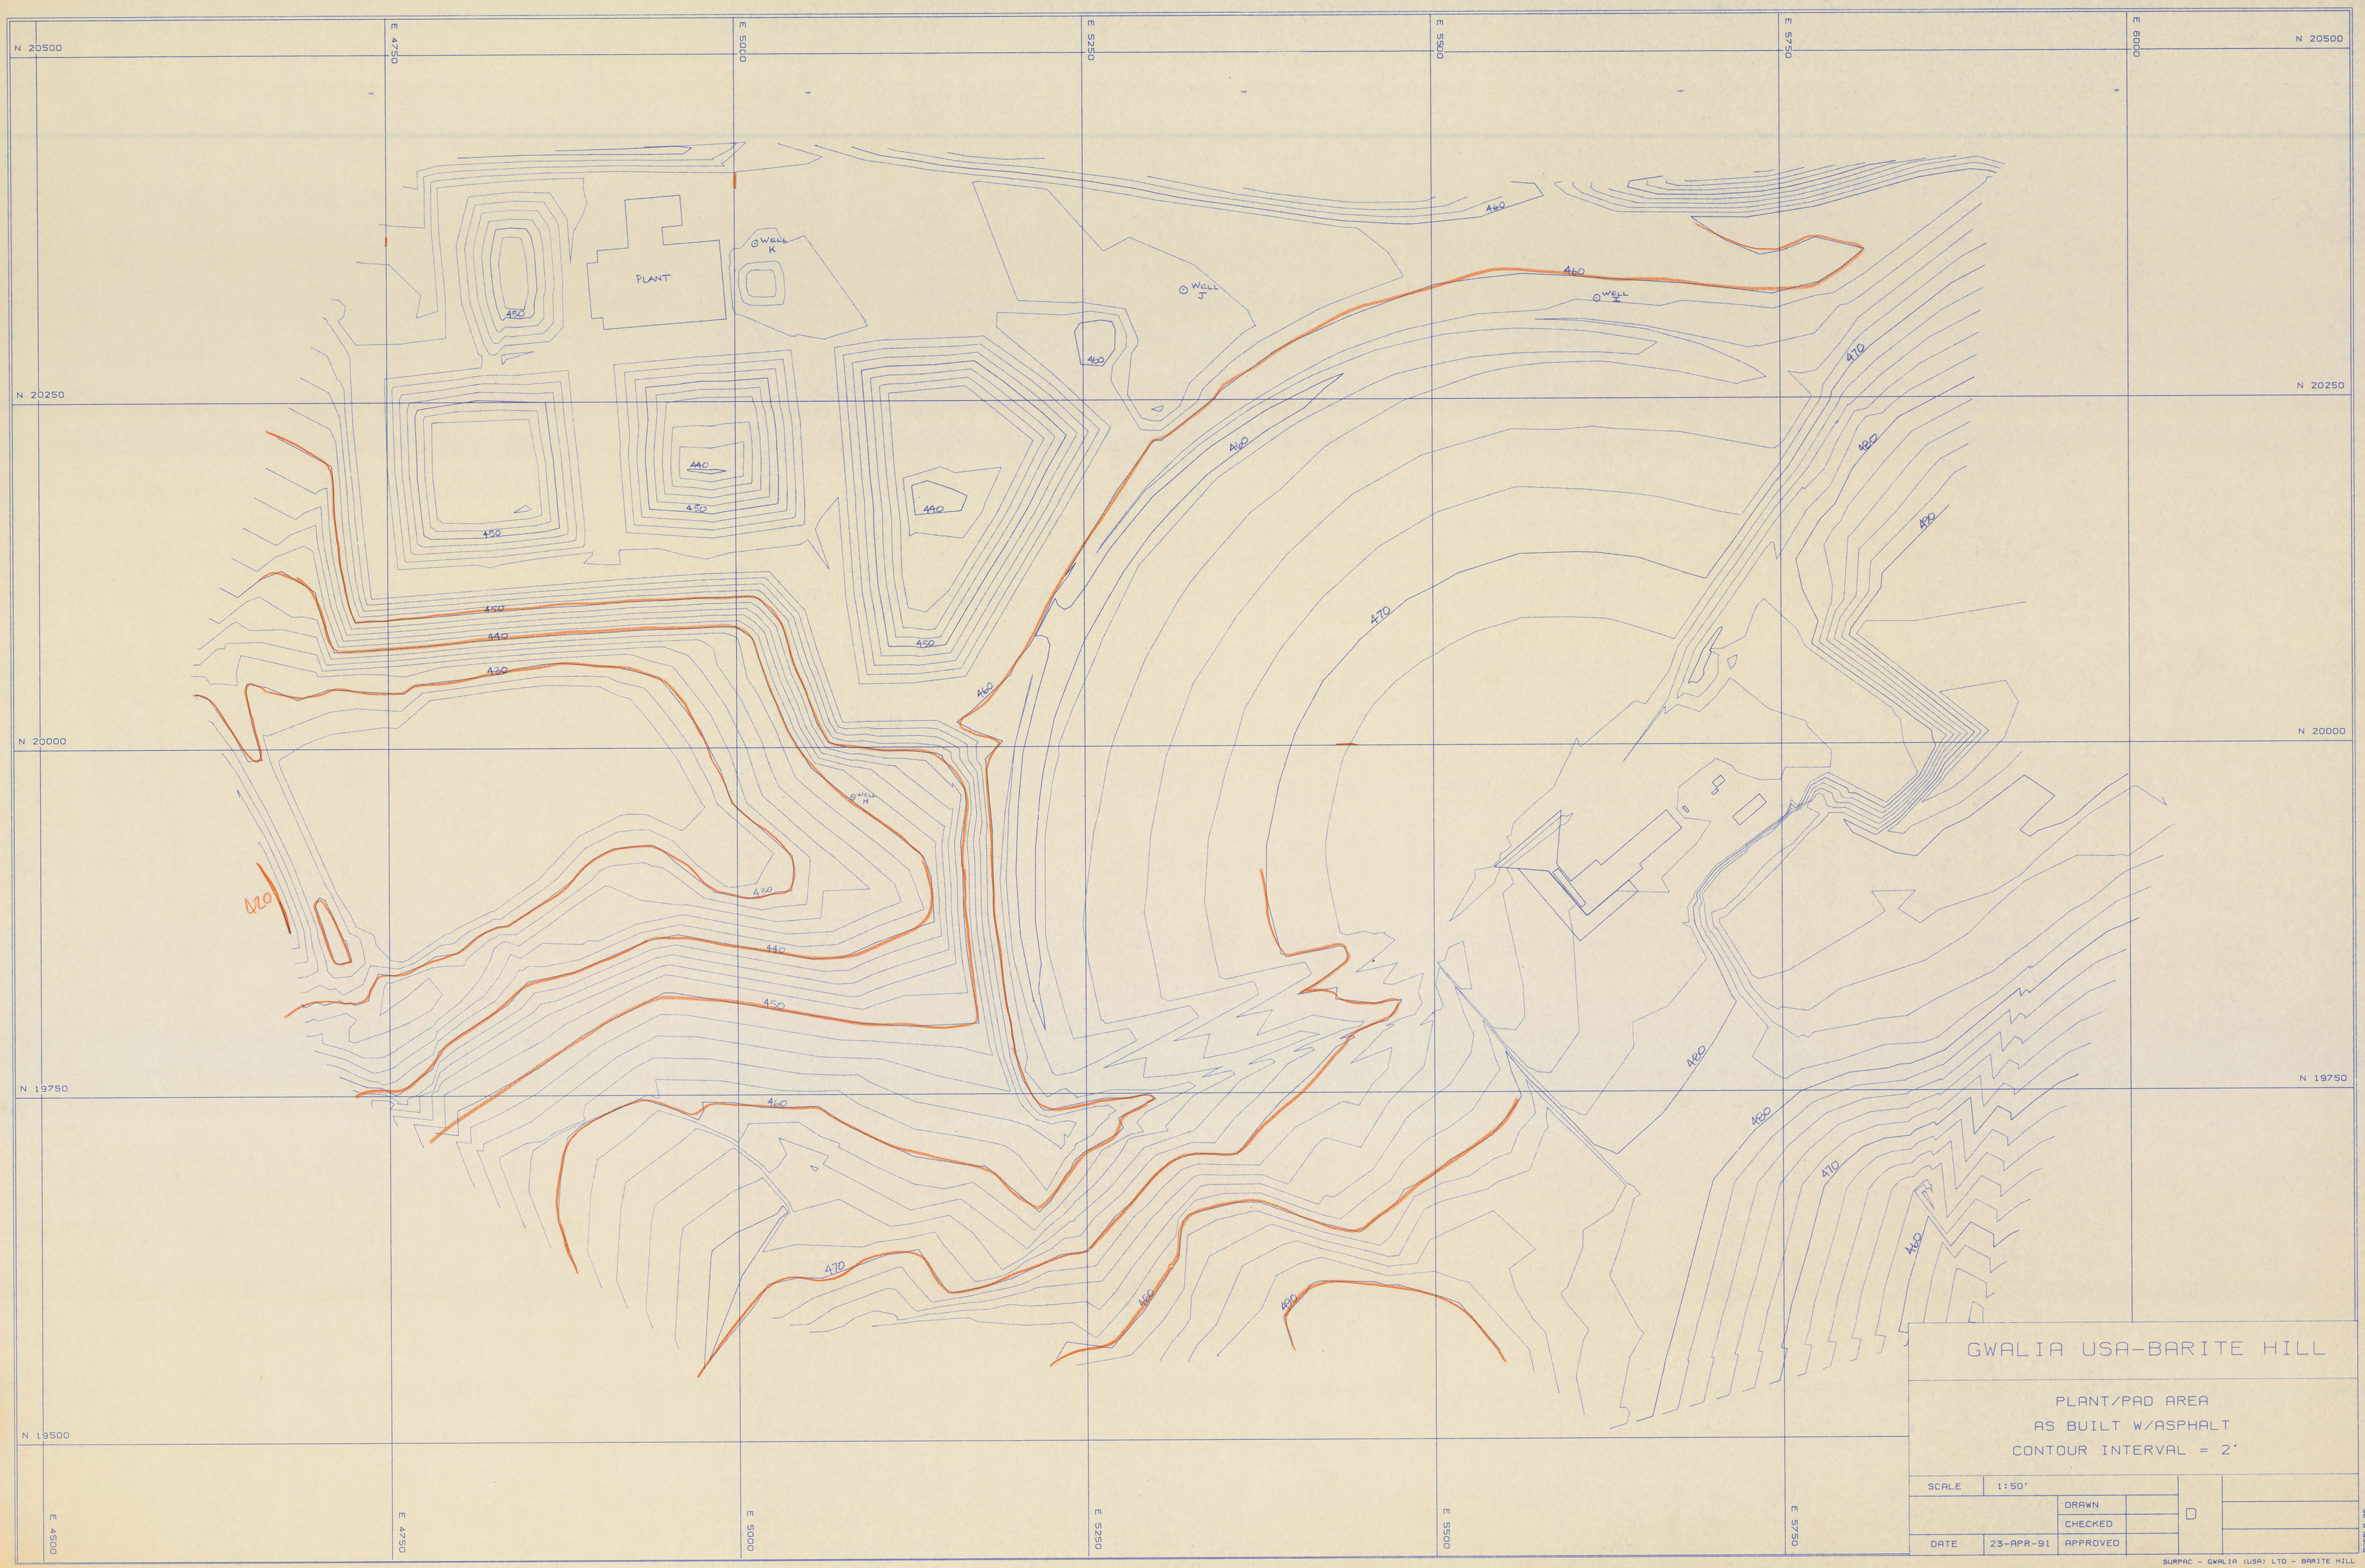

GWALIA USA-BARITE HILL

PLANT/PAD AREA
AS BUILT W/ASPHALT
CONTOUR INTERVAL = 2'

SCALE	1:50'			D
		DRAWN		
		CHECKED		
DATE	23-APR-91	APPROVED		

PASBLB.PF

SURPAC - GWALIA (USA) LTD - BARITE HILL

2859