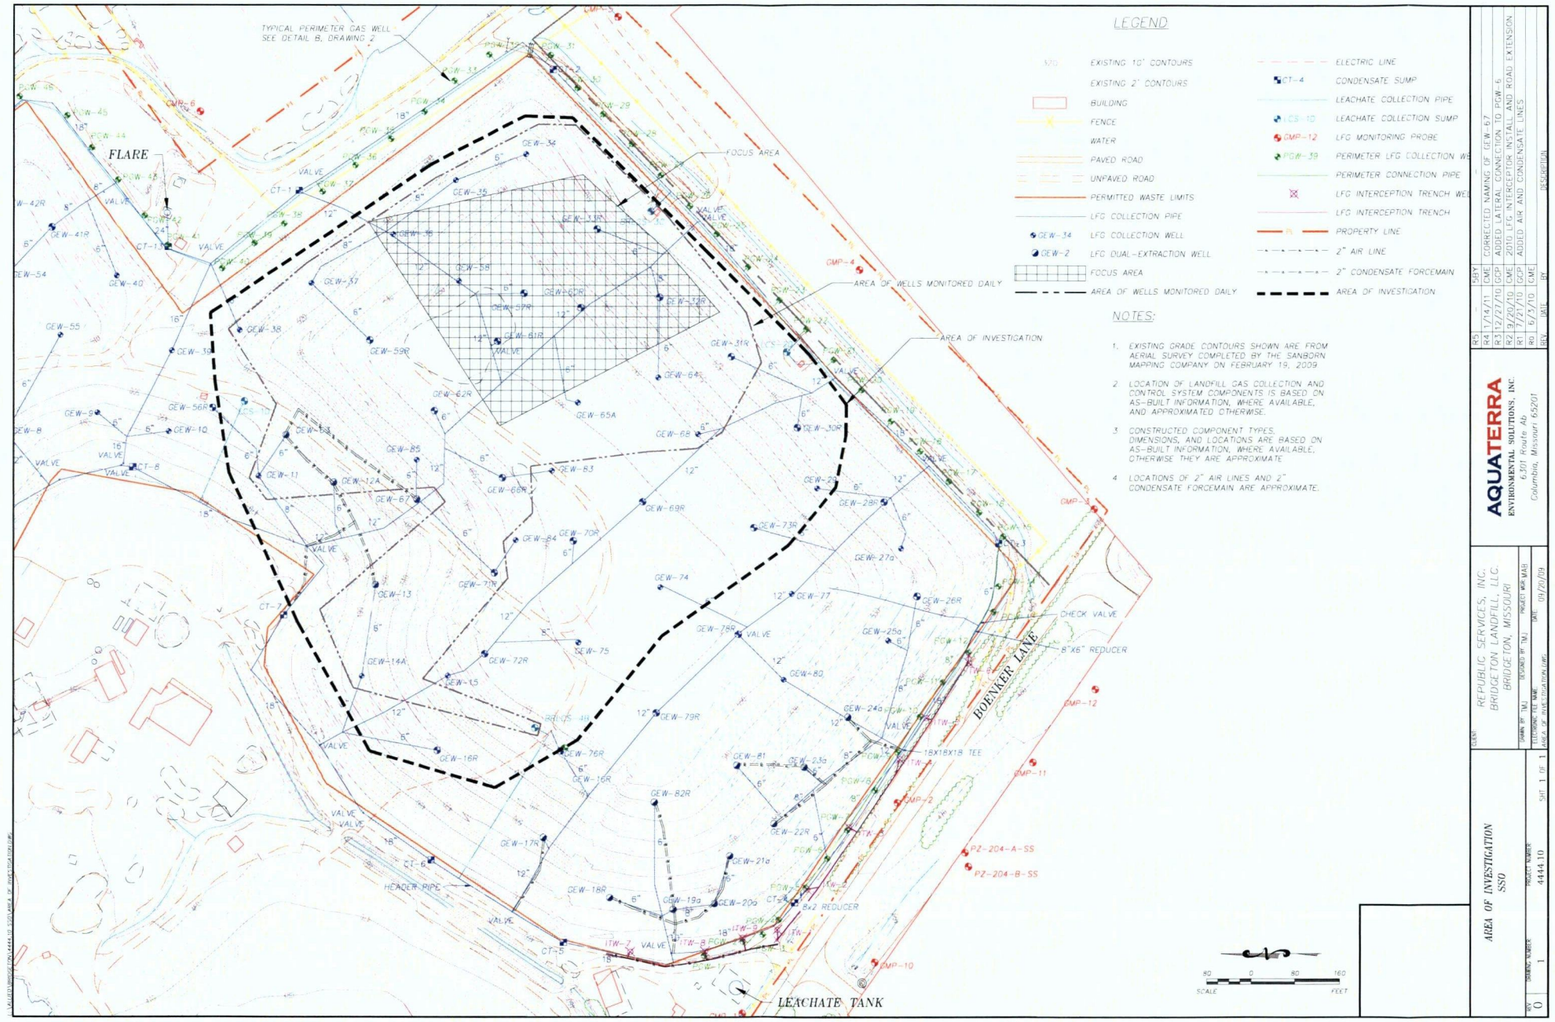

LEGEND

320	EXISTING 10' CONTOURS		ELECTRIC LINE
	EXISTING 2' CONTOURS	CT-4	CONDENSATE SUMP
	BUILDING		LEACHATE COLLECTION PIPE
	FENCE	LCS-10	LEACHATE COLLECTION SUMP
	WATER	GMP-12	LFG MONITORING PROBE
	PAVED ROAD	PGW-39	PERIMETER LFG COLLECTION WE
	UNPAVED ROAD		PERIMETER CONNECTION PIPE
	PERMITTED WASTE LIMITS		LFG INTERCEPTION TRENCH WEL
	LFG COLLECTION PIPE		LFG INTERCEPTION TRENCH
GEW-34	LFG COLLECTION WELL		PROPERTY LINE
GEW-2	LFG DUAL-EXTRACTION WELL		2" AIR LINE
	FOCUS AREA		2" CONDENSATE FORCEMAIN
	AREA OF WELLS MONITORED DAILY		AREA OF INVESTIGATION

NOTES:

1. EXISTING GRADE CONTOURS SHOWN ARE FROM AERIAL SURVEY COMPLETED BY THE SANBORN MAPPING COMPANY ON FEBRUARY 19, 2009.
2. LOCATION OF LANDFILL GAS COLLECTION AND CONTROL SYSTEM COMPONENTS IS BASED ON AS-BUILT INFORMATION, WHERE AVAILABLE, AND APPROXIMATED OTHERWISE.
3. CONSTRUCTED COMPONENT TYPES, DIMENSIONS, AND LOCATIONS ARE BASED ON AS-BUILT INFORMATION, WHERE AVAILABLE, OTHERWISE THEY ARE APPROXIMATE.
4. LOCATIONS OF 2" AIR LINES AND 2" CONDENSATE FORCEMAIN ARE APPROXIMATE.

REV.	DATE	BY	DESCRIPTION
R5	-	SBY	
R4	1/14/11	CME	CORRECTED NAMING OF GEW-67
R3	12/27/10	GCP	ADDED LATERAL CONNECTION TO PGW-6
R2	9/20/10	CME	2010 LFG INTERCEPTOR INSTALL AND ROAD EXTENSION
R1	7/21/10	GCP	ADDED AIR AND CONDENSATE LINES
R0	6/3/10	CME	

AQUATERRA
ENVIRONMENTAL SOLUTIONS, INC.
6301 Route Ab
Columbia, Missouri 65201

CLIENT: REPUBLIC SERVICES, INC.
BRIDGETON LANDFILL, LLC.
BRIDGETON, MISSOURI

DRAWN BY: TMJ | DESIGNED BY: TMJ | PROJECT MGR: MAB
ELECTRONIC FILE NAME: | DATE: 09/20/09
AREA OF INVESTIGATION.DWG

AREA OF INVESTIGATION
SSO

REV 0 | DRAWING NUMBER 1 | PROJECT NUMBER 4444.10 | SHT 1 OF 1

0714 30287593 30

Superfund

0U02