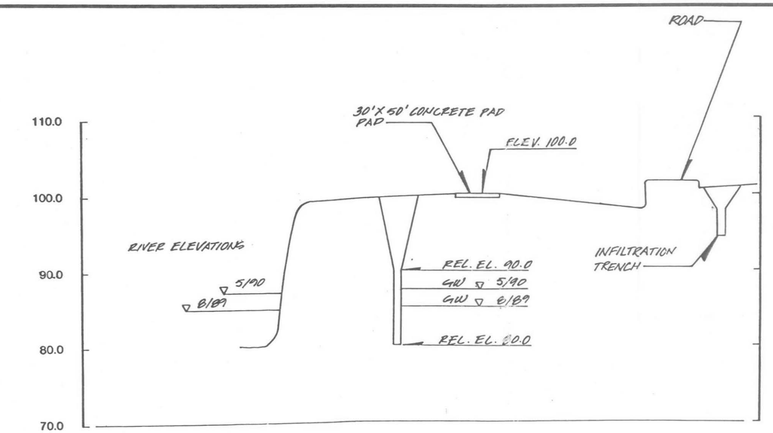

NOTES:

1. REFERENCE POINT FOR RELATIVE ELEVATIONS IS 30'X 50' CONCRETE PAD.
2. THE INSTALLER IS RESPONSIBLE FOR TEMPORARY SHORING AND DEWATERING NECESSARY FOR TRENCH INSTALLATION.
3. EXCAVATED SOIL AND GROUNDWATER MAY CONTAIN PETROLEUM HYDROCARBONS. INSTALLER IS RESPONSIBLE FOR WORKER HEALTH AND SAFETY, AND PROPER SOIL DISPOSAL.

SECTION CS-1 / 2 | 3
NOT TO SCALE

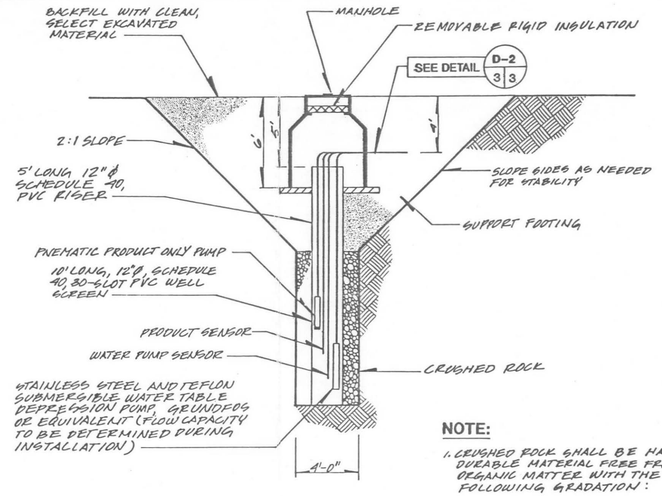

NOTE:

1. CRUSHED ROCK SHALL BE HARD, DURABLE MATERIAL FREE FROM ORGANIC MATTER WITH THE FOLLOWING GRADATION:

US SIEVE SIZE	% FINER
3 INCH	100
1/4 INCH	0-2

SECTION CS-2 / 2 | 3
NOT TO SCALE

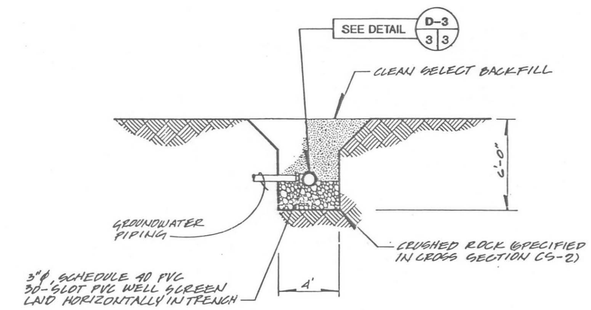

SECTION CS-3 / 2 | 3
NOT TO SCALE

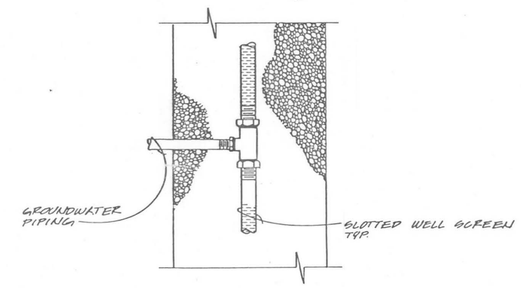

SECTION CONNECTION DETAIL / D-3 / 3 | 3
NOT TO SCALE

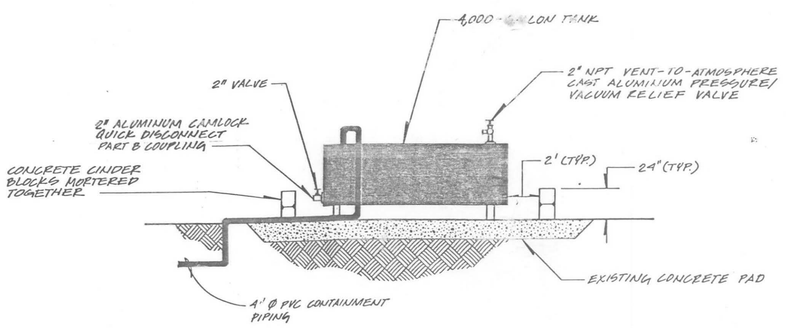

NOTE:

1. ~~CONSTRUCT~~ CONTAINMENT ON ALL SIDES ~~OF TANK~~ (LONG SIDES ~~OF CONTAINMENT~~ NOT SHOWN IN DRAWING)

ACTUAL CONTAINMENT CONSTRUCTED USING EARTHEN BERMS

TANK AND CONTAINMENT DETAIL / D-1 / 2 | 3
NOT TO SCALE

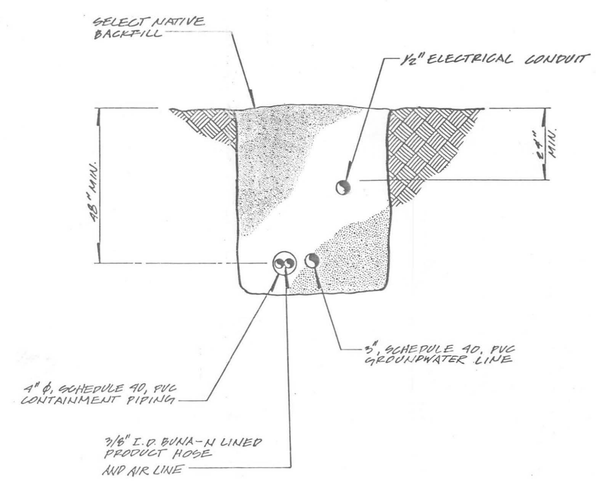

TRENCH DETAIL / D-2 / 3 | 3
NOT TO SCALE

BENCHMARK:

DESIGNED BY: J.A. HEST | CHECKED BY: D.G. WINTER
DRAWN BY: JUAN A. HERNANDEZ | CHECKED BY: B.L. KELLEMS

NO.	DATE	BY	REVISION

HARTCROWSER
Hart Crowser, Inc.
1910 Fairview Avenue East
Seattle, Washington 98102-3699
206.324.9530

FREE PRODUCT RECOVERY SYSTEM

CROSS SECTION / DETAILS

POTLATCH CORPORATION

TYPE DRAWING: FINAL CONST. RECORD ×
DATE: 12/16/94
JOB NO. 2296-05
SHEET 3 OF 3 SHEETS