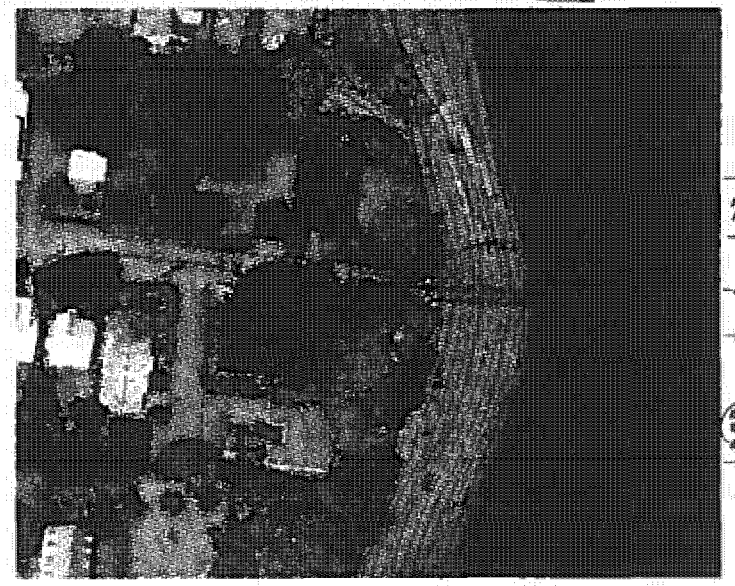

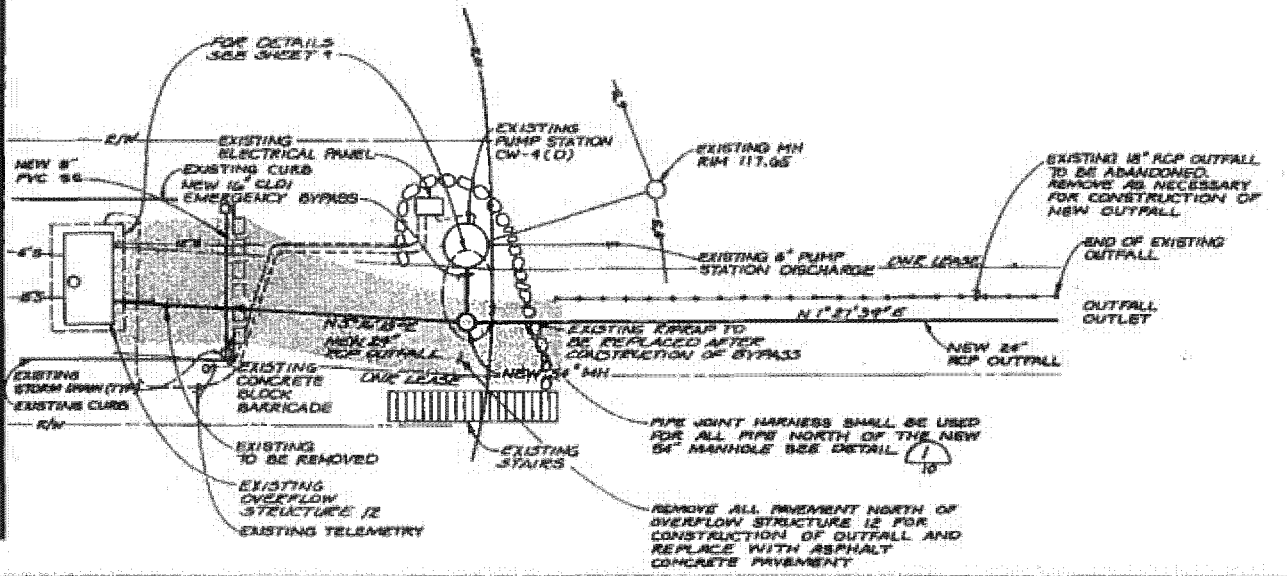

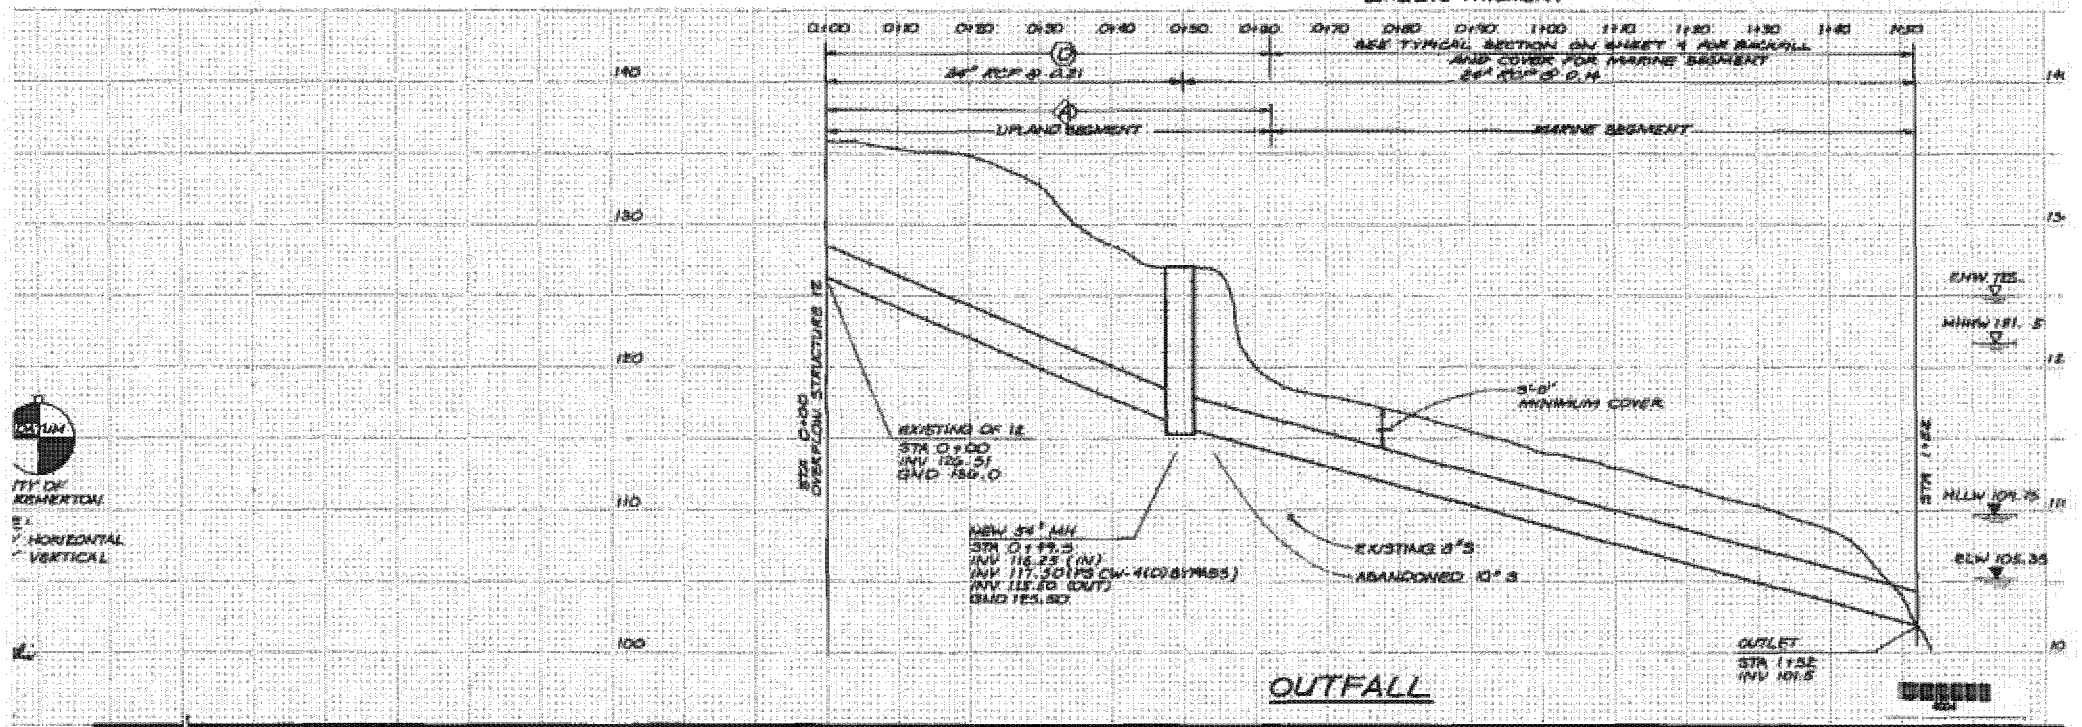

CHIN HILL	DESIGN M. GRANT DR C. BROWN CHK M.H.L.A.L.L. APPR J. GAITHER	10-10-08	RECORD DRAWING	TMJ	MJAG	
		NO.	DATE	REVISION	BY	APVD

REUSE OF DOCUMENTS

THIS DOCUMENT, AND THE IDEAS AND DESIGNS INCORPORATED HEREIN, AS AN INSTRUMENT OF PROFESSIONAL SERVICE, IS THE PROPERTY OF CHIN HILL AND IS NOT TO BE USED, IN WHOLE OR IN PART, FOR ANY OTHER PROJECT WITHOUT THE WRITTEN AUTHORIZATION OF CHIN HILL.

BAR IS ONE INCH ON ORIGINAL DRAWING. 0 1" IF NOT ONE INCH ON THIS SHEET, ADJUST SCALES ACCORDINGLY

CITY OF BREMERTON, WASHINGTON
BEACH PIPELINE AND STORM SEWER OUTFALL

PLAN AND PROFILE
STORM SEWER OUTFALL
AT OHIO AVENUE

SHEET 6 OF
DATE JULY 1
PROJ NO. 812400

DNR-00001699

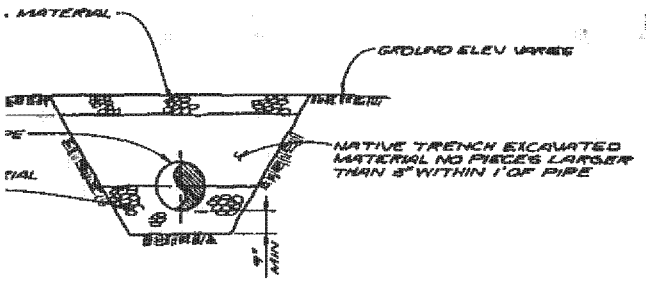

BURIED
NTS

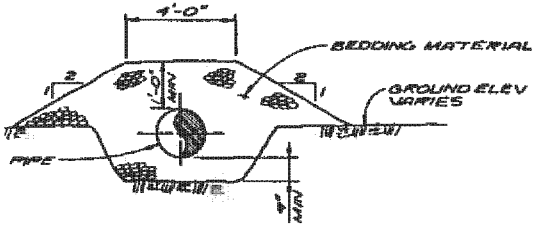

PARTIALLY EXPOSED
NTS

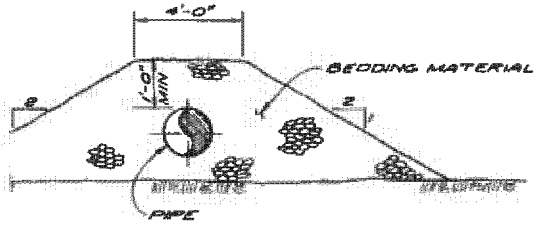

EXPOSED
NTS

FALL MARINE SEGMENT
CAL SECTIONS

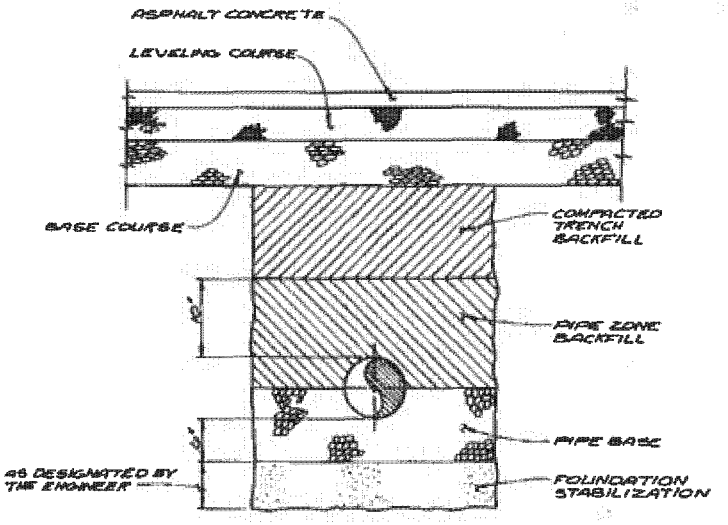

OUTFALL UPLAND SEGMENT
TYPICAL SECTION

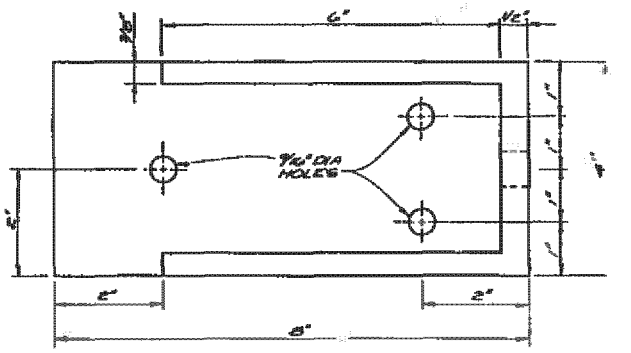

PLATE PLAN
NTS

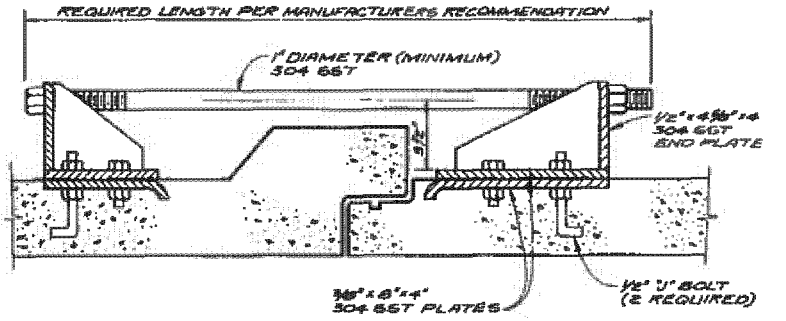

SECTION

PIPE JOINT HARNESS DETAIL 1/8
NTS

CH2M HILL

DESIGN M. GRANT
CHK CM BLACKWELL
APPD J. GAUTHIER

NO.	DATE	REVISION	BY	APVD
1	10-10-86	RECORD DRAWING	WJM	JAB

REUSE OF DOCUMENTS
THIS DOCUMENT, AND THE IDEAS AND DESIGNS INCORPORATED HEREIN, AS AN INSTRUMENT OF PROFESSIONAL SERVICE, IS THE PROPERTY OF CH2M HILL AND IS NOT TO BE USED, IN WHOLE OR IN PART, FOR ANY OTHER PROJECT WITHOUT THE WRITTEN AUTHORIZATION OF CH2M HILL.
©CH2M HILL

BAR IS ONE INCH ON ORIGINAL DRAWING. 0 1" IF NOT ONE INCH ON THIS SHEET, ADJUST SCALES ACCORDINGLY.

CITY OF BREMERTON, WASHINGTON
BEACH PIPELINE AND STORM SEWER OUTFALL

MISCELLANEOUS DETAILS
STORM SEWER OUTFALL

SHEET 10 OF
DATE JULY, 1
PROJ NO. 512400

DNR-00001700