2-4-98
as built

0.7 CY

8.9 SY

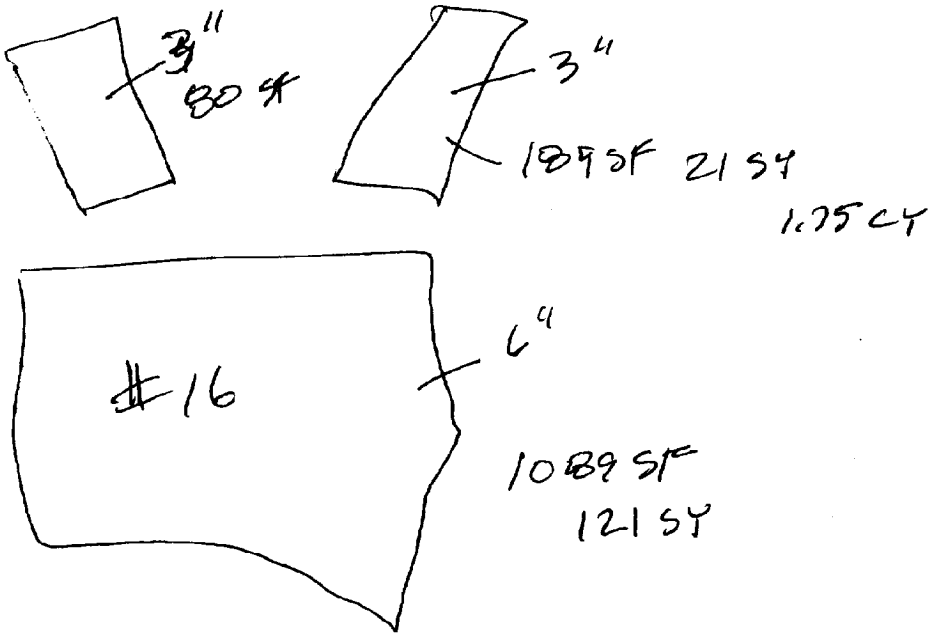

19.3 CY asph removal

90 SY Fanno bid
77
167

150.9 SY asphalt paving
5.7
145.2 SY

exp lids

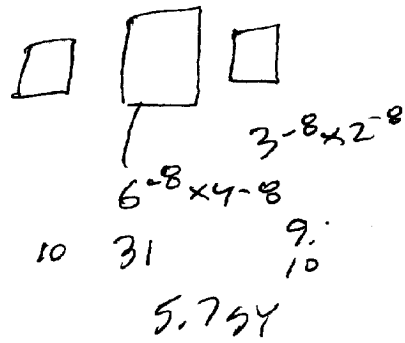

KCSlip4 52833

SEA419193