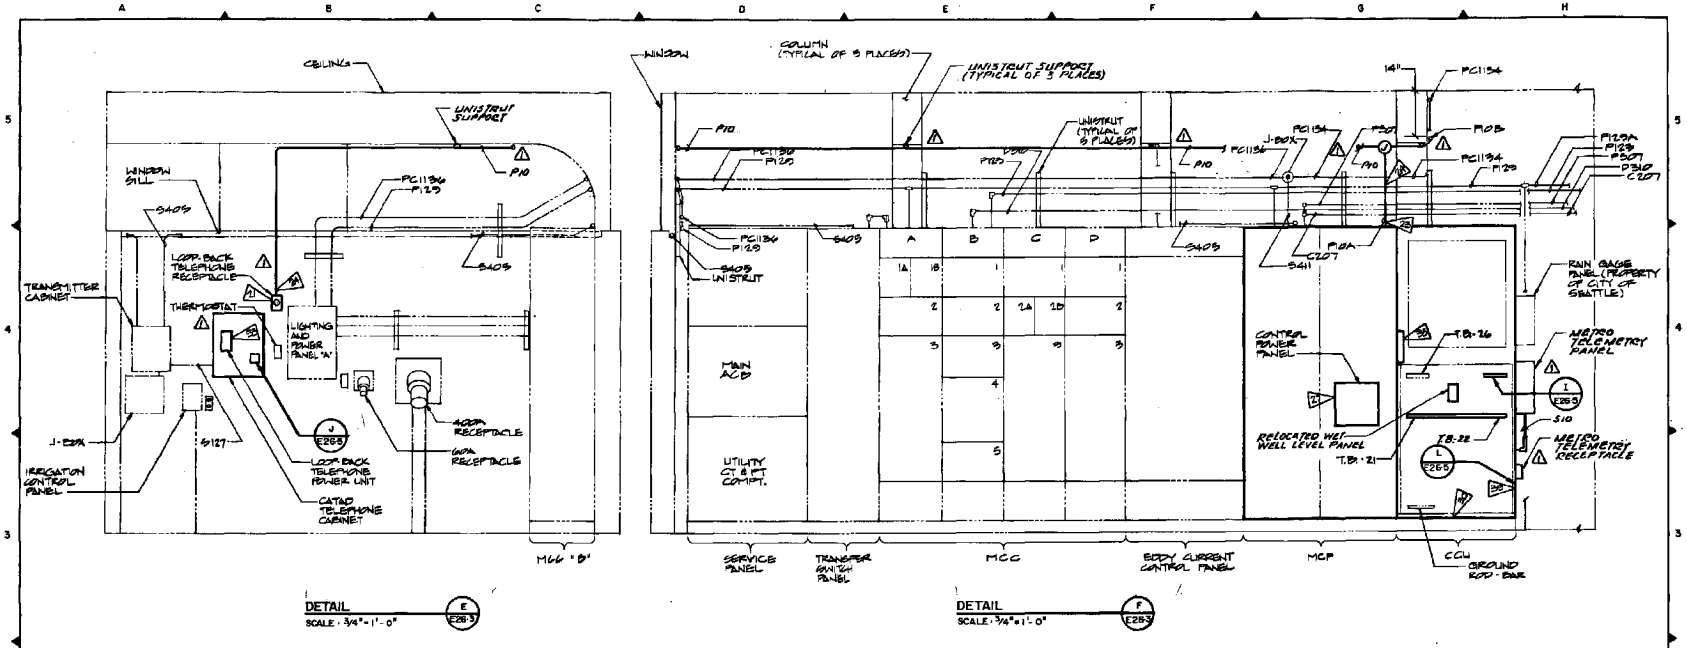

LEGEND

——— EXISTING EQUIPMENT AND INSTALLATION, SHOWN FOR REFERENCE.

——— ITEMS TO BE REMOVED OR EFFECTED BY CONTRACT.

AS BUILT
DATE MARCH '87

117444

NO	REVISION	BY	DATE
1	AS BUILT	GJF	3/87

DESIGNED: GJF
DRAWN: RWG
CHECKED:
RECOMMENDED:
APPROVED:
SCALE: AS-SHOWN

METRO Municipality of Metropolitan Seattle

SCADA OFF-SITE MODIFICATIONS
EAST MARGINAL WAY P.S.
ELECTRICAL DETAILS IV

DATE NOV. 1987
FILE NO. 0-13
DWG NO.
DRAWING NO. E26-4
SHEET 4 OF 5

KCSlip4 61577

SEA429942