St. Maries Realty

3-6-12

info@stmariesrealty.com

Earl-

As promised - sketches of how the cabin was built. Also, the sketch of the layout on the property that was part of the info for my building permit.

Thanks,
Larry

726 Main Avenue St. Maries, Idaho 83861 Phone: (208) 245-4502 info@stmariesrealty.com

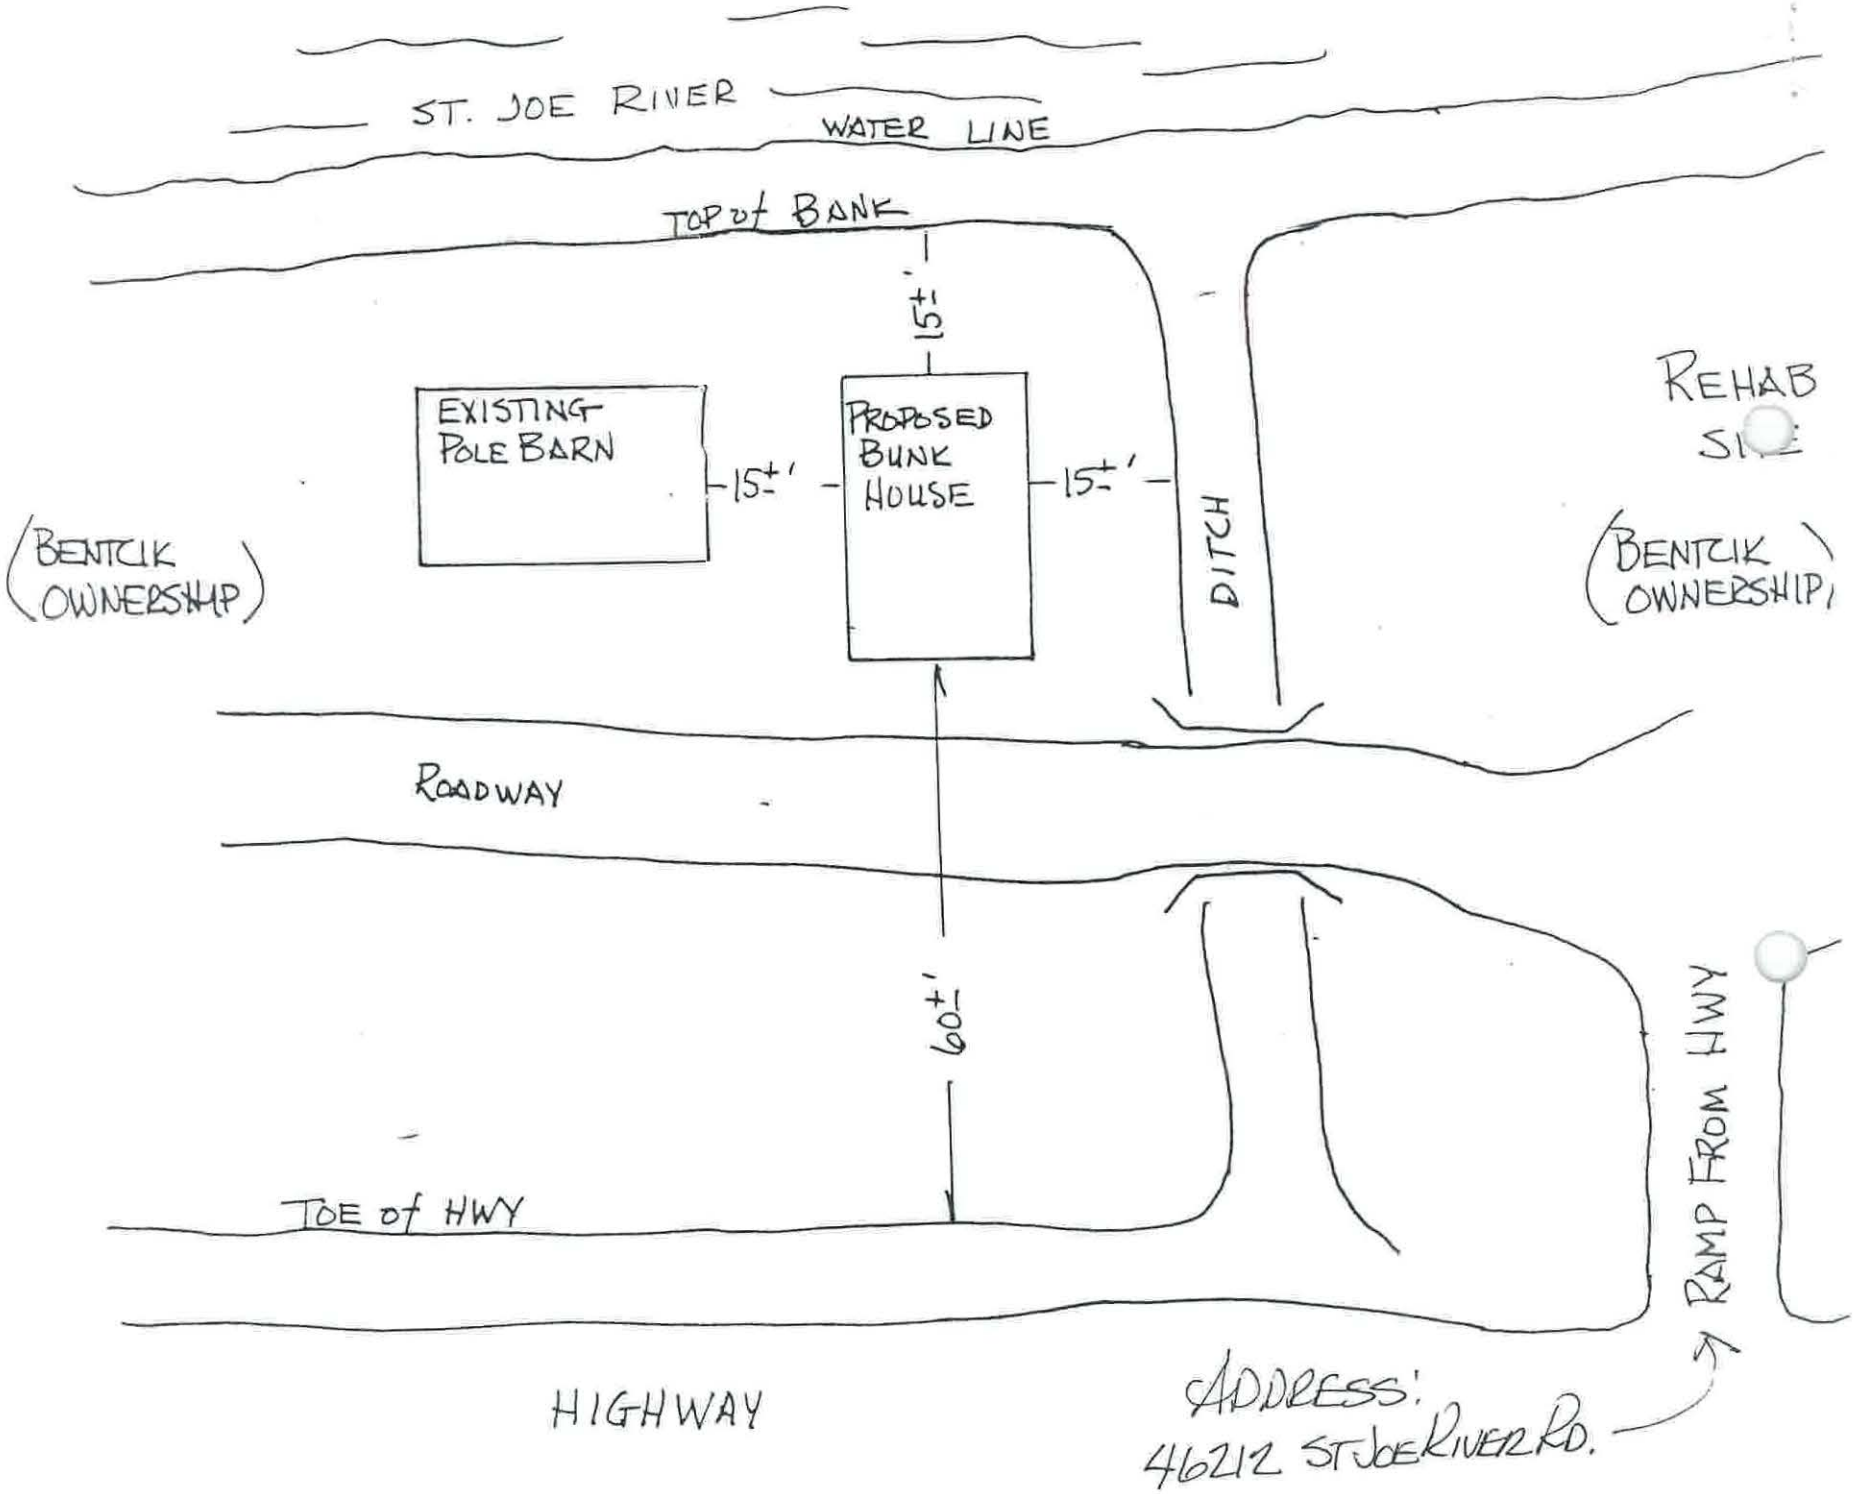
ST. JOE RIVER
WATER LINE
TOP of BANK
15±'
EXISTING POLE BARN
15±'
PROPOSED BUNK HOUSE
15±'
DITCH
REHAB SITE
(BENTCIK OWNERSHIP)
(BENTCIK OWNERSHIP)
ROADWAY
60±'
TOE of HWY
RAMP FROM HWY
HIGHWAY
ADDRESS:
46212 ST JOE RIVER RD.

9

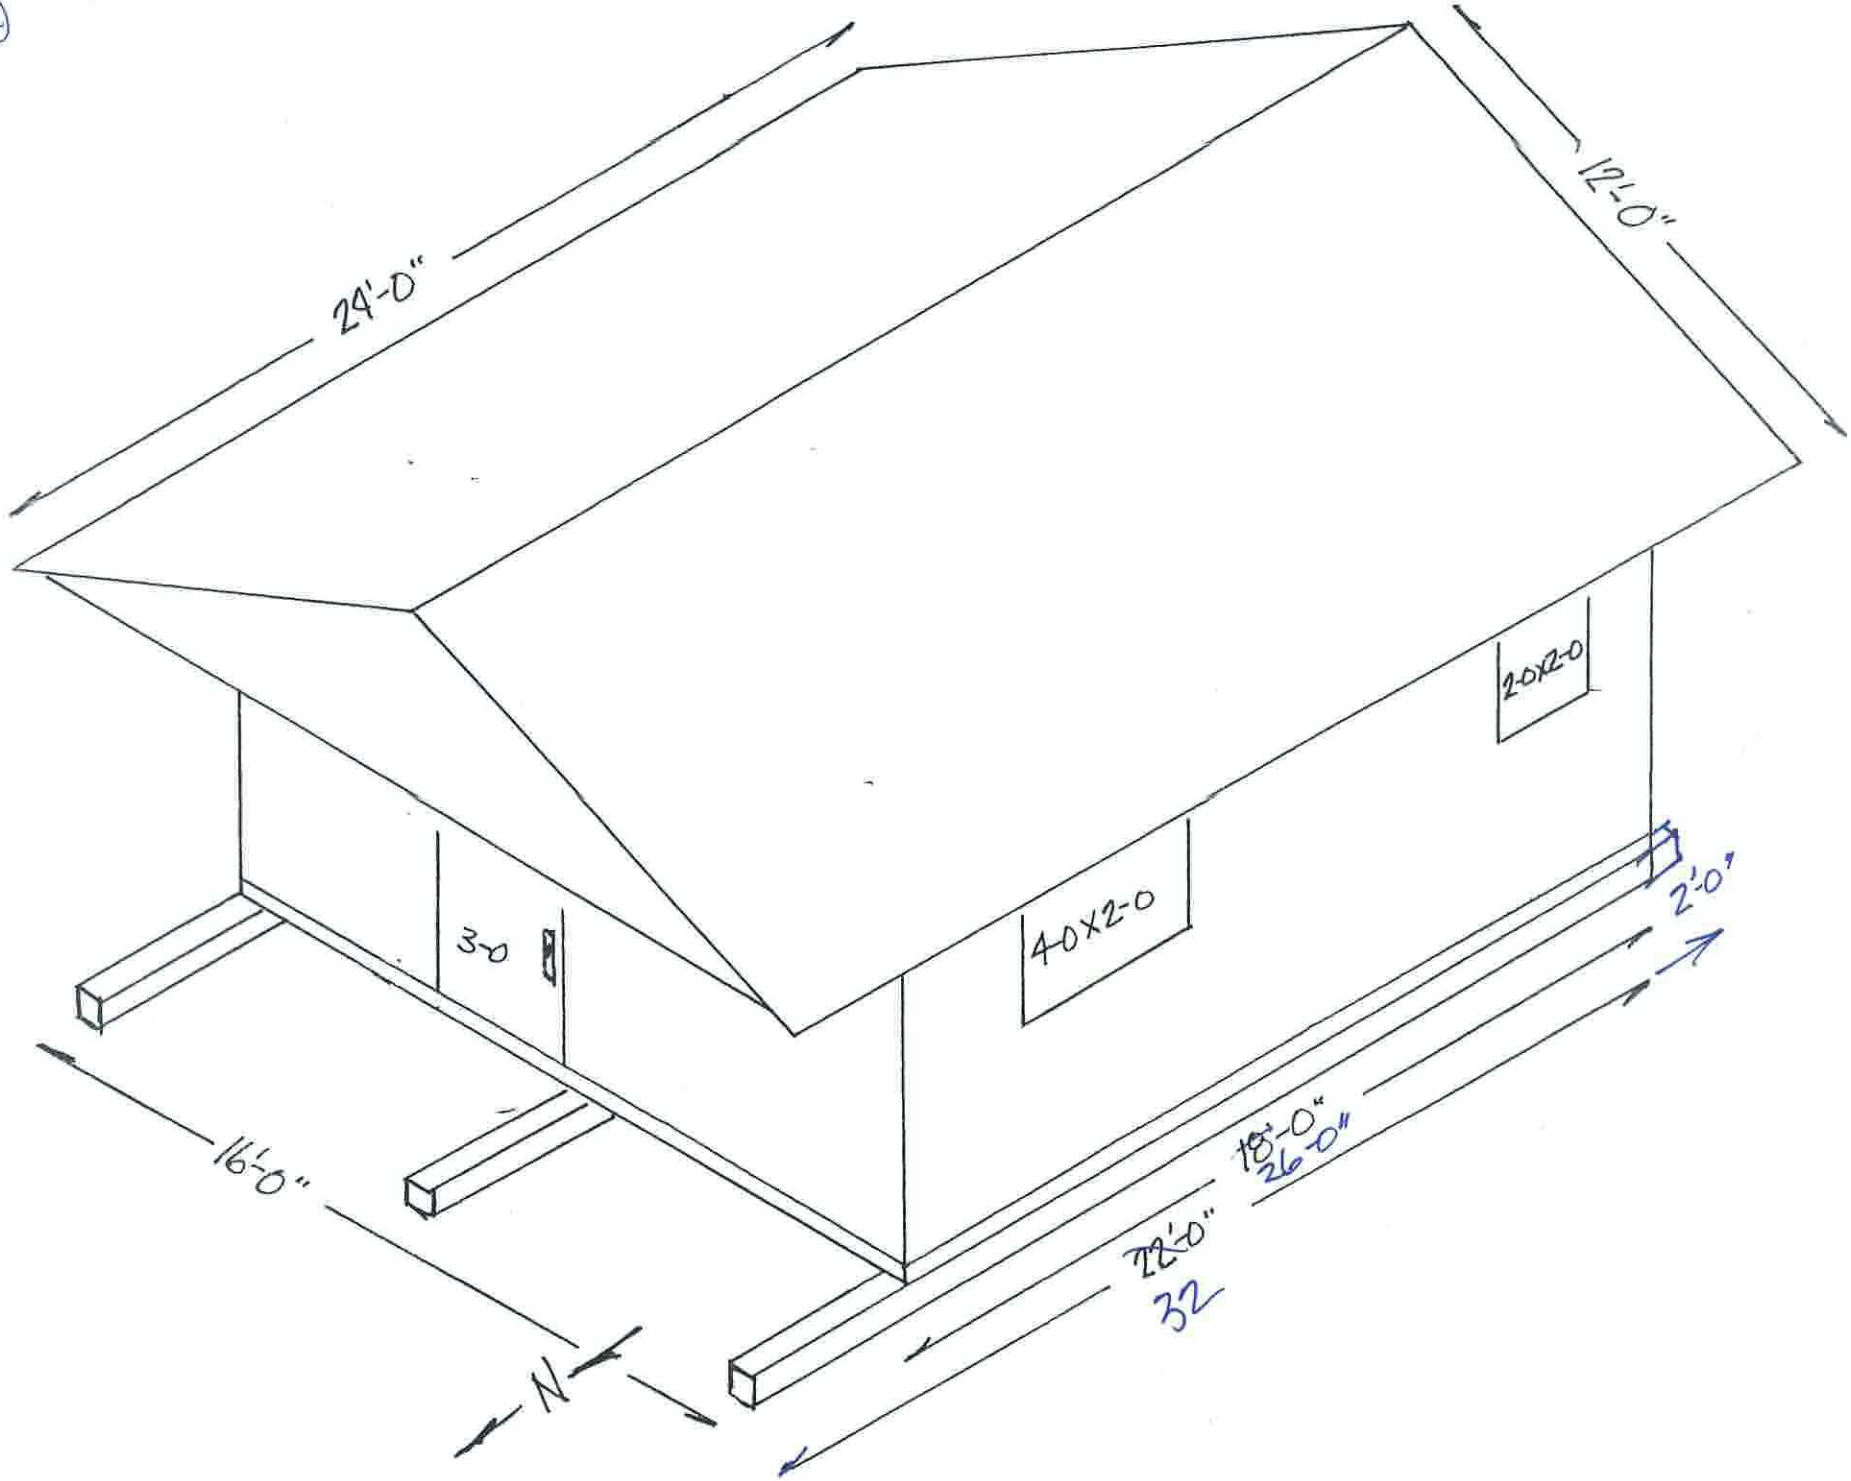

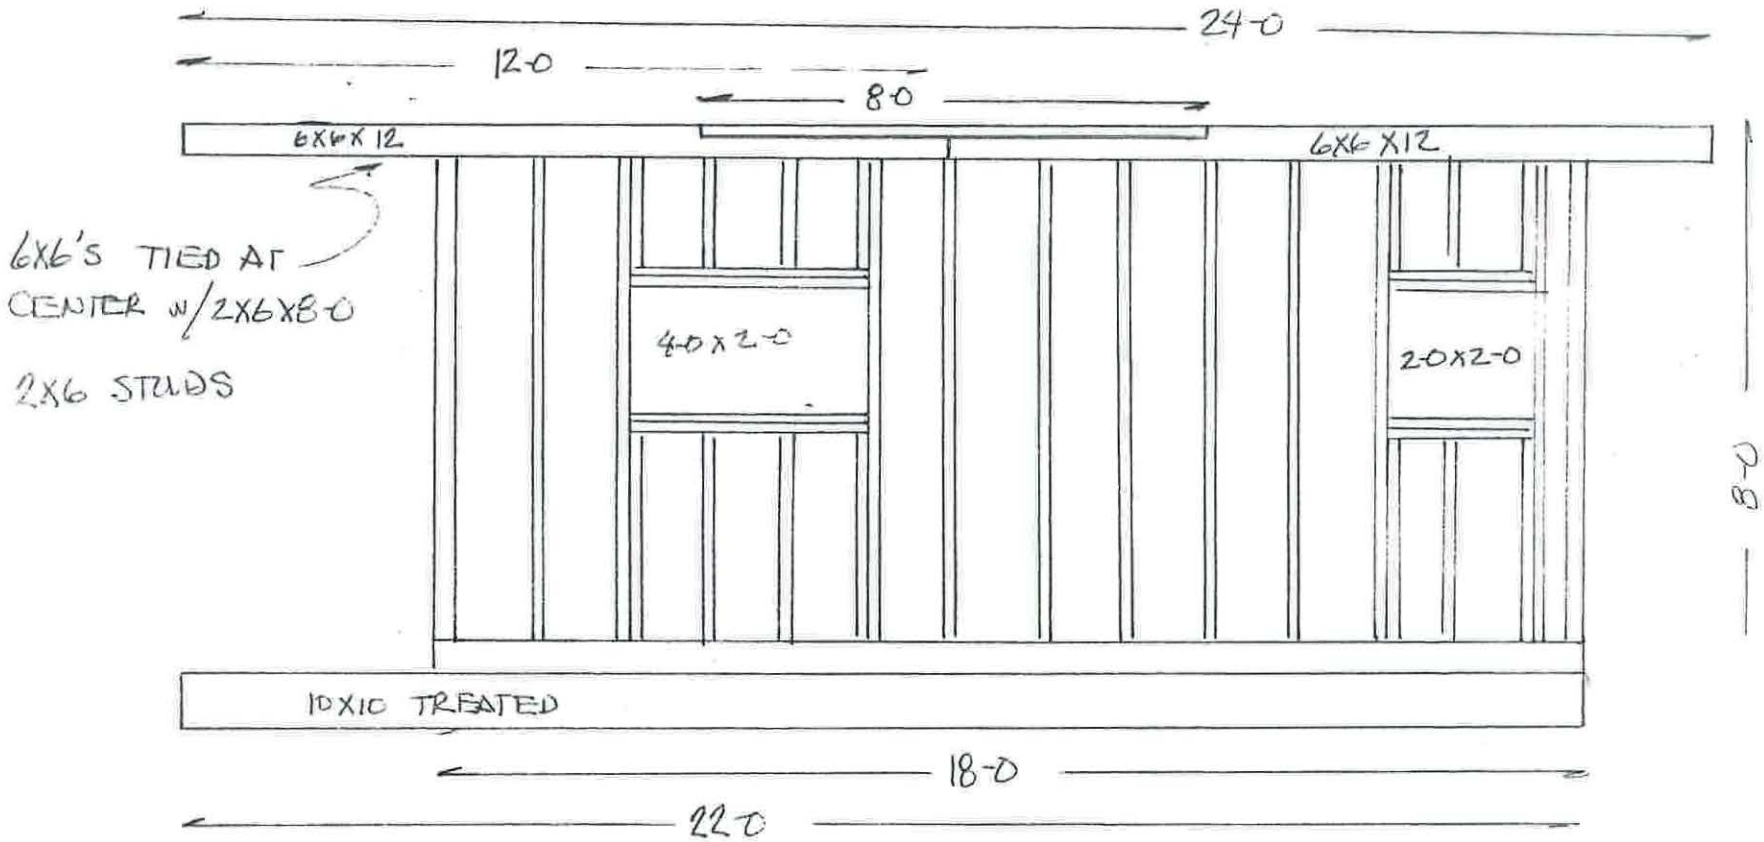

WALL CONSTRUCTION

WEST VIEW
(EAST IDENTICAL)

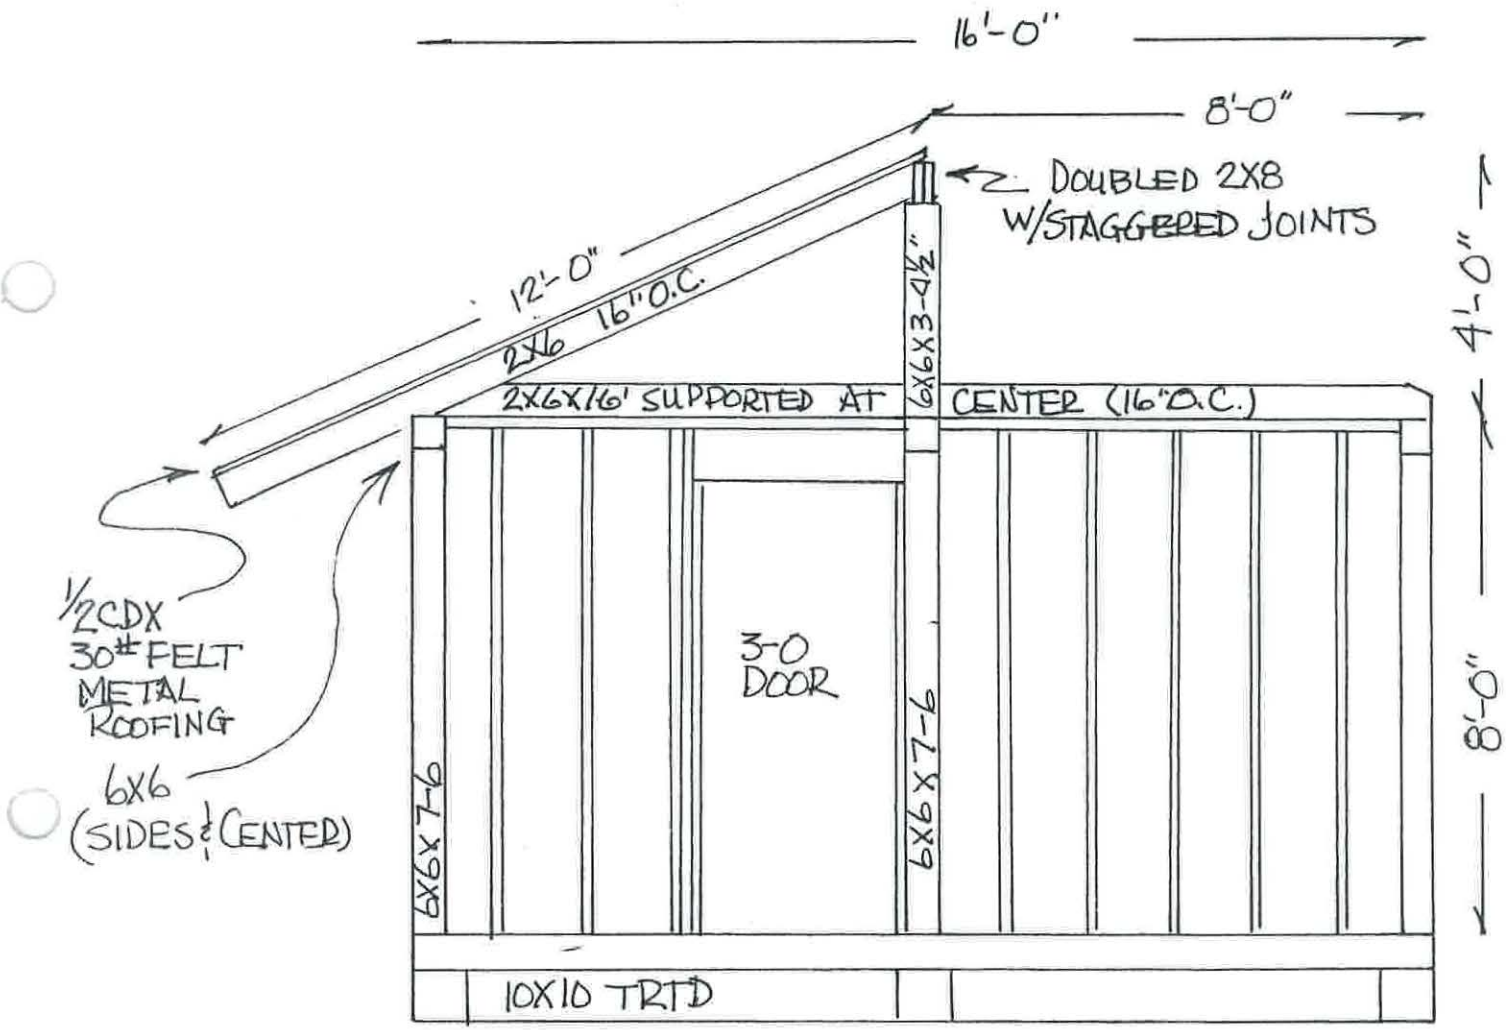

NORTH VIEW
(SOUTH IDENTICAL)

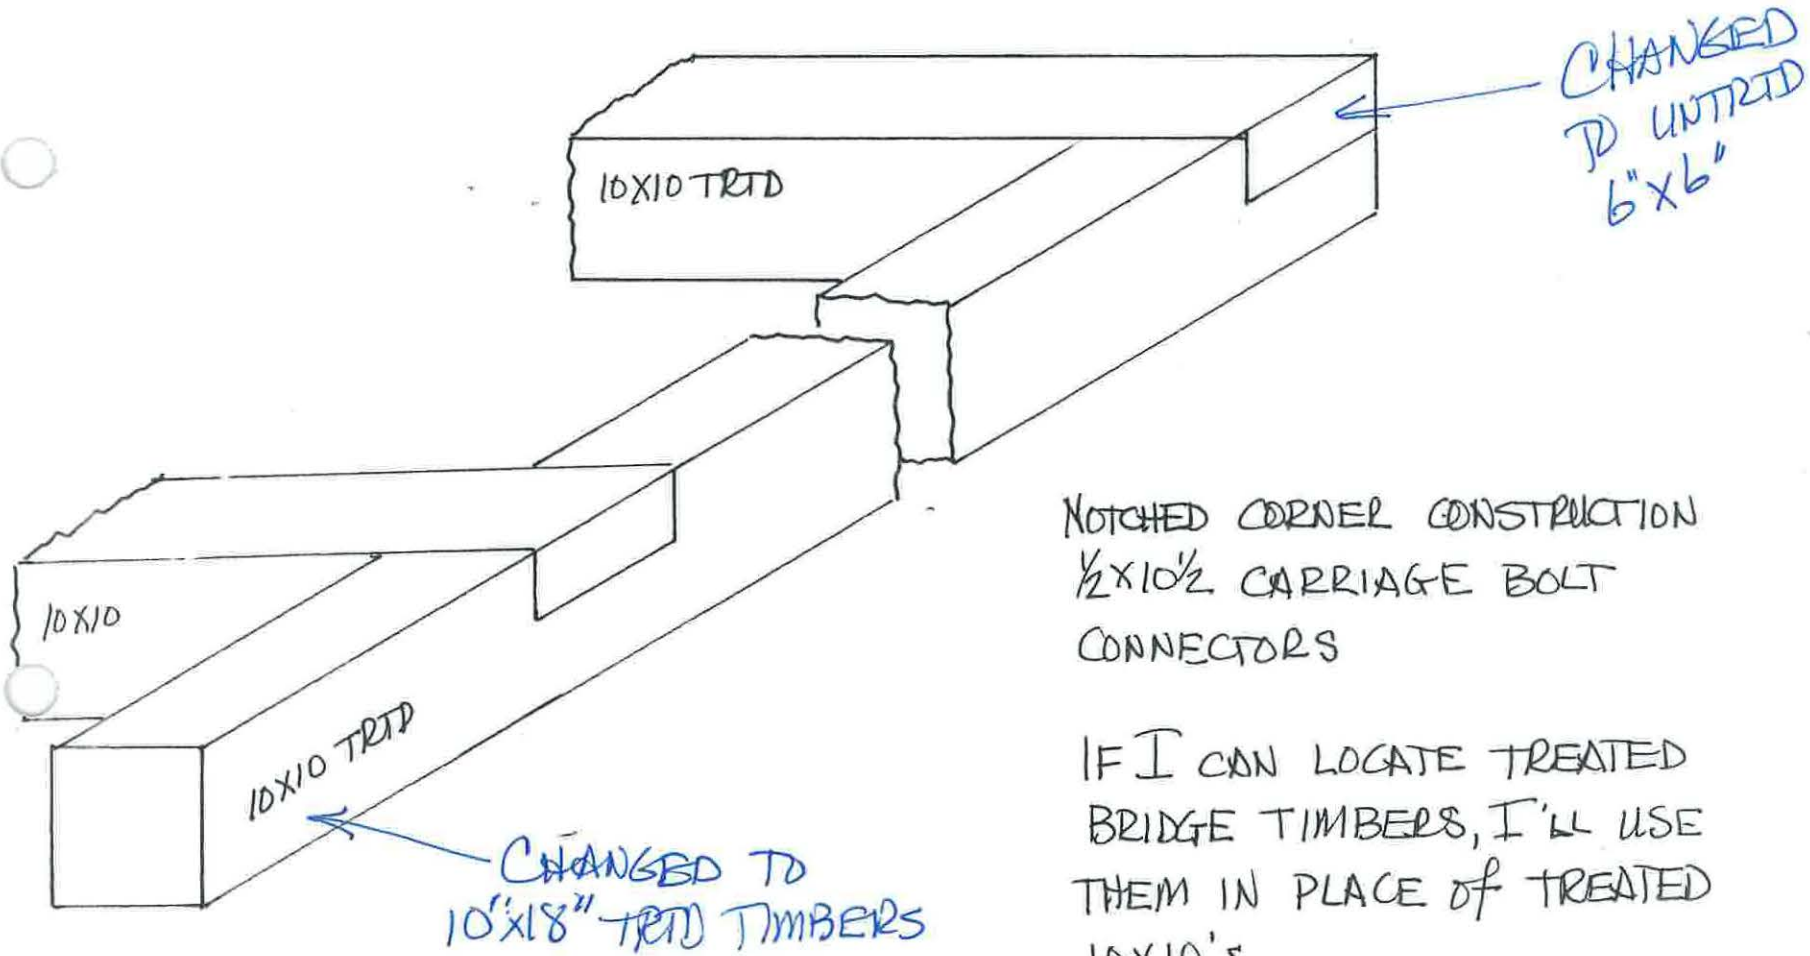

NOTCHED CORNER CONSTRUCTION
½X10½ CARRIAGE BOLT
CONNECTORS

IF I CAN LOCATE TREATED BRIDGE TIMBERS, I'LL USE THEM IN PLACE of TREATED 10X10'S.

~~LONG 4X4 CROSS BRACING WILL BE NOTCHED SIMILAR TO THIS CORNER CONSTRUCTION~~