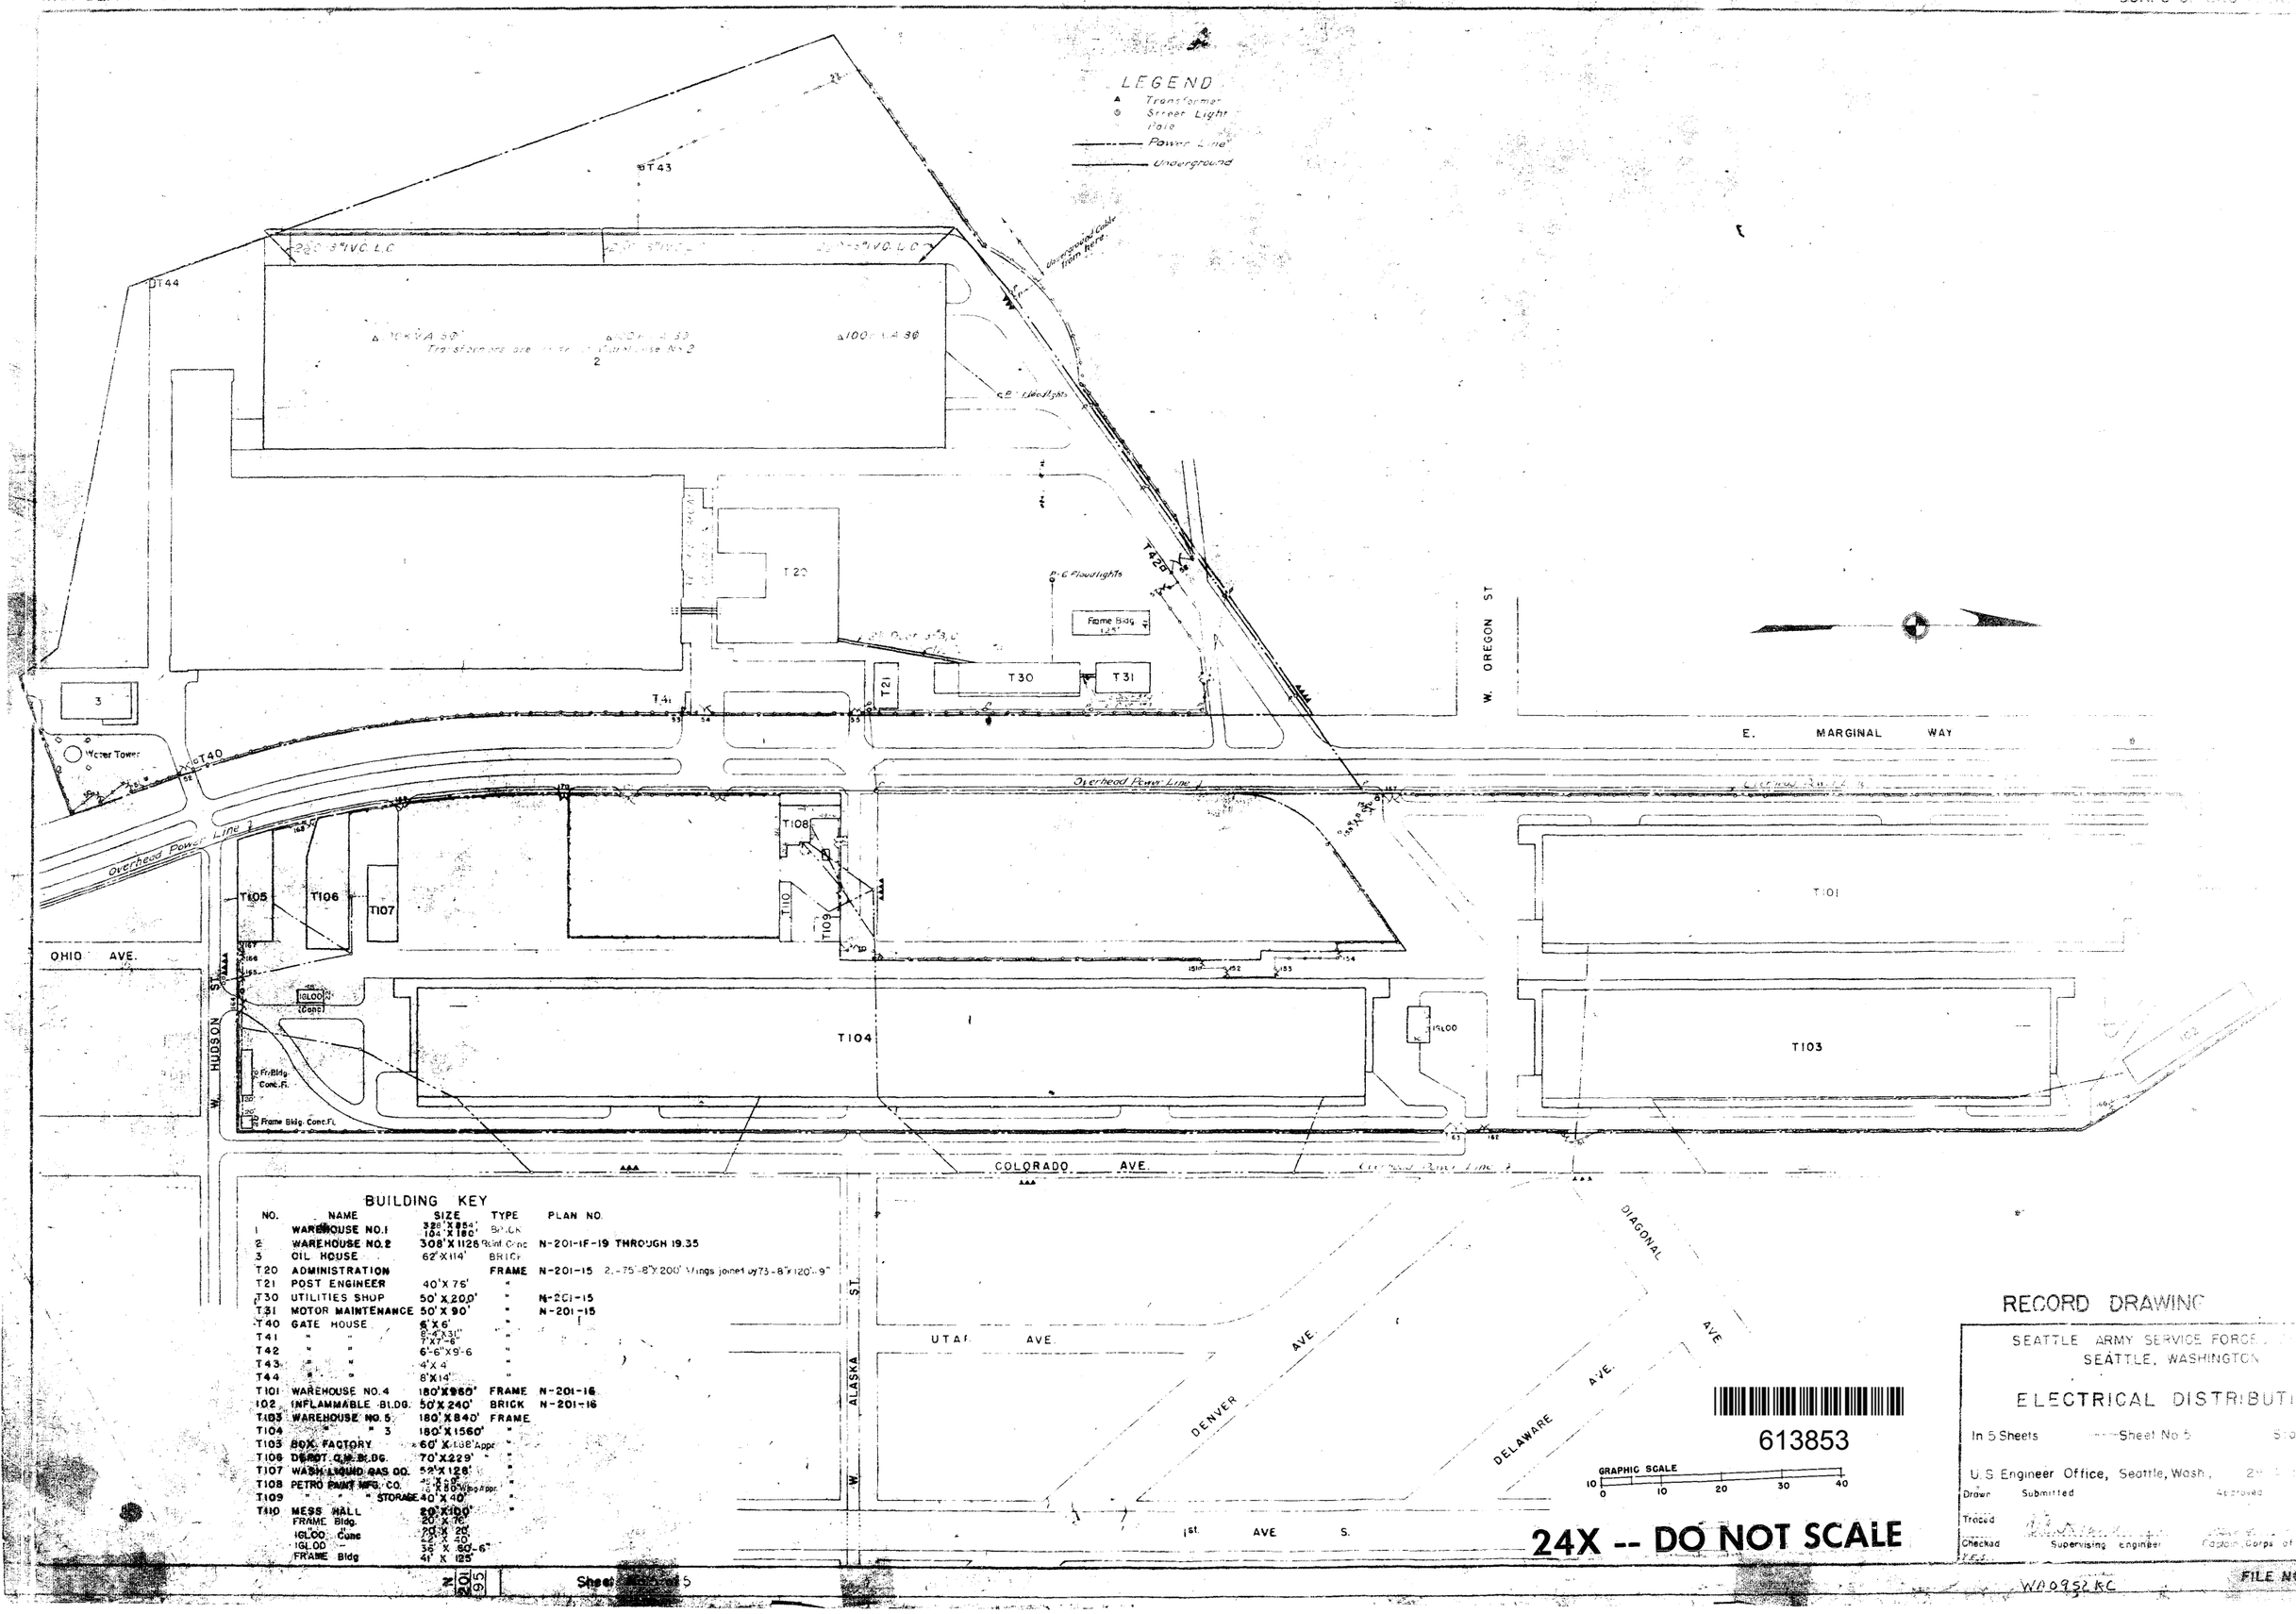

BUILDING KEY

NO.	NAME	SIZE	TYPE	PLAN NO.
1	WAREHOUSE NO.1	328'X854' 104'X180'	BRICK	
2	WAREHOUSE NO.2	308'X1128	Reinf. Conc	N-201-1F-19 THROUGH 19.35
3	OIL HOUSE	62'X114'	BRICK	
T20	ADMINISTRATION		FRAME	N-201-15 2.-75'-8"X200' Wings joined by 73-8"X120'-9"
T21	POST ENGINEER	40'X76'	"	
T30	UTILITIES SHOP	50'X200'	"	N-201-15
T31	MOTOR MAINTENANCE	50'X90'	"	N-201-15
T40	GATE HOUSE	6'X6'	"	
T41	" "	8'-4"X31" 7'X7'-6"	"	
T42	" "	6'-6"X9'-6	"	
T43	" "	4'X4'	"	
T44	" "	8'X14'	"	
T101	WAREHOUSE NO.4	180'X960'	FRAME	N-201-16
102	INFLAMMABLE BLDG.	50'X240'	BRICK	N-201-16
T103	WAREHOUSE NO.5	180'X840'	FRAME	
T104	" " 3	180'X1560'	"	
T105	BOX FACTORY	60'X168' Appr	"	
T106	DEPOT Q.M. BLDG.	70'X229'	"	
T107	WASH LIQUID GAS CO.	52'X128'	"	
T108	PETRO PAINT MFG. CO.	45'X40' 16'X50' Wing Appr.	"	
T109	" " " STORAGE	40'X40'	"	
T110	MESS HALL	20'X100'	"	
	FRAME Bldg.	20'X76'		
	IGLOO Conc	20'X20'		
	IGLOO "	22'X40'		
	FRAME Bldg	36'X60'-6" 41'X125'		

613853

24X -- DO NOT SCALE

RECORD DRAWING

SEATTLE ARMY SERVICE FORCES
SEATTLE, WASHINGTON

ELECTRICAL DISTRIBUTION

In 5 Sheets — Sheet No 5 — Scale

U.S. Engineer Office, Seattle, Wash., 29 [illegible] 1945

Drawn Submitted Approved

Traced

Checked Supervising Engineer Captain, Corps of Engineers

458

FILE NO. N-201-95

WA0952KC

Sheet No. 5 of 5