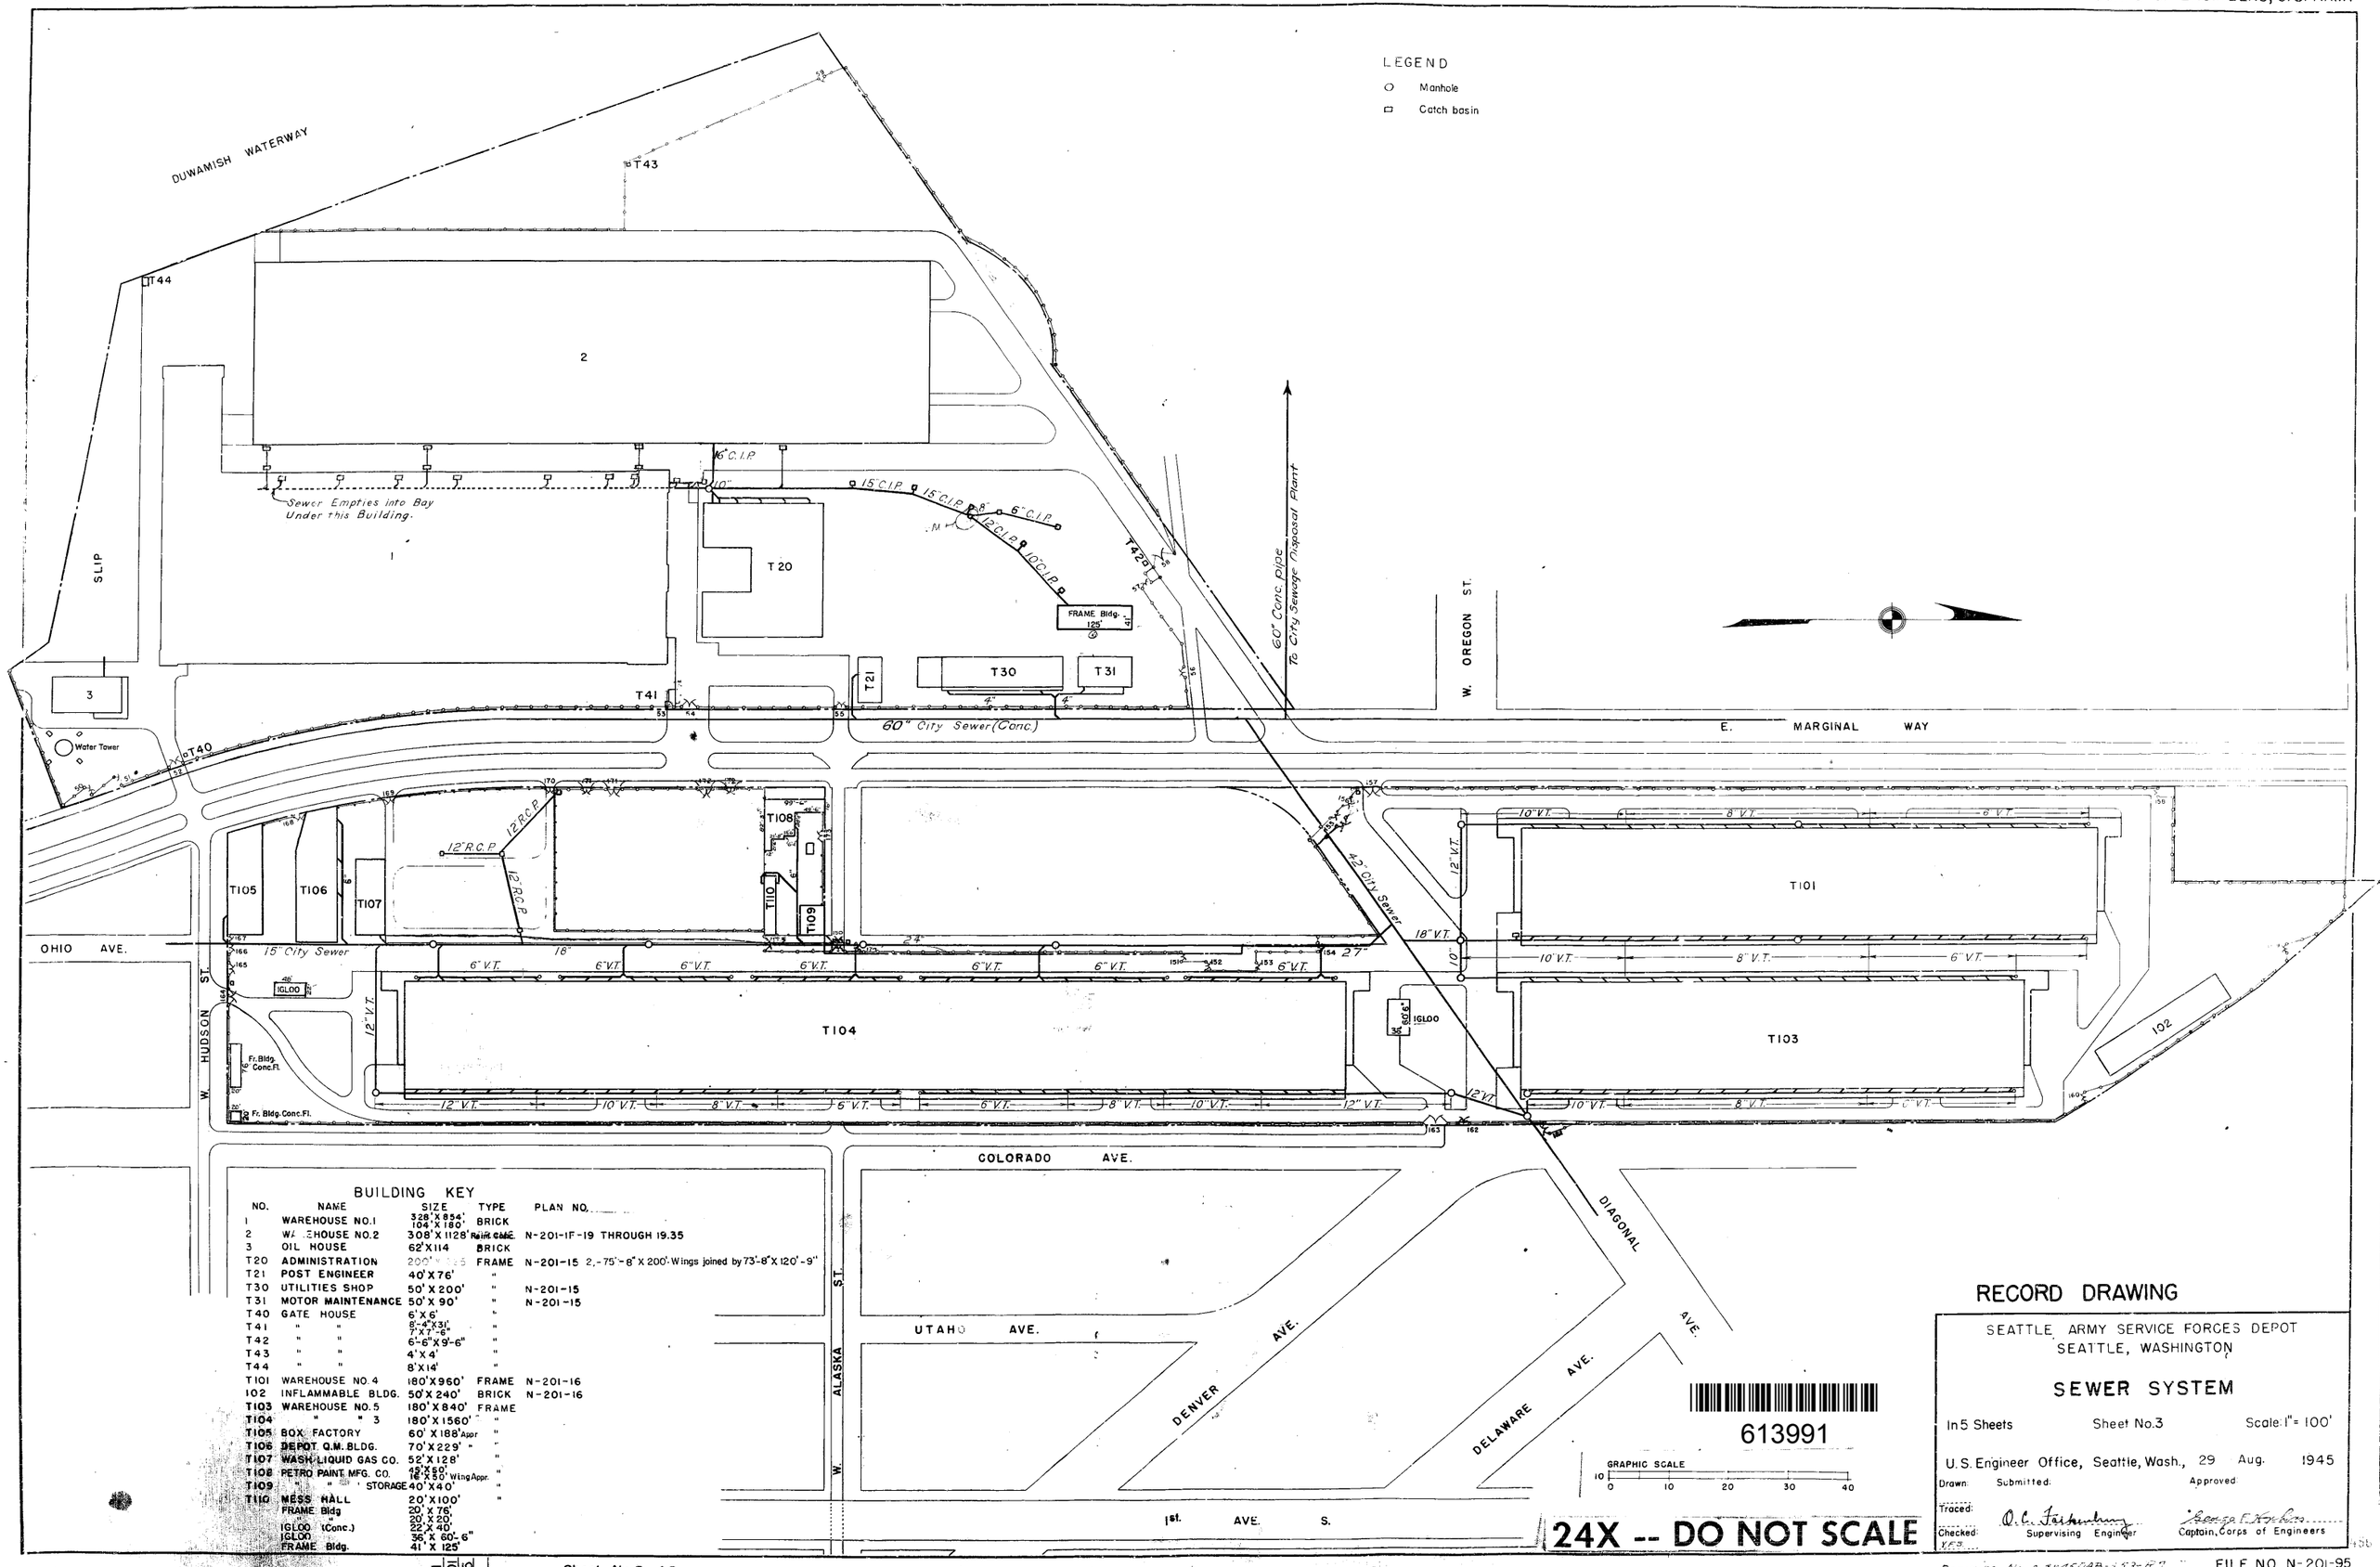

BUILDING KEY

NO.	NAME	SIZE	TYPE	PLAN NO.
1	WAREHOUSE NO.1	328'X 854' 104'X 180'	BRICK	
2	WAREHOUSE NO.2	308'X 1128'	Reinf. Conc.	N-201-1F-19 THROUGH 19.35
3	OIL HOUSE	62'X114	BRICK	
T20	ADMINISTRATION	200'X 125	FRAME	N-201-15 2,-75'-8" X 200'-Wings joined by 73'-8" X 120'-9"
T21	POST ENGINEER	40'X 76'	"	
T30	UTILITIES SHOP	50' X 200'	"	N-201-15
T31	MOTOR MAINTENANCE	50' X 90'	"	N-201-15
T40	GATE HOUSE	6'X 6'	"	
T41	" "	6'-4"X3'-1" 7'X 7'-6"	"	
T42	" "	6'-6"X 9'-6"	"	
T43	" "	4'X 4'	"	
T44	" "	8'X14'	"	
T101	WAREHOUSE NO. 4	180'X960'	FRAME	N-201-16
102	INFLAMMABLE BLDG.	50'X 240'	BRICK	N-201-16
T103	WAREHOUSE NO. 5	180' X 840'	FRAME	
T104	" " 3	180' X 1560'	"	
T105	BOX FACTORY	60' X 188' Appr.	"	
T106	DEPOT Q.M. BLDG.	70' X 229'	"	
T107	WASH. LIQUID GAS CO.	52' X 128'	"	
T108	PETRO PAINT MFG. CO.	45' X 60' 16' X 50' Wing Appr.	"	
T109	" " " STORAGE	40' X 80'	"	
T110	MESS HALL	20' X 100'	"	
	FRAME Bldg	20' X 76'		
	" "	20' X 20'		
	IGLOO (Conc.)	22' X 40'		
	IGLOO	36' X 60'-6"		
	FRAME Bldg.	41' X 125'		

N 201 95

Sheet No.3 of 5

613991

24X -- DO NOT SCALE

RECORD DRAWING

SEATTLE ARMY SERVICE FORCES DEPOT
SEATTLE, WASHINGTON

SEWER SYSTEM

In 5 Sheets | Sheet No.3 | Scale: 1" = 100'

U.S. Engineer Office, Seattle, Wash., 29 Aug. 1945

Drawn: Submitted: Approved:

Traced: O. C. Fastenburg

Checked: Supervising Engineer — George E. Kocher, Captain, Corps of Engineers

WA09 57KC Drawing No. 8.2945DAB-153-F7

FILE NO. N-201-95