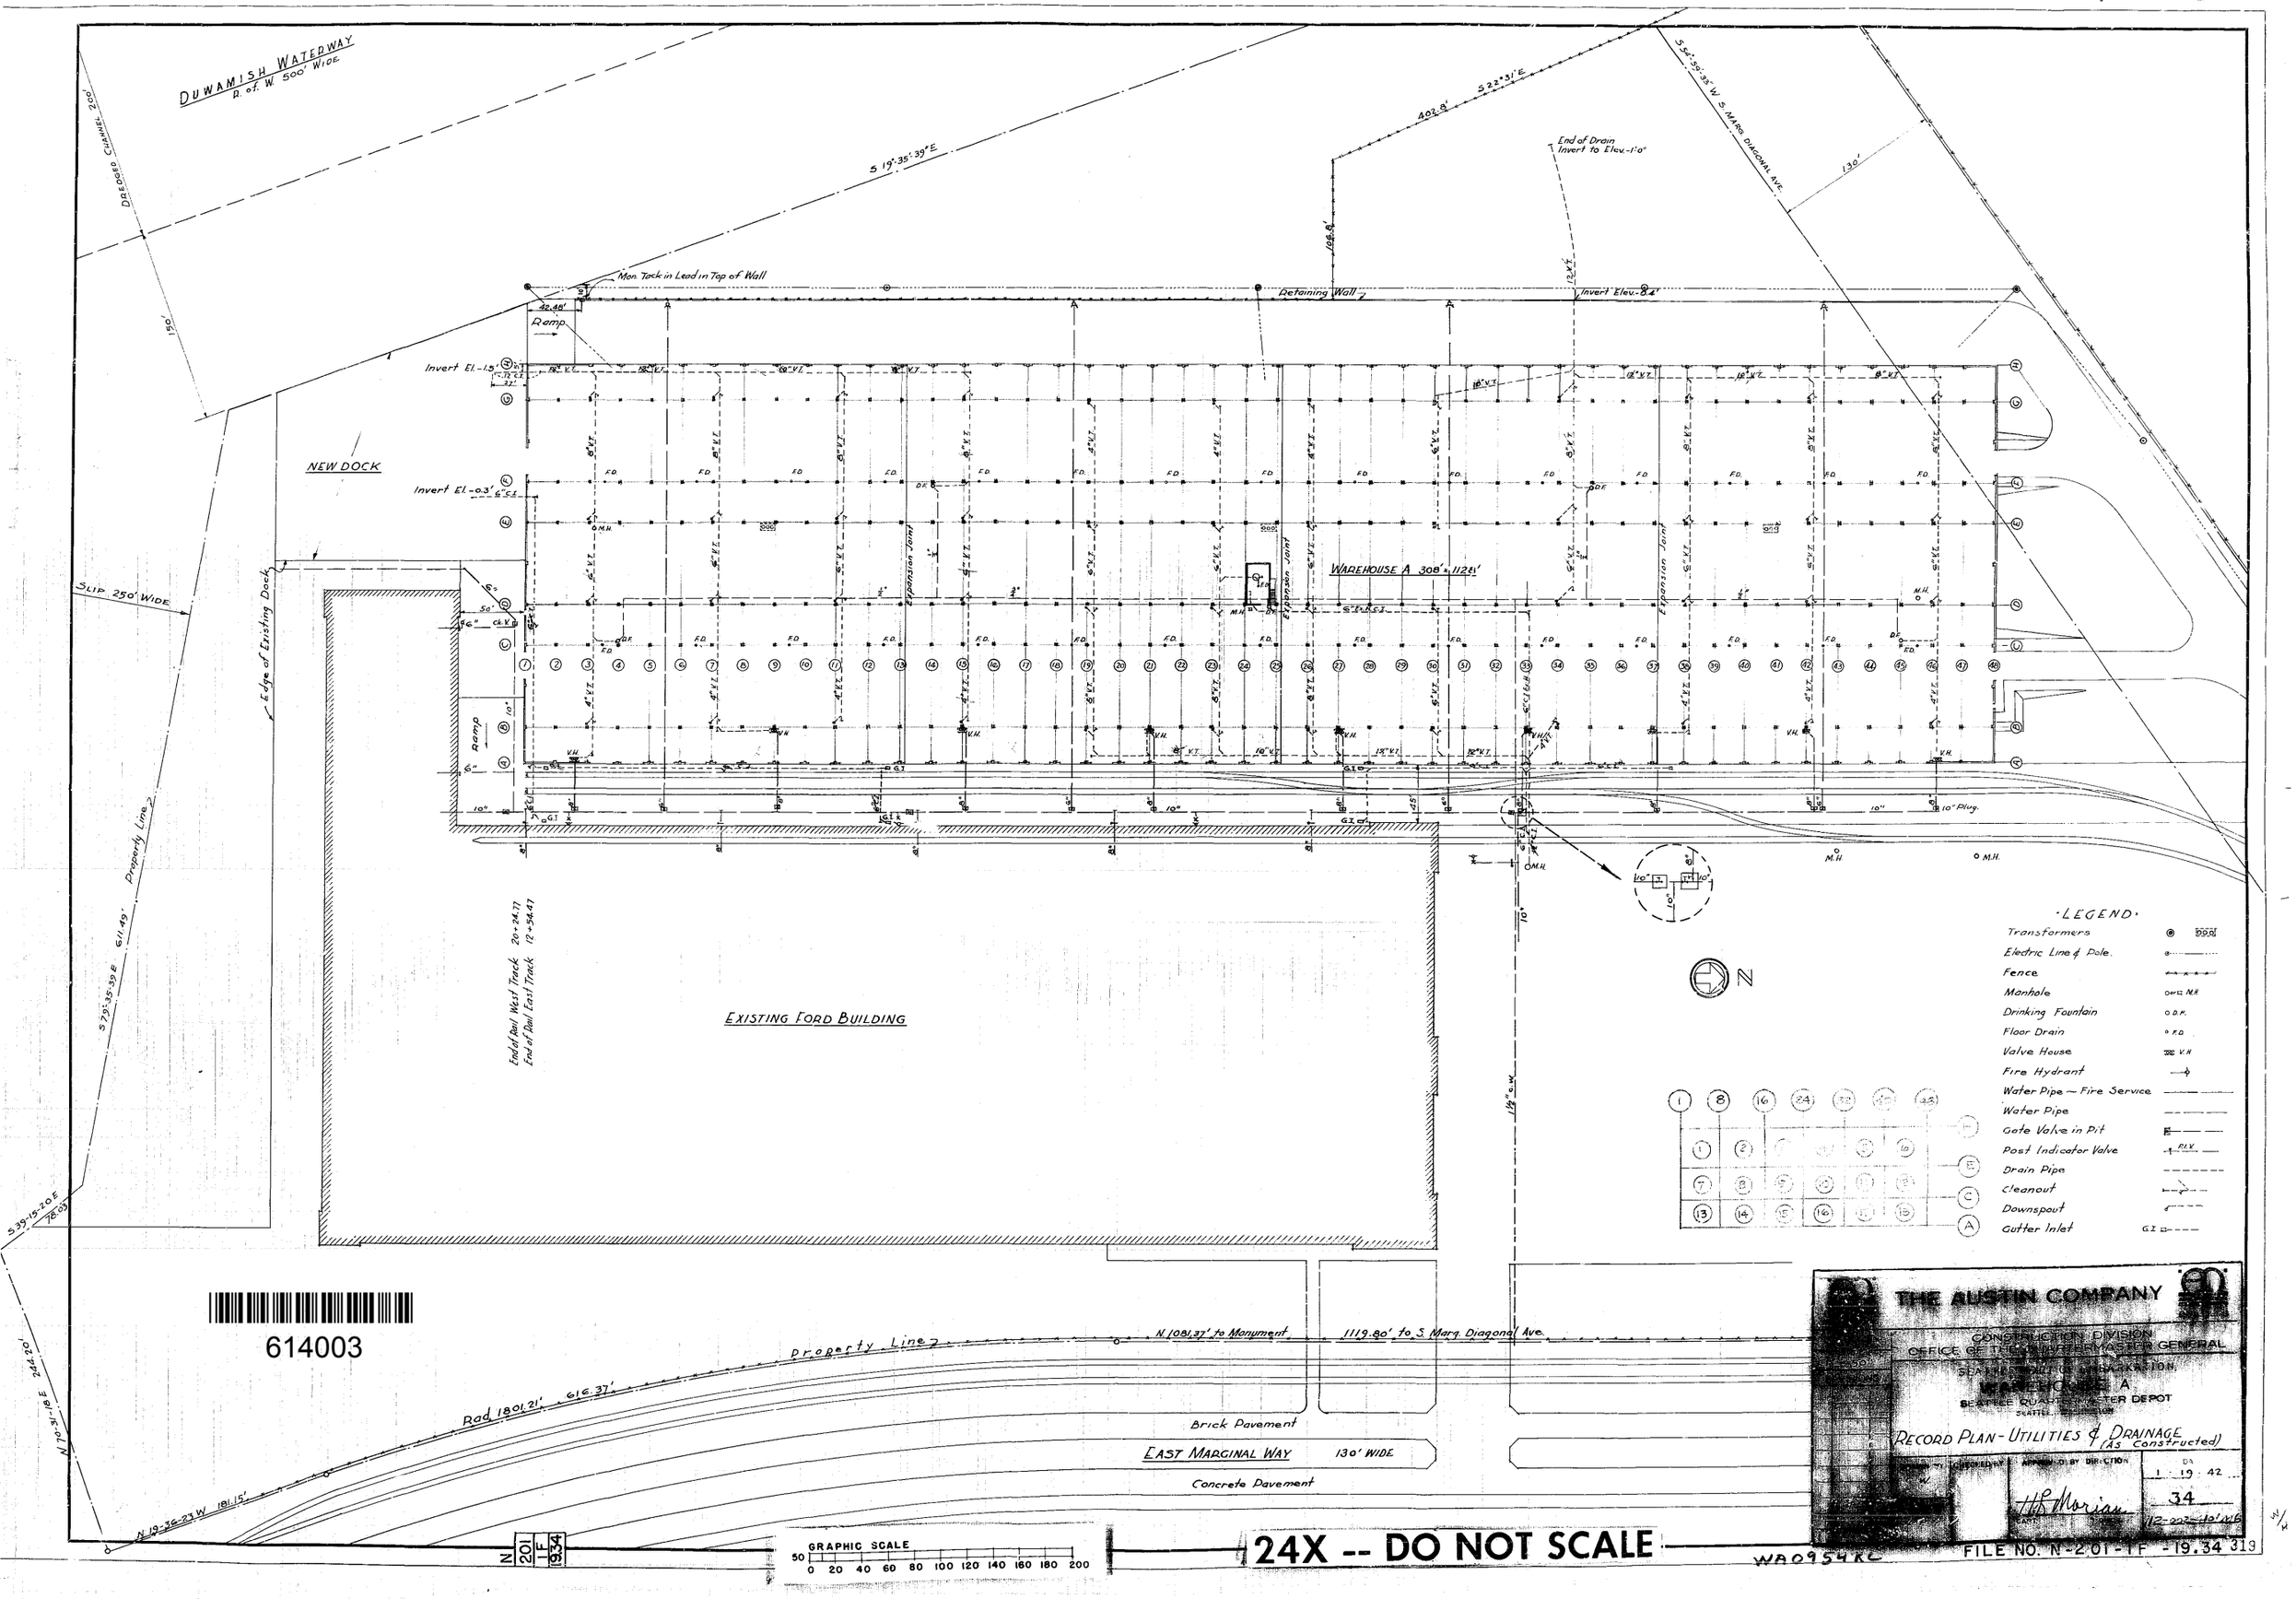

DUWAMISH WATERWAY
R. of W. 500' WIDE
DREDGED CHANNEL 200'
S 19°35'39"E
402.8'
S 22°31'E
S 54°59'35"W S. MARG. DIAGONAL AVE.
End of Drain Invert to Elev.-1'0"
Mon. Tack in Lead in Top of Wall
Retaining Wall
Invert Elev.-8.4'
Ramp
Invert El.-1.5'
NEW DOCK
Invert El.-0.3'
SLIP 250' WIDE
Edge of Existing Dock
Expansion Joint
WAREHOUSE A 308' x 1128'
Ramp
Property Line
S 79°35'39"E 611.49'
S 39°15'20"E 78.03'
N 70°31'18"E 244.20'
End of Rail West Track 20+24.77
End of Rail East Track 12+54.47
EXISTING FORD BUILDING
N
·LEGEND·
Transformers
Electric Line & Pole
Fence
Manhole
Drinking Fountain
Floor Drain
Valve House
Fire Hydrant
Water Pipe — Fire Service
Water Pipe
Gate Valve in Pit
Post Indicator Valve
Drain Pipe
Cleanout
Downspout
Gutter Inlet
614003
Property Line
N 1081.37' to Monument
1119.80' to S. Marg. Diagonal Ave.
Rad 1801.21'
616.37'
Brick Pavement
EAST MARGINAL WAY
130' WIDE
Concrete Pavement
N 19°36'23"W 181.15'
GRAPHIC SCALE
50 0 20 40 60 80 100 120 140 160 180 200
24X -- DO NOT SCALE
THE AUSTIN COMPANY
CONSTRUCTION DIVISION
OFFICE OF THE QUARTERMASTER GENERAL
WAREHOUSE A
SEATTLE QUARTERMASTER DEPOT
RECORD PLAN - UTILITIES & DRAINAGE (As Constructed)
APPROVED BY DIRECTION
1 19 42
34
FILE NO. N-201-1F-19.34
WA0954KC