897153

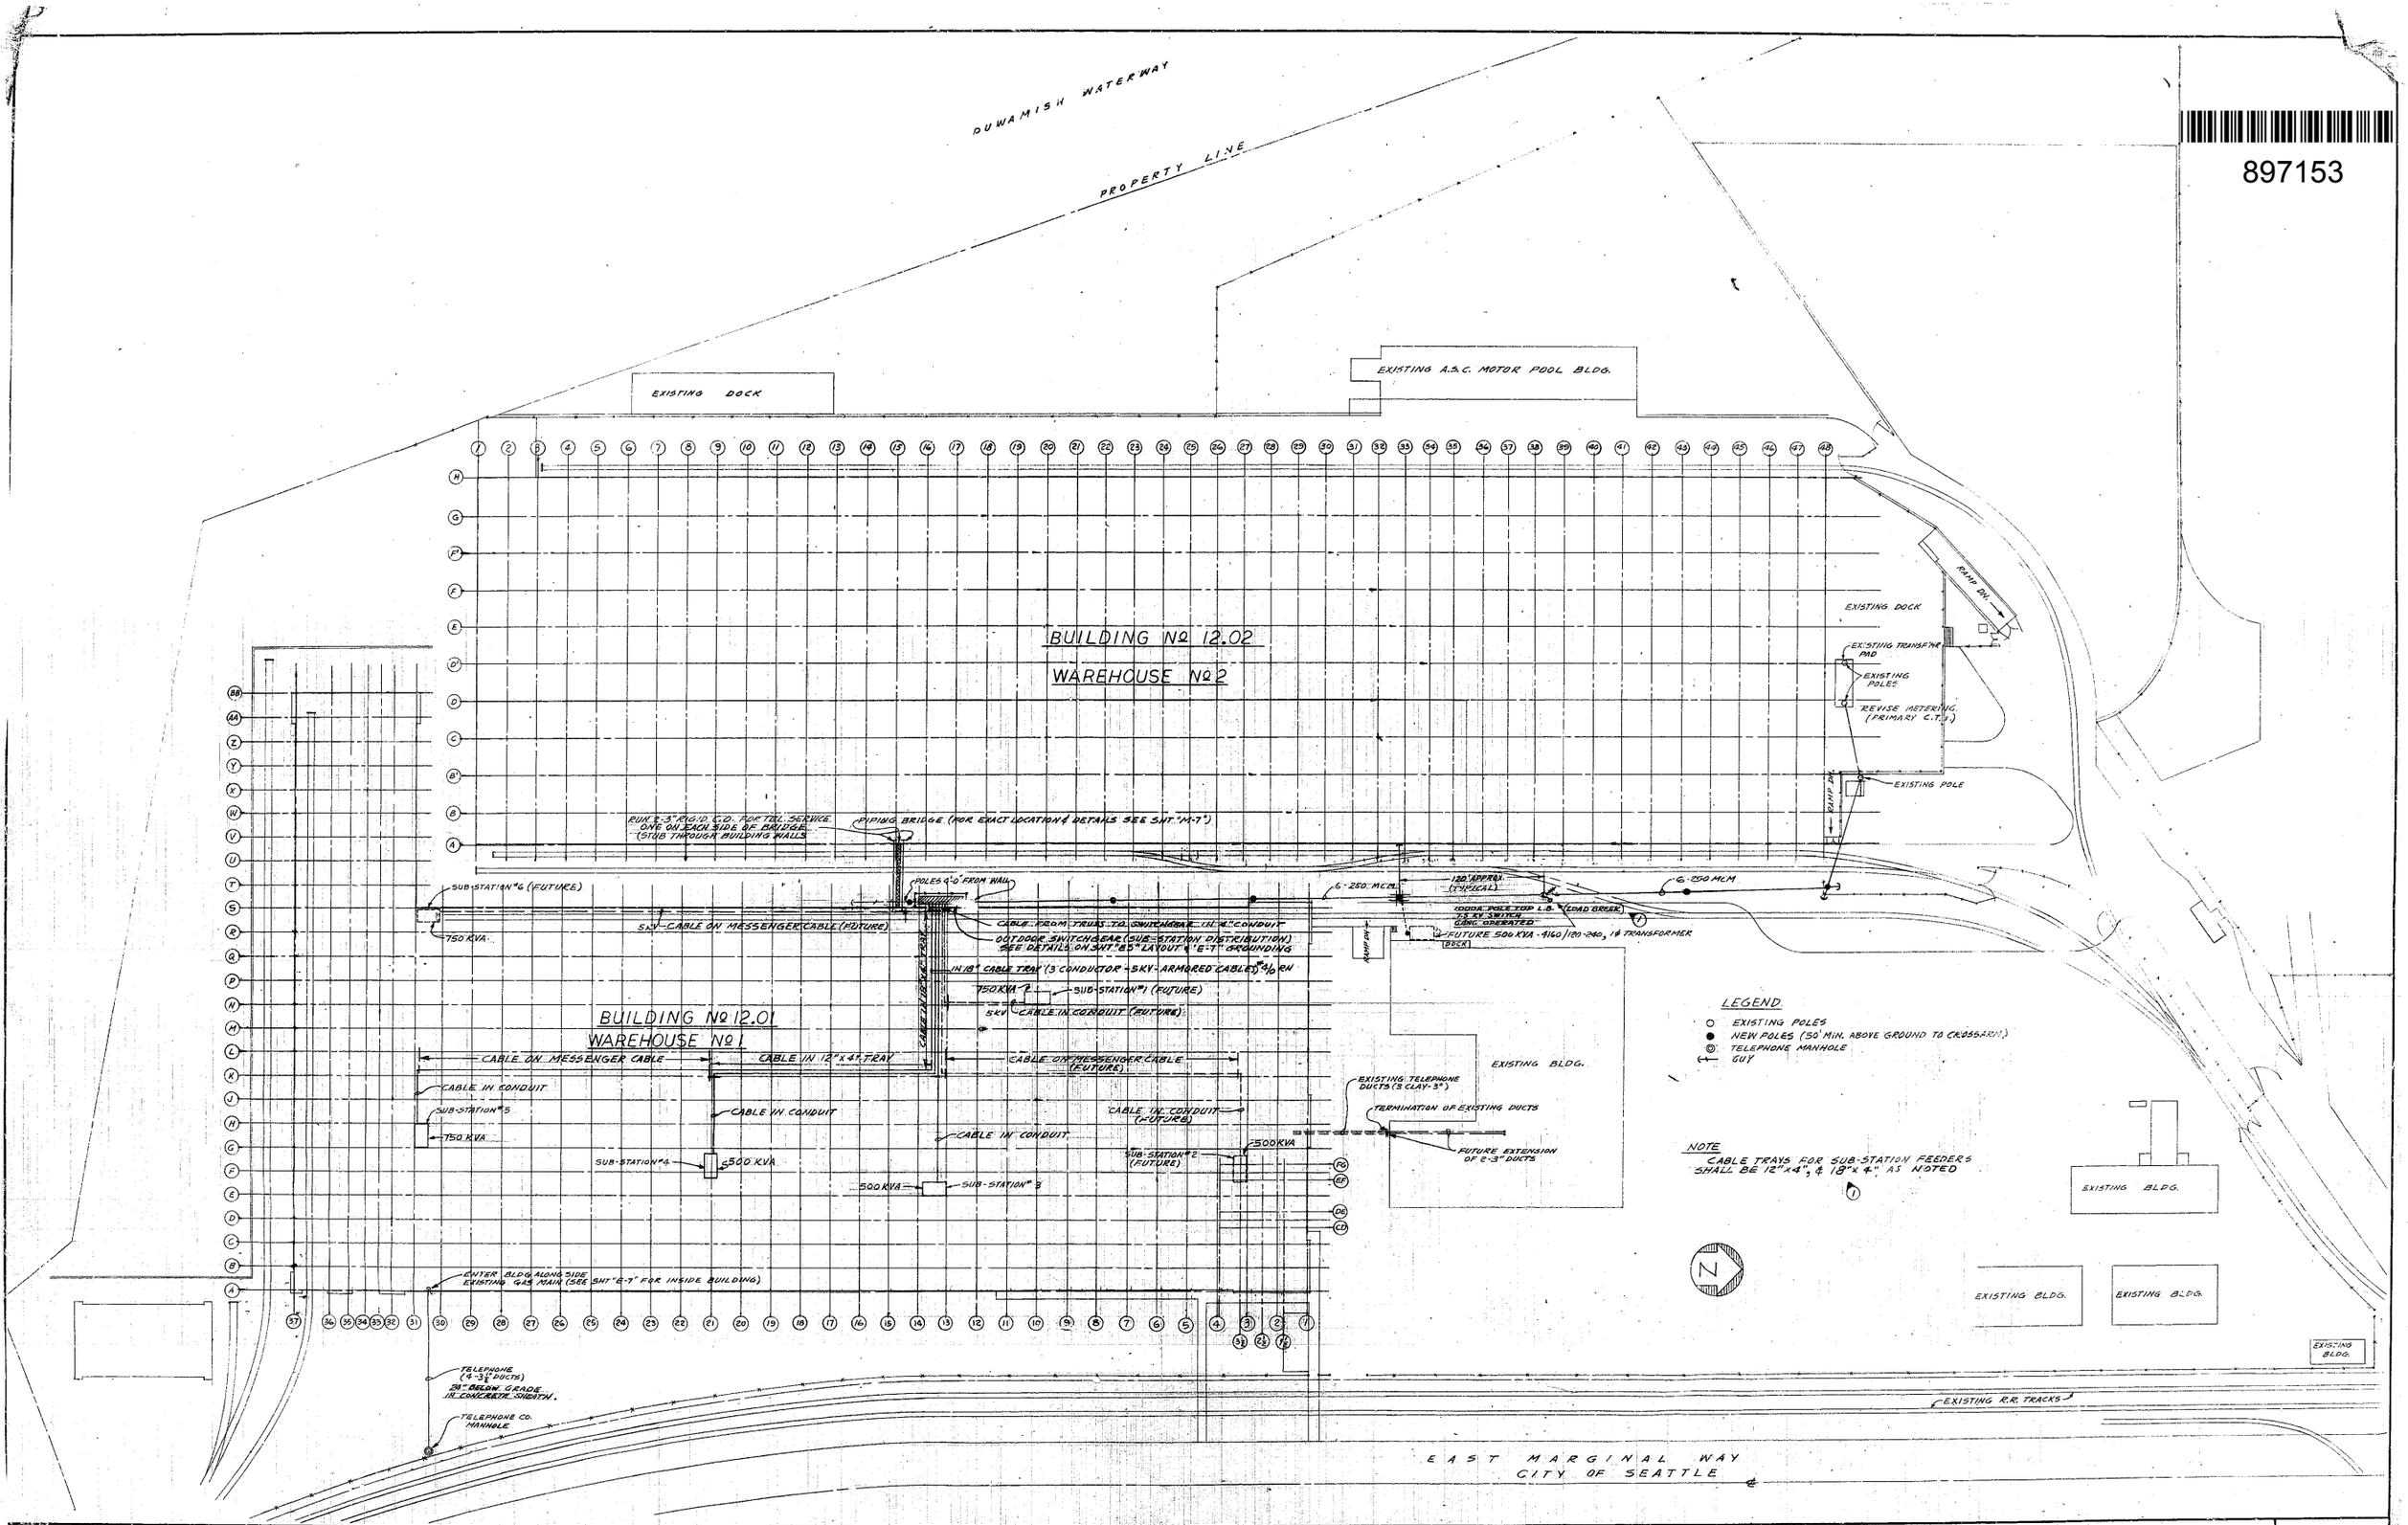

DATE • NO •	REVISION
FEB 24 '58 • (1) •	ADDED (LOAD BREAK) & NOTE
7-1-58 • (2) •	AS BUILT

DATE • NO •	REVISION

DATE • NO •	REVISION

GRAPHIC SCALES

HARMON PRAY & DETRICH
ARCHITECTS • ENGINEERS
SEATTLE WASHINGTON
JOB NO 71137-2
DATE 2-17-58

P.A.D. YIM-99A PRODUCTION FACILITY
WAREHOUSE NO. 1 C. OF E. DEPOT
BOEING AIRPLANE COMPANY SEATTLE WASH.
PRIMARY OVERHEAD DISTRIBUTION SCALE 1"=50'-0"

~~71137-2~~
E209
SHEET NO. 605

WA0952KC
112-001-2001 E209

24X -- DO NOT SCALE