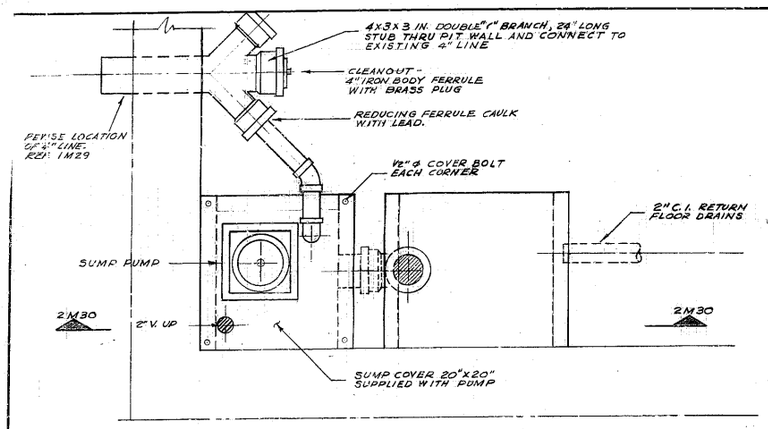

PLAN - SUMP PUMP
1-M30
1-1/2" = 1'-0"

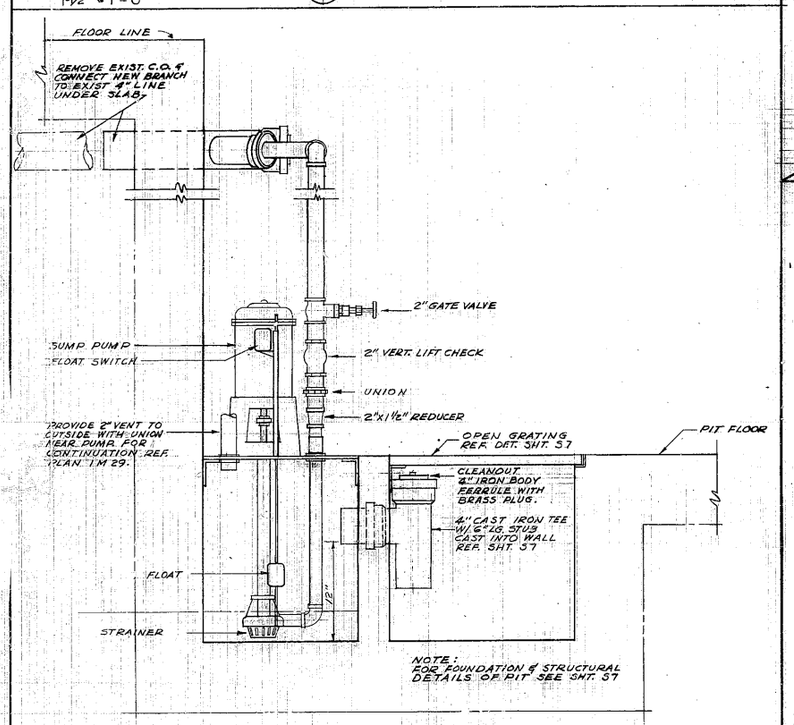

2-M30
1-1/2" = 1'-0"

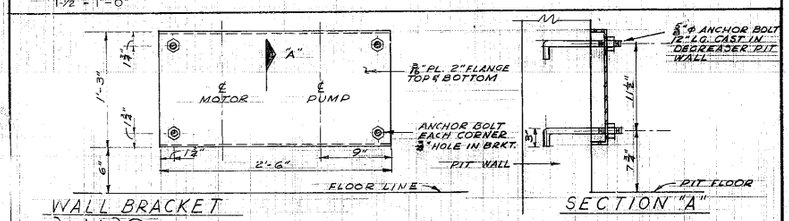

WALL BRACKET
3-M30
1/2" = 1'-0"

SECTION "A"

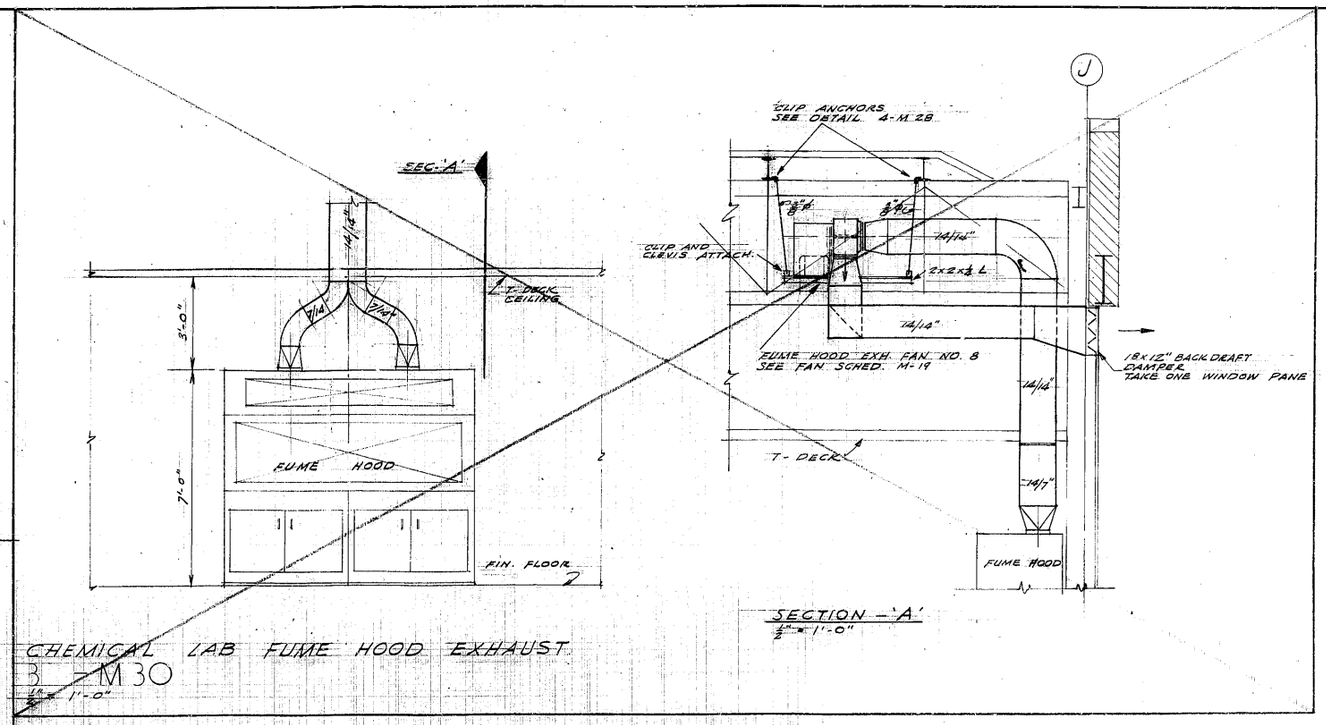

CHEMICAL LAB FUME HOOD EXHAUST
3-M30
1/2" = 1'-0"

SECTION - 'A'
1/2" = 1'-0"

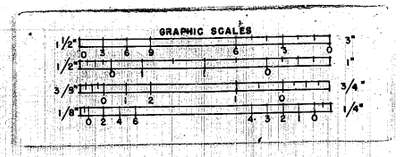

* NOTE: ALL DEGREASER EQUIPMENT & TANK [illegible] 12-15-70

DATE • NO •	REVISION	DATE • NO •	REVISION	DATE • NO •	REVISION
12-8-58 • (1) •	AS BUILT				

HARMON PRAY & DETRICH
ARCHITECTS • ENGINEERS
SEATTLE WASHINGTON
JOB NO. 71137-4
DATE 6-9-58

P.A.D. YIM-99A PRODUCTION FACILITY
WAREHOUSE NO. 1 C. OF E. DEPOT
BOEING AIRPLANE COMPANY SEATTLE, WASH.
DEGREASER DETAILS 112-C01-4182-M30

71137-4
M-30
SHEET NO.
671

24X -- DO NOT SCALE

897156