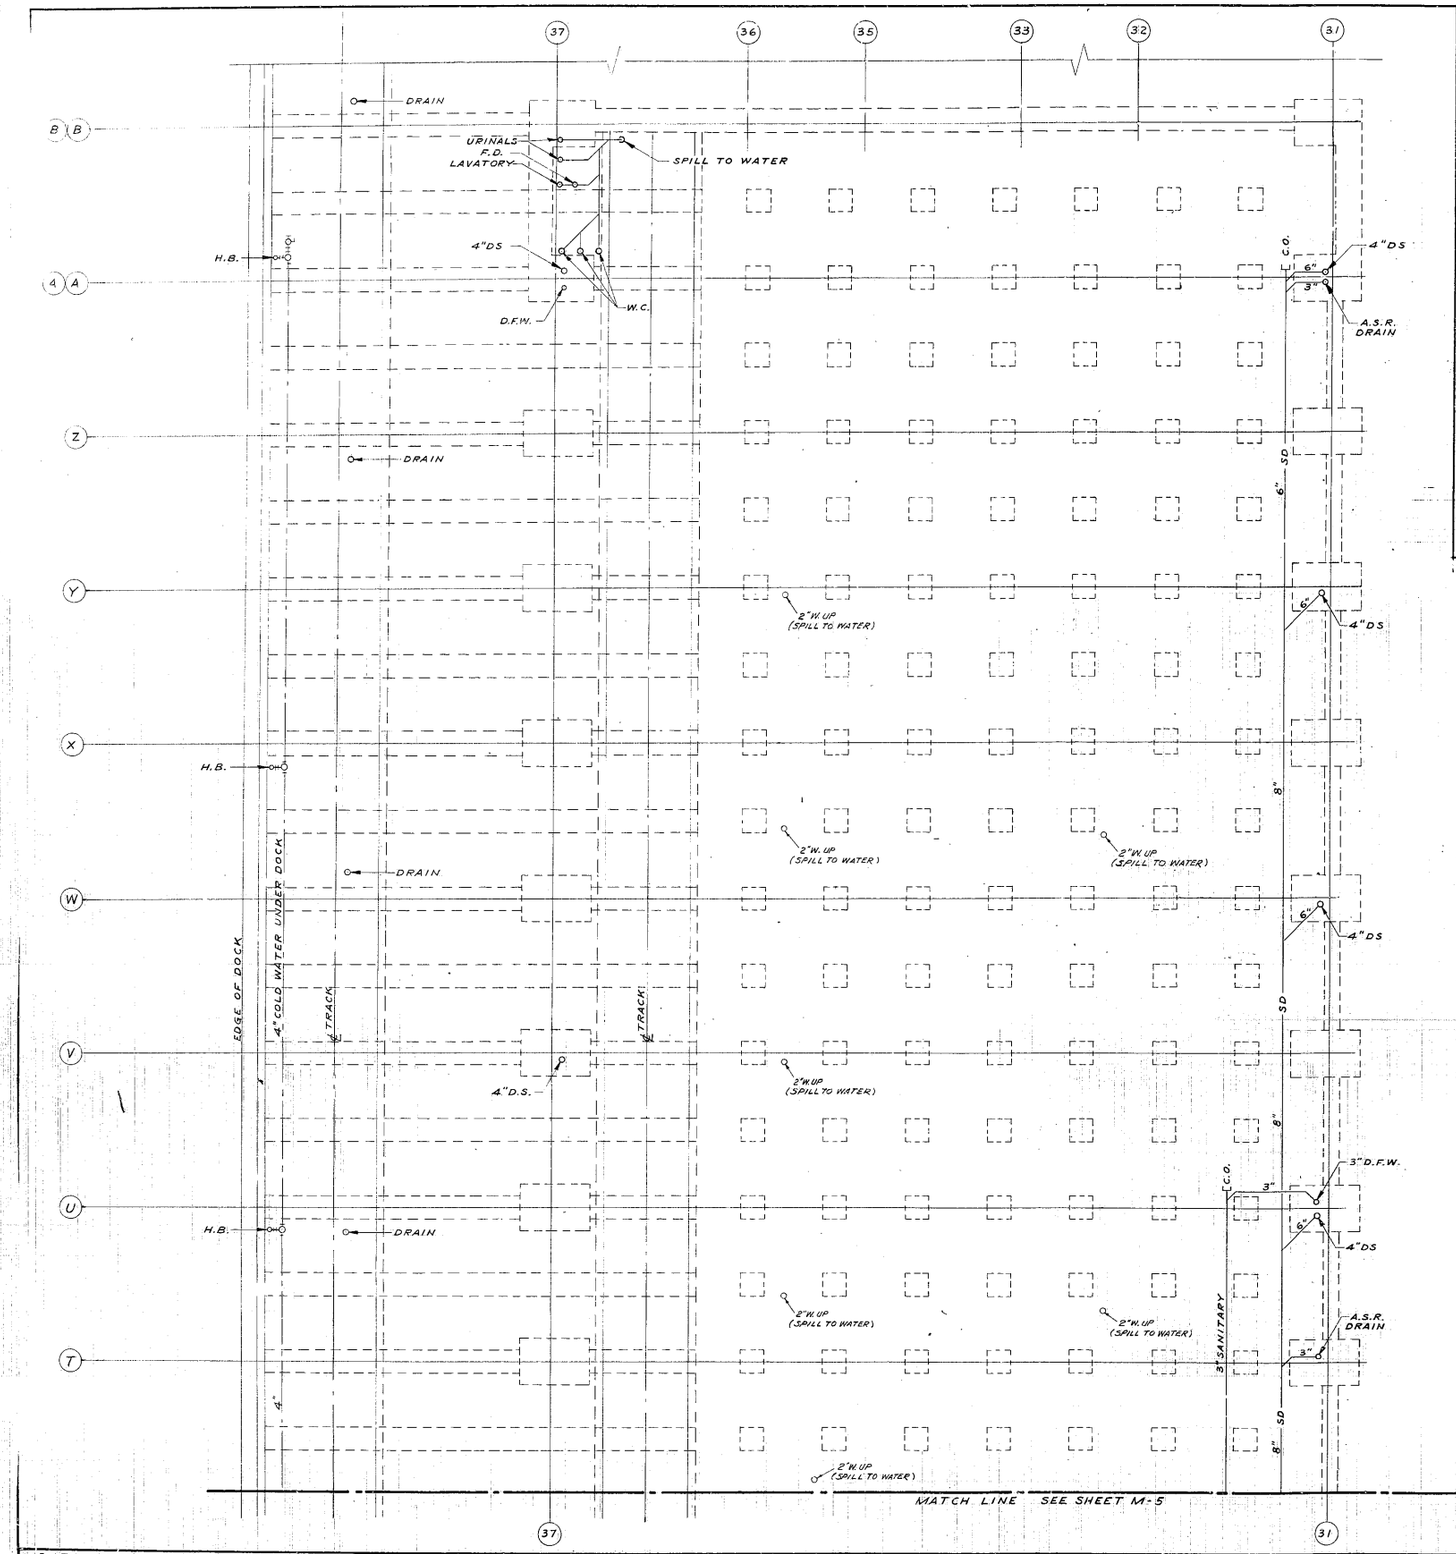

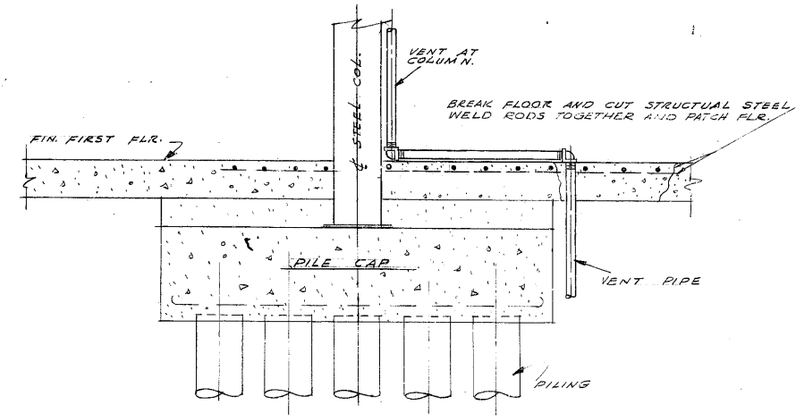

VENT THRU FLOOR AT COLUMN CAP
1 - M6
3/4" = 1'-0"

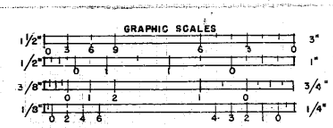

SPRINKLER VALVE PIT
F.D.

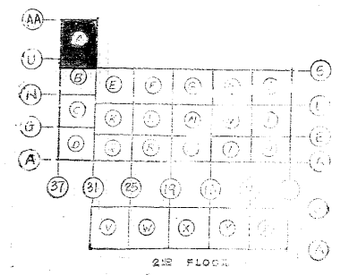

DATE • NO •	REVISION
12-8-58 • 1 •	AS BUILT

DATE • NO •	REVISION

DATE • NO •	REVISION

HARMON PRAY & DETRICH
ARCHITECTS • ENGINEERS
SEATTLE WASHINGTON
JOB NO 71137-4
DATE 6-9-58

P.A.D. YIM-99A PRODUCTION FACILITY
WAREHOUSE NO. 1 C. OF E. DEPOT
BOEING AIRPLANE COMPANY SEATTLE WASH.

71137-4
M-6
SHEET NO.

FOUNDATION PLAN COL. 31-37 S-BB SCALE: 1/4" = 1'-0"

WAC 953KC 112-001-4182-M-6 550

24X -- DO NOT SCALE

897158