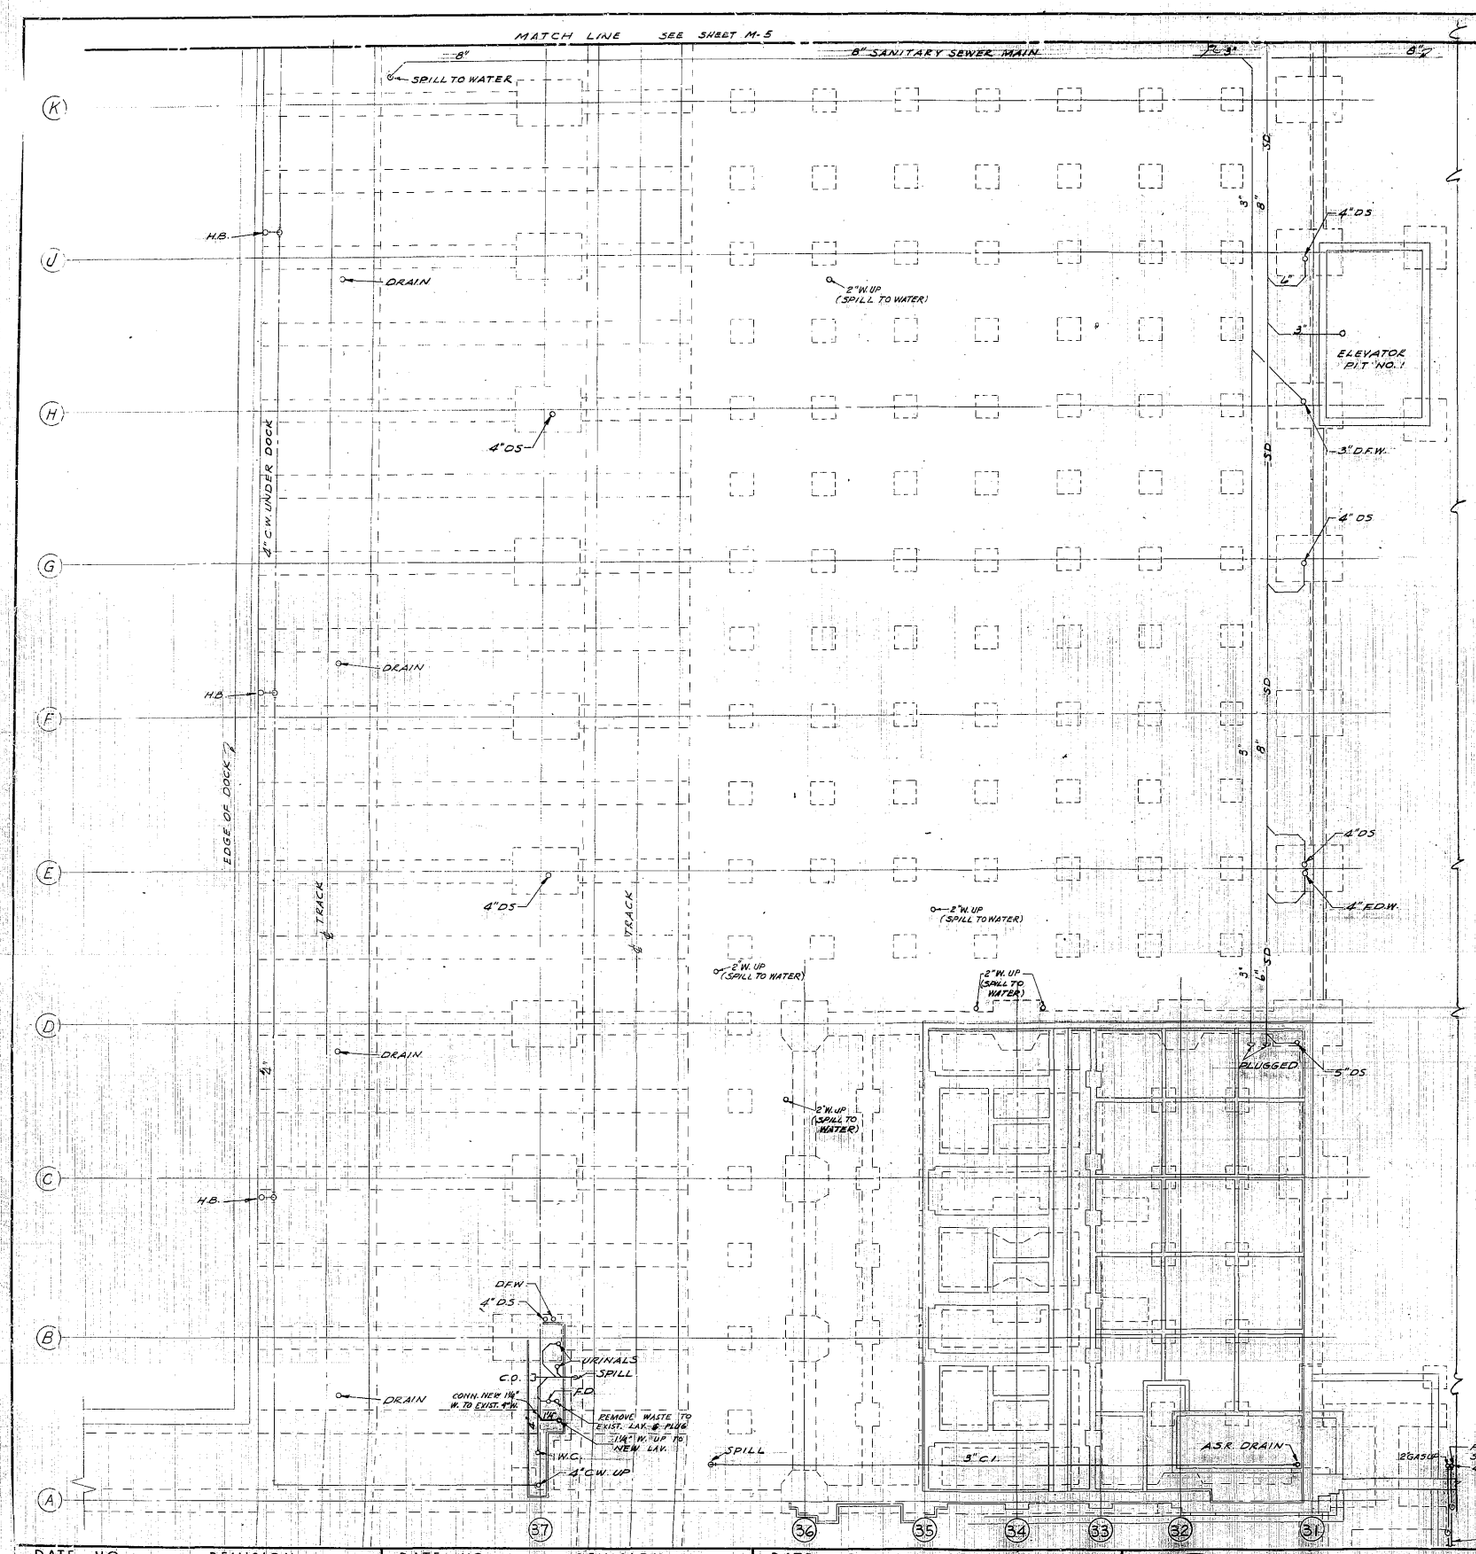

LEGEND

SYMBOL	NAME	ABB.
	EXISTING PIPING	
	NEW PIPING	
	EXISTING PIPING TO BE REMOVED	
	SANITARY SEWER	SAN
SD	STORM DRAIN	SD
RWL	RAIN WATER LEADER	RWL
CO	CLEAN OUT	CO
V	VENT	V
CW	DOMESTIC COLD WATER	CW
	DOMESTIC HOT WATER	HW
HW	HEATING WATER SUPPLY	HW
HWR	HEATING WATER RETURN	HWR
	LOW PRESSURE STEAM	LPS
	LOW PRESSURE CONDENSATE RETURN	LPR
	HIGH PRESSURE STEAM	HPS
	HIGH PRESSURE CONDENSATE RETURN	HPR
FO	FUEL OIL	FO
G	NATURAL GAS	G
VAC	VACUUM	VAC
A	COMPRESSED AIR (PRESSURE NOTED)	A
W	WASTE LINE	W
DFW	DRINKING FOUNTAIN WASTE	DFW
FDW	FLOOR DRAIN WASTE	FDW
	SINGLE AIR OUTLET	
	DUPLEX AIR OUTLET	
	HOSE BIBB	HB
L	LABORATORY VACUUM OUTLET	
	PIPE ANCHOR	PA
	BUCKET TRAP - FLOAT & THERMOSTAT TRAP	DRIP TRAP-F&T
	EXPANSION JOINT	EXP JT
	STRAINER	STR
	PRESSURE REDUCING VALVE	PRV
	GATE VALVE	GV
	GLOBE VALVE	GLV
	PLUG COCK	PLC
	CHECK VALVE	CKV
	SQUARE HEAD COCK	SHC
PITCH	PITCH DOWN IN DIRECTION OF ARROW	
	FLOW IN DIRECTION OF ARROW	
	EXHAUST OR RETURN AIR DISCHARGE	
	FLOOR DRAIN	FLD
	EQUIPMENT DRAIN	ED
	FUNNEL DRAIN	FD
	ACID OR CHEMICAL DRAIN	AD
T	THERMOSTAT	
	SUPPLY AIR DUCT SECTION	
	RETURN OR EXHAUST DUCT SECTION	
	DUCT RISES AT ANGLE	
	DUCT DROPS AT ANGLE	
	AIR DIFFUSER - NO INDIC. NECK SIZE & AIR VOLUME	
	AUTOMATIC AIR VENT	AAV
	AUTOMATIC SPRINKLER DRAIN	ASD
	AUTOMATIC SPRINKLER RISER	ASR
	BOEING AIRPLANE CO. FURNISHED	BAC-F
	EXISTING BOEING EQUIPMENT REUSED	BAC-R
	DRINKING FOUNTAIN	DF
	DOWNSPOUT	DS
	FIRE DAMPER	FRD
	MANHOLE	MH
	PLUGGED TEE	PT
	RELIEF VALVE	RV
	UNIT HEATER	UH
	VENT THRU ROOF	VTR
	SPLITTER DAMPER	SPD
	VOLUME DAMPER	VD
	CAST IRON	CI
	CONCRETE TILE	CT
	DRINKING FOUNTAIN WATER	DFW
16"	DIMENSIONS NOT TO SCALE	NTS
F	FIRE PROTECTION SPRINKLER PIPING	F

SCHEDULE

PLUMBING FIXTURE CONNECTION

NO.	FIXTURE	SOIL OR WASTE	VENT	WATER HOT	WATER COLD	REMARKS
P1	WATER CLOSET	4"	2"		1"	
P2	URINAL	EXISTING			FLUSH TANK	
P3	WASH FOUNTAIN	2"	1½"	¾"	¾"	
P4	FLOOR DRAIN	2"	1½"			
P5	EQUIPMENT DRAIN	2"	2"			
P6						NOT USED
P7	DRINKING FOUNTAIN	1⅛"	1¼"		½"	
P8						NOT USED
P9						NOT USED
P10						NOT USED
P11						NOT USED
P12	EQUIPMENT DRAIN	3"	2"			
P13	FLOOR DRAIN	2"				SEE DET. B-M25
P14	FLOOR DRAIN	2"				DEGREASER PIT
P15	LAVATORY	1⅛"	1¼"	½"	½"	

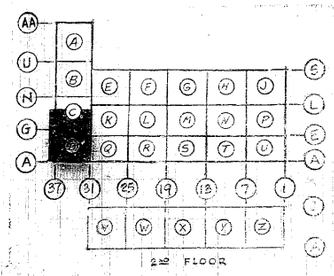

DATE • NO •	REVISION
12-1-58 (1)	AS BUILT

DATE • NO •	REVISION

DATE • NO •	REVISION

HARMON PRAY & DETRICH
ARCHITECTS • ENGINEERS
SEATTLE WASHINGTON
JOB NO. 7137-4
DATE 6-9-53

P.A.D. YIM-99A PRODUCTION FACILITY
WAREHOUSE NO. 1 C. OF E. DEPOT
BOEING AIRPLANE COMPANY SEATTLE, WASH.
FOUNDATION PLAN COL. 31-37 A-K SCALE: 1/8" = 1'-0"

7137-4
M-1
SHEET NO.

24X -- DO NOT SCALE

WA0953KC 112-001-4182-M-1 645

897159