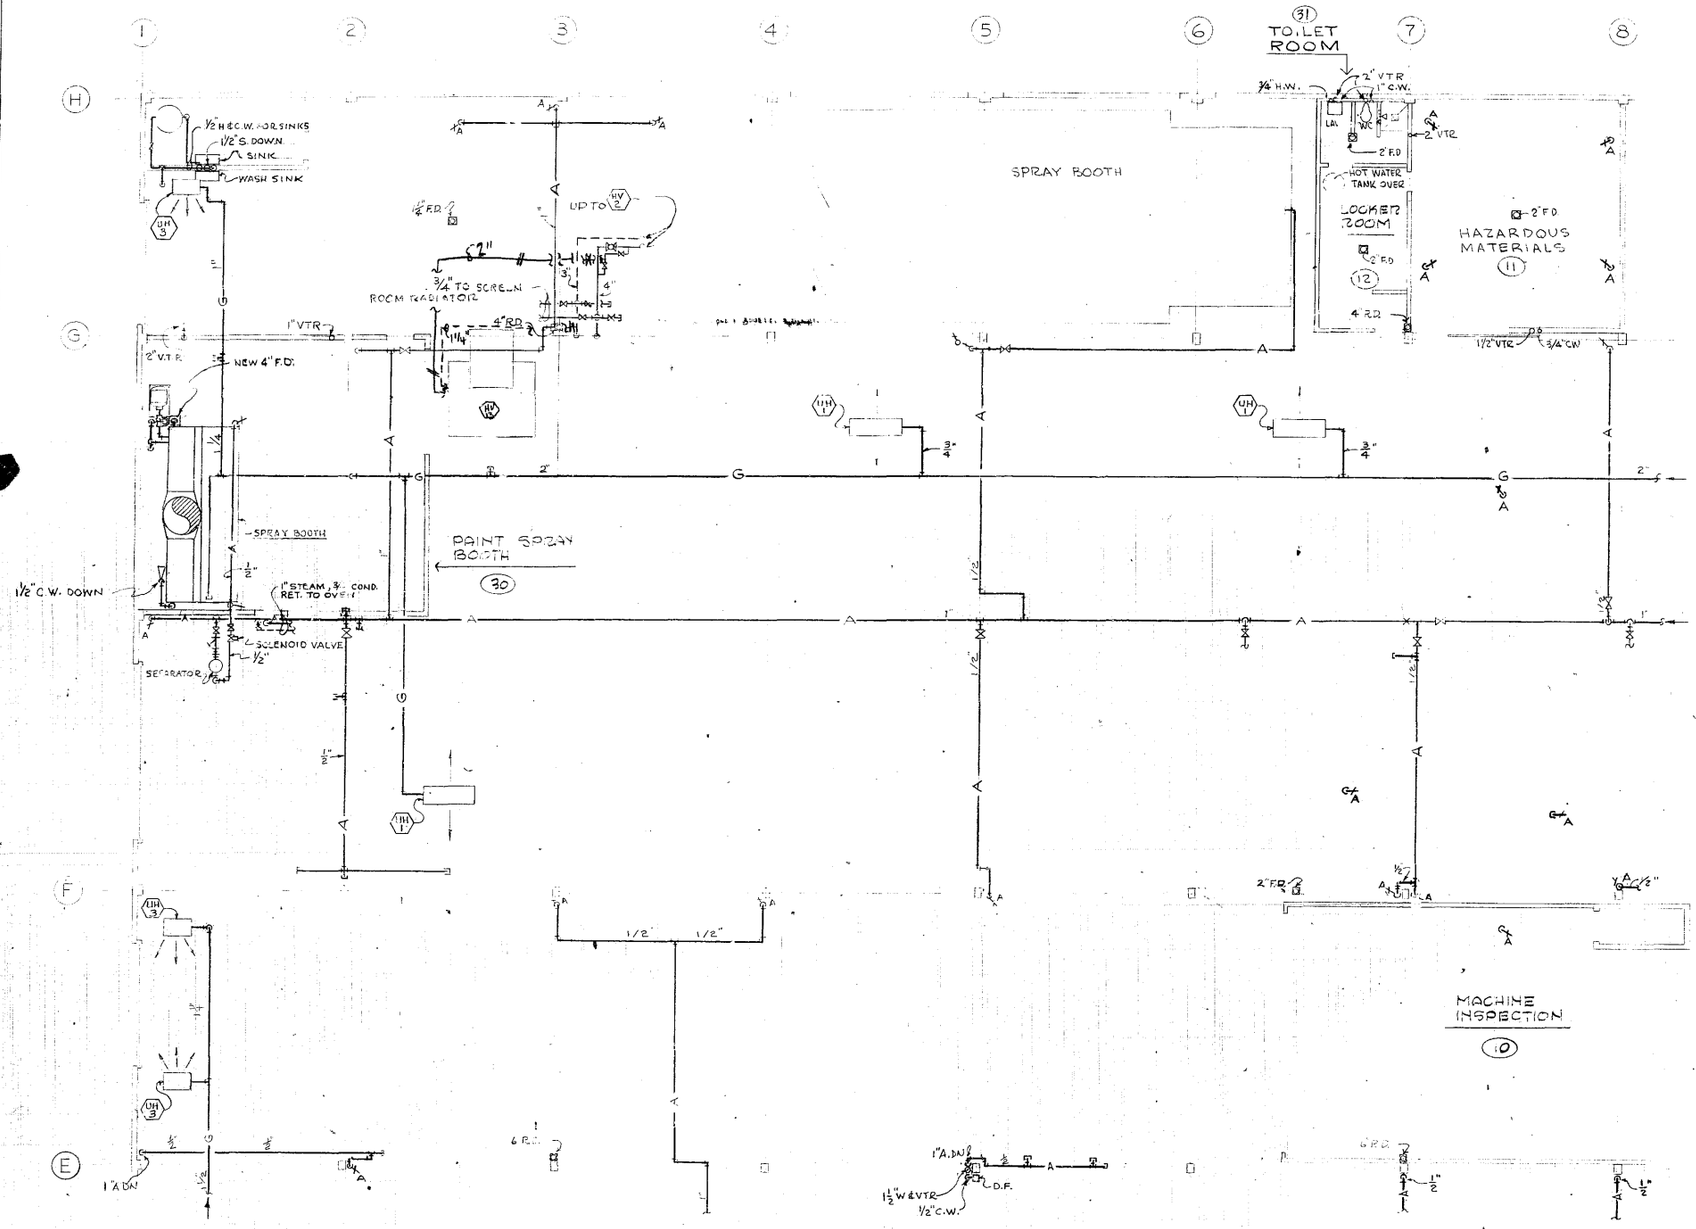

PARTIAL FIRST FLOOR PLAN

SCALE: 1/8" = 1'-0"

GRAPHIC SCALES

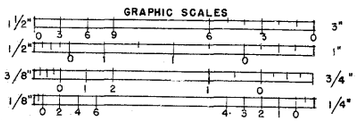

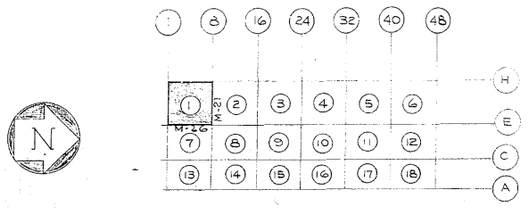

897172

24X -- DO NOT SCALE

SYM.	REVISION	BY	APPROVED	DATE

SYM.	REVISION	BY	APPROVED	DATE
E	AS BUILT	EISI	RWP	3/15/68
D	ISSUED FOR PHASE II	EISI	GHT	9/26/67
C	ISSUED FOR CONSTRUCTION	EISI	GHT	9/1/67
B	REVISION - ADDENDUM # 1	EISI	GHT	6/26/67
A	ISSUED FOR BID - CONTRACT ASD (FAC) 67-28	EISI	GHT	6/12/67

ENGINEERED INDUSTRIAL SYSTEMS INC
CONSULTING ENGINEERS
SEATTLE WASHINGTON

DRAWN BY	EISI	6/1/67
CHECKED	GHT	6/9/67
CHECKED		
APPROVED		
APPROVED		
APPROVED		

SUB TITLE: FLOOR PLAN-PIPING

TITLE: MECHANICAL MASTER

COL. E-H, 1-8 BLDG. 12.02

SHEET M-20 OF E

ISSUE

JOB NO. 2667

DWG. NO. 1512-02-4157

WA 0954KC

1178