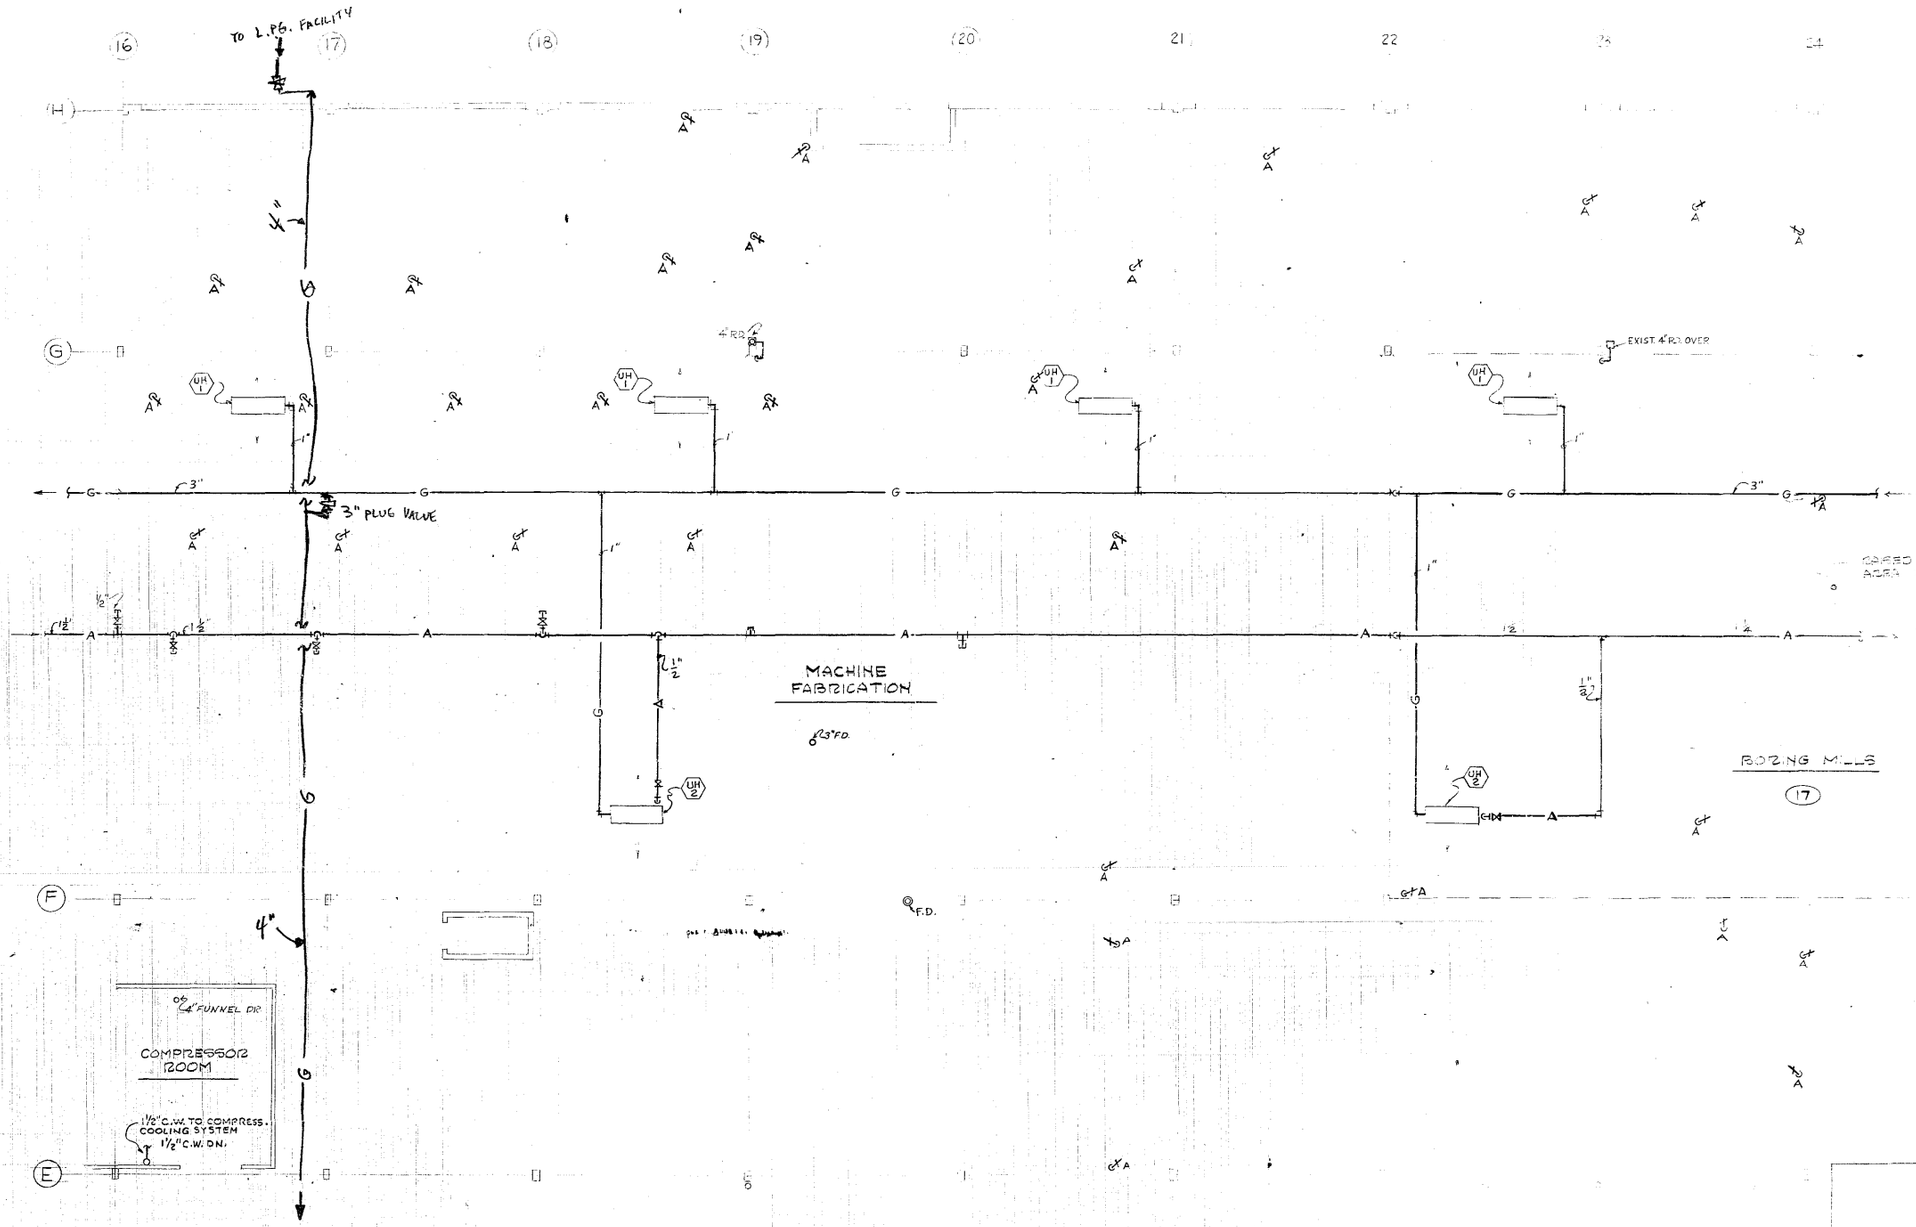

GRAPHIC SCALES

1½" 0 3 6 9 6 3 0 3"
1/2" 0 1 1 0 1"
3/8" 0 1 2 1 0 3/4"
1/8" 0 2 4 6 4 3 2 1 0 1/4"

PARTIAL FIRST FLOOR PLAN
SCALE: 1/8" = 1'-0"

897174

24X -- DO NOT SCALE

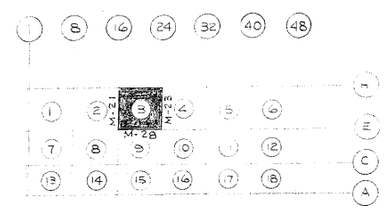

KEY PLAN BLDG. 12.02
FORMER NO. 112-002-4157

SYM.	REVISION	BY	APPROVED	DATE
D	AS BUILT	EISI	RWP	3/15/68
C	ISSUED FOR PHASE II	EISI	GHT	9/25/67
B	ISSUED FOR CONSTRUCTION	EISI	GHT	9/1/67
A	ISSUED FOR BID - CONTRACT ASD (FAC) 67-28	EISI	GHT	6/12/67

ENGINEERED INDUSTRIAL SYSTEMS INC
CONSULTING ENGINEERS
SEATTLE WASHINGTON

DRAWN BY EISI DATE 6/7/67
CHECKED GHT 6/9/67
CHECKED
APPROVED
APPROVED
APPROVED

SUB TITLE: FLOOR PLAN-PIPING
TITLE: MECHANICAL MASTER
COL. E-H, 16-24 BLDG. 12.02

SHEET M-22 OF
ISSUE D
JOB NO. 2967
DWG. NO. 112-002-4157

WA0954KC

1330