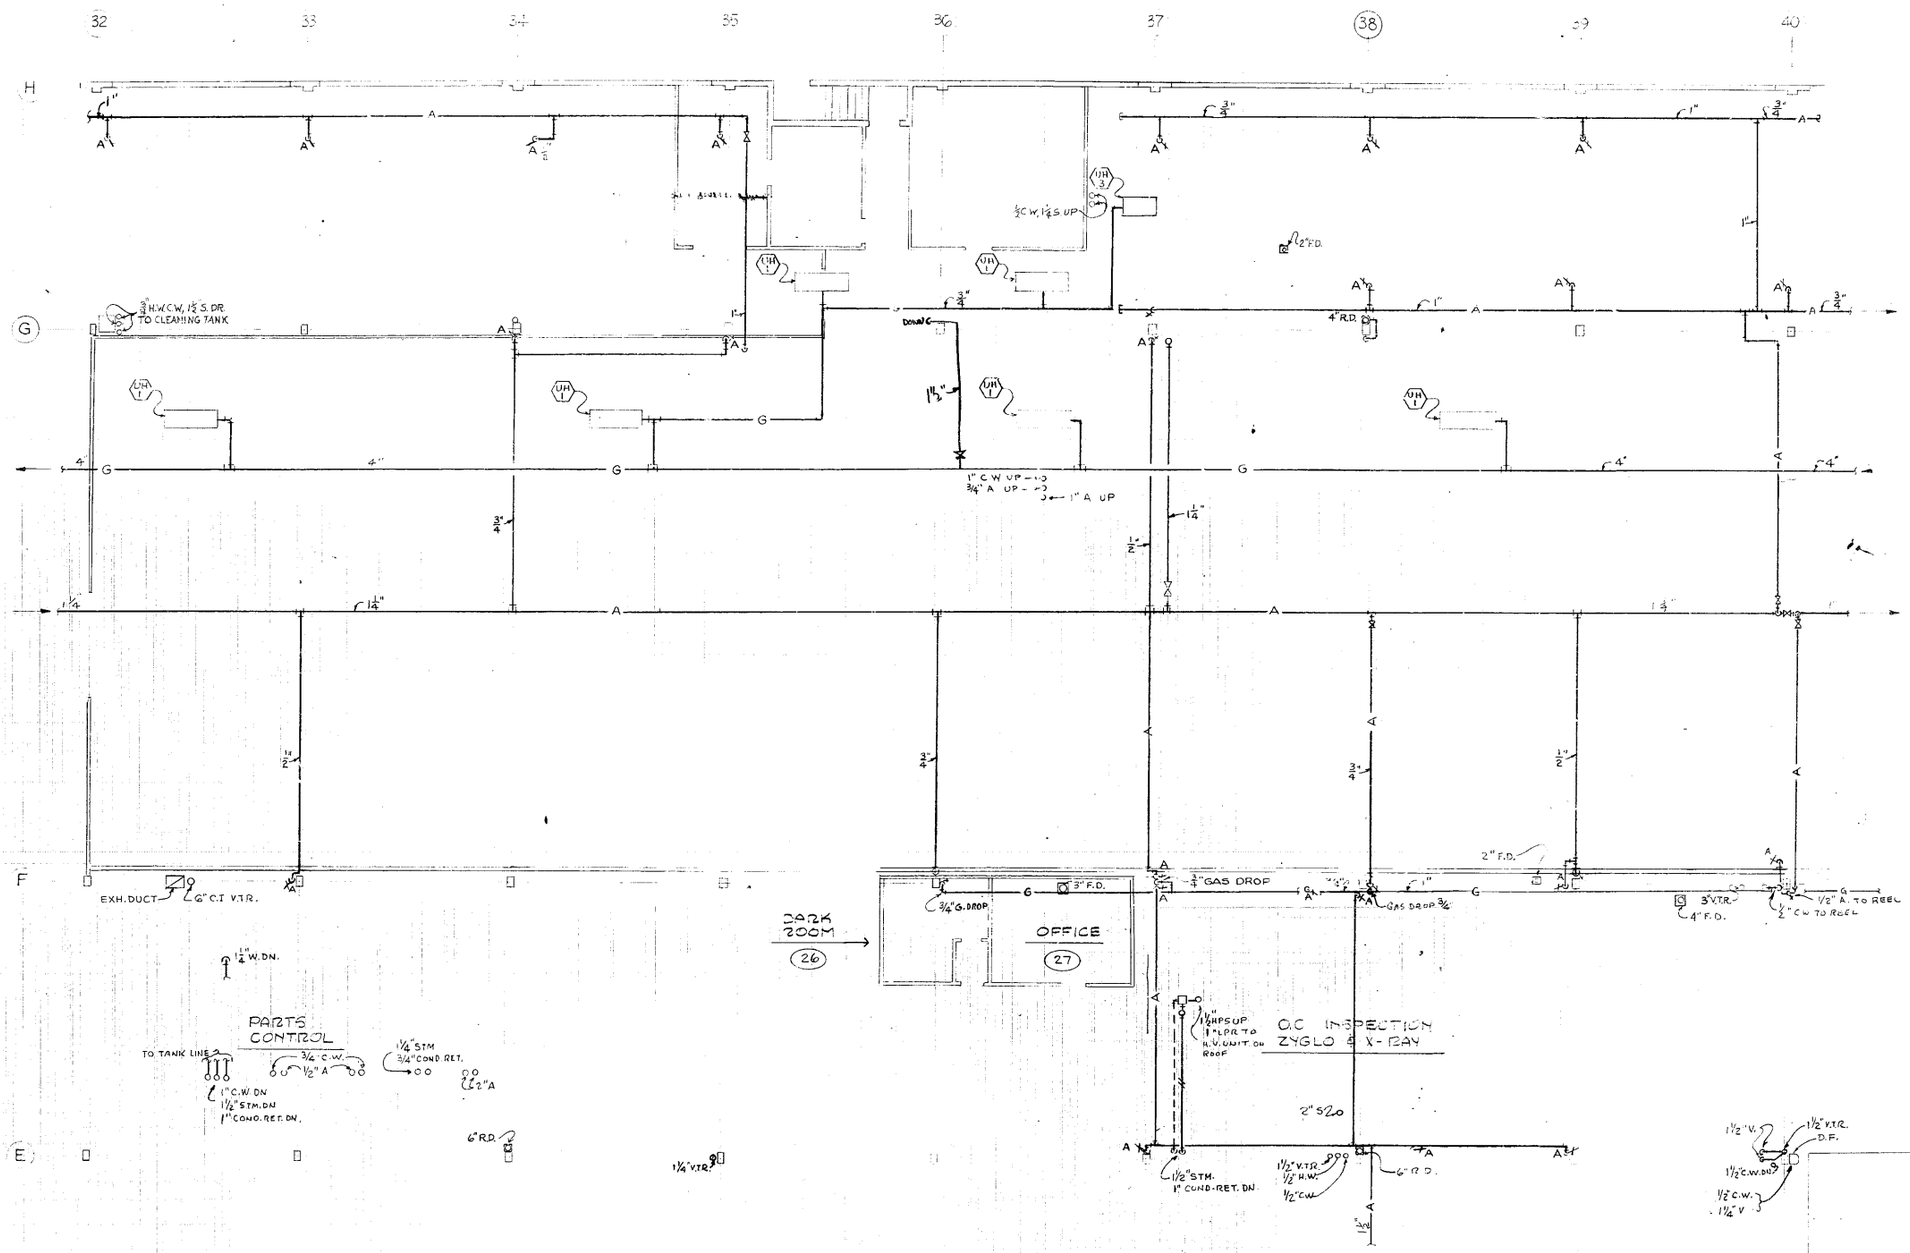

PARTIAL FIRST FLOOR PLAN
SCALE: 1/8" = 1'-0"

GRAPHIC SCALES

1 1/2"	0 3 6 9 6 3 0	3"
1/2"	0 1 0	1"
3/8"	0 1 2 1 0	3/4"
1/8"	0 2 4 6 4 3 2 1 0	1/4"

897175

24X -- DO NOT SCALE

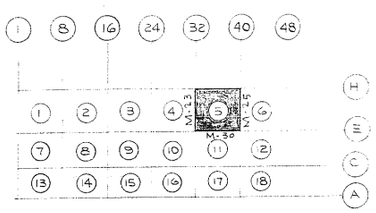

KEY PLAN BLDG. 12.02
FORMER NO. 1E1-02-4157

SYM.	REVISION	BY	APPROVED	DATE
B	AS BUILT	EISI	[illegible]	3/15/68
A	ISSUED FOR PHASE II	EISI	GHT	9/25/67

ENGINEERED INDUSTRIAL SYSTEMS INC
CONSULTING ENGINEERS
SEATTLE WASHINGTON

DRAWN BY EISI DATE 9/25/67
CHECKED GHT
CHECKED
APPROVED
APPROVED
APPROVED

SUB TITLE: FLOOR PLAN-PIPING
TITLE: MECHANICAL MASTER
COL. E-H, 32-40 BLDG. 12.02

SHEET M-24 OF ISSUE B
JCR NO. 2967
DWG. NO. 112-002-4 57

WA0954KC
1382