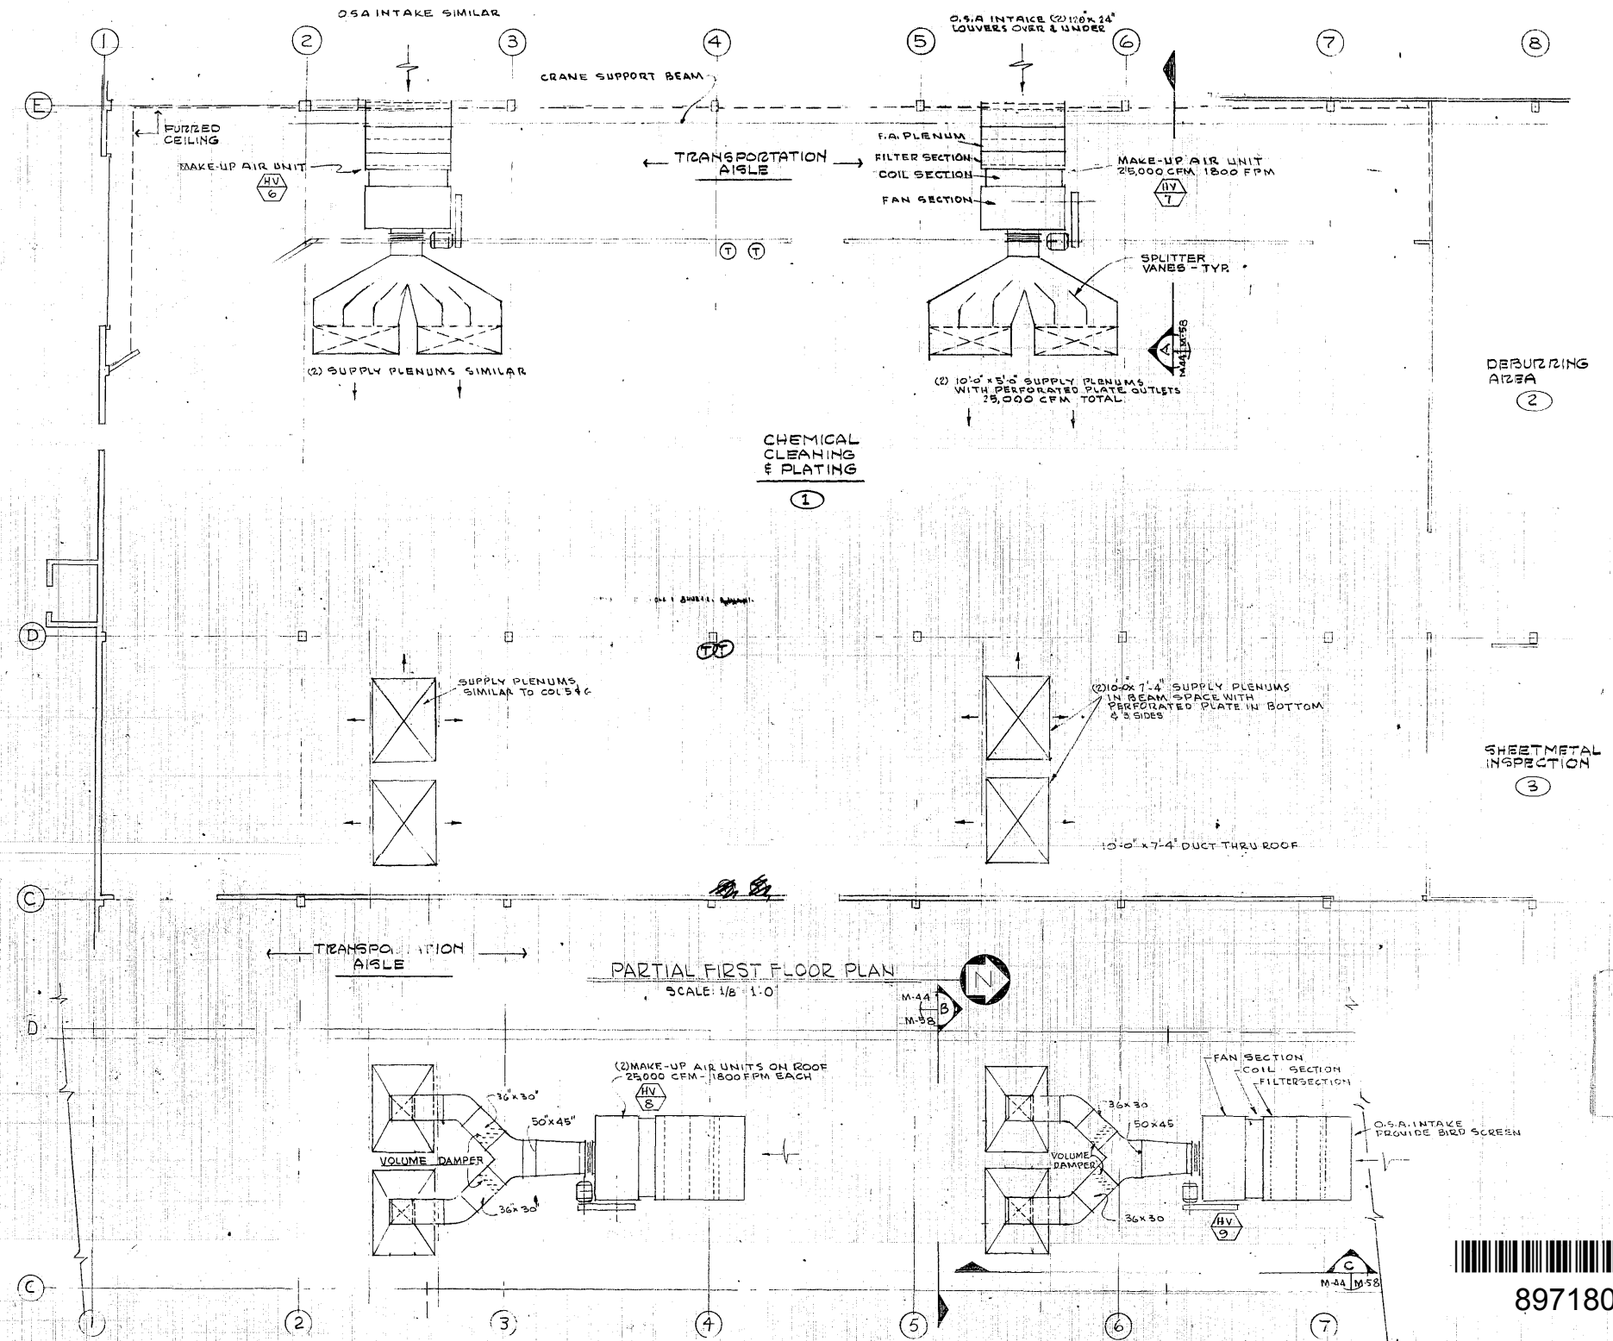

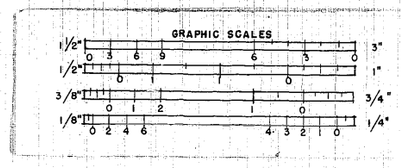

897180

24X -- DO NOT SCALE

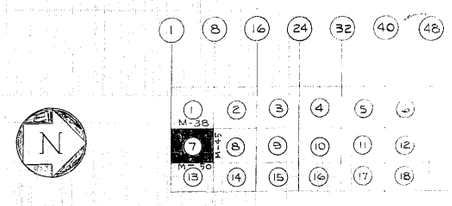

KEY PLAN BLDG. 12.02

FORMER NO. [illegible]

SYM.	REVISION	BY	APPROVED	DATE

SYM.	REVISION	BY	APPROVED	DATE
D	AS BUILT	EISI	RWP	3/15/68
C	ISSUED FOR CONSTRUCTION	EISI	GHT	9/1/67
B	REVISION - ADDENDUM #1	EISI	GHT	6/29/67
A	ISSUED FOR BID-CONTRACT ASD (FAC) 67-28	EISI	GHT	6/12/67

ENGINEERED INDUSTRIAL SYSTEMS INC

CONSULTING ENGINEERS

SEATTLE WASHINGTON

		DATE
DRAWN BY	EISI	6/1/67
CHECKED	GHT	6/9/67
CHECKED		
APPROVED		
APPROVED		
APPROVED		

SUB TITLE: FLOOR PLAN-VENTILATION

TITLE: MECHANICAL MASTER

COL. C-E, 1-8 BLDG. 12.02

SHEET: M-44 OF

ISSUE: D

JOB NO. 2961

DWG. NO. 1812-02-4 [illegible]

WA0954KC

1402