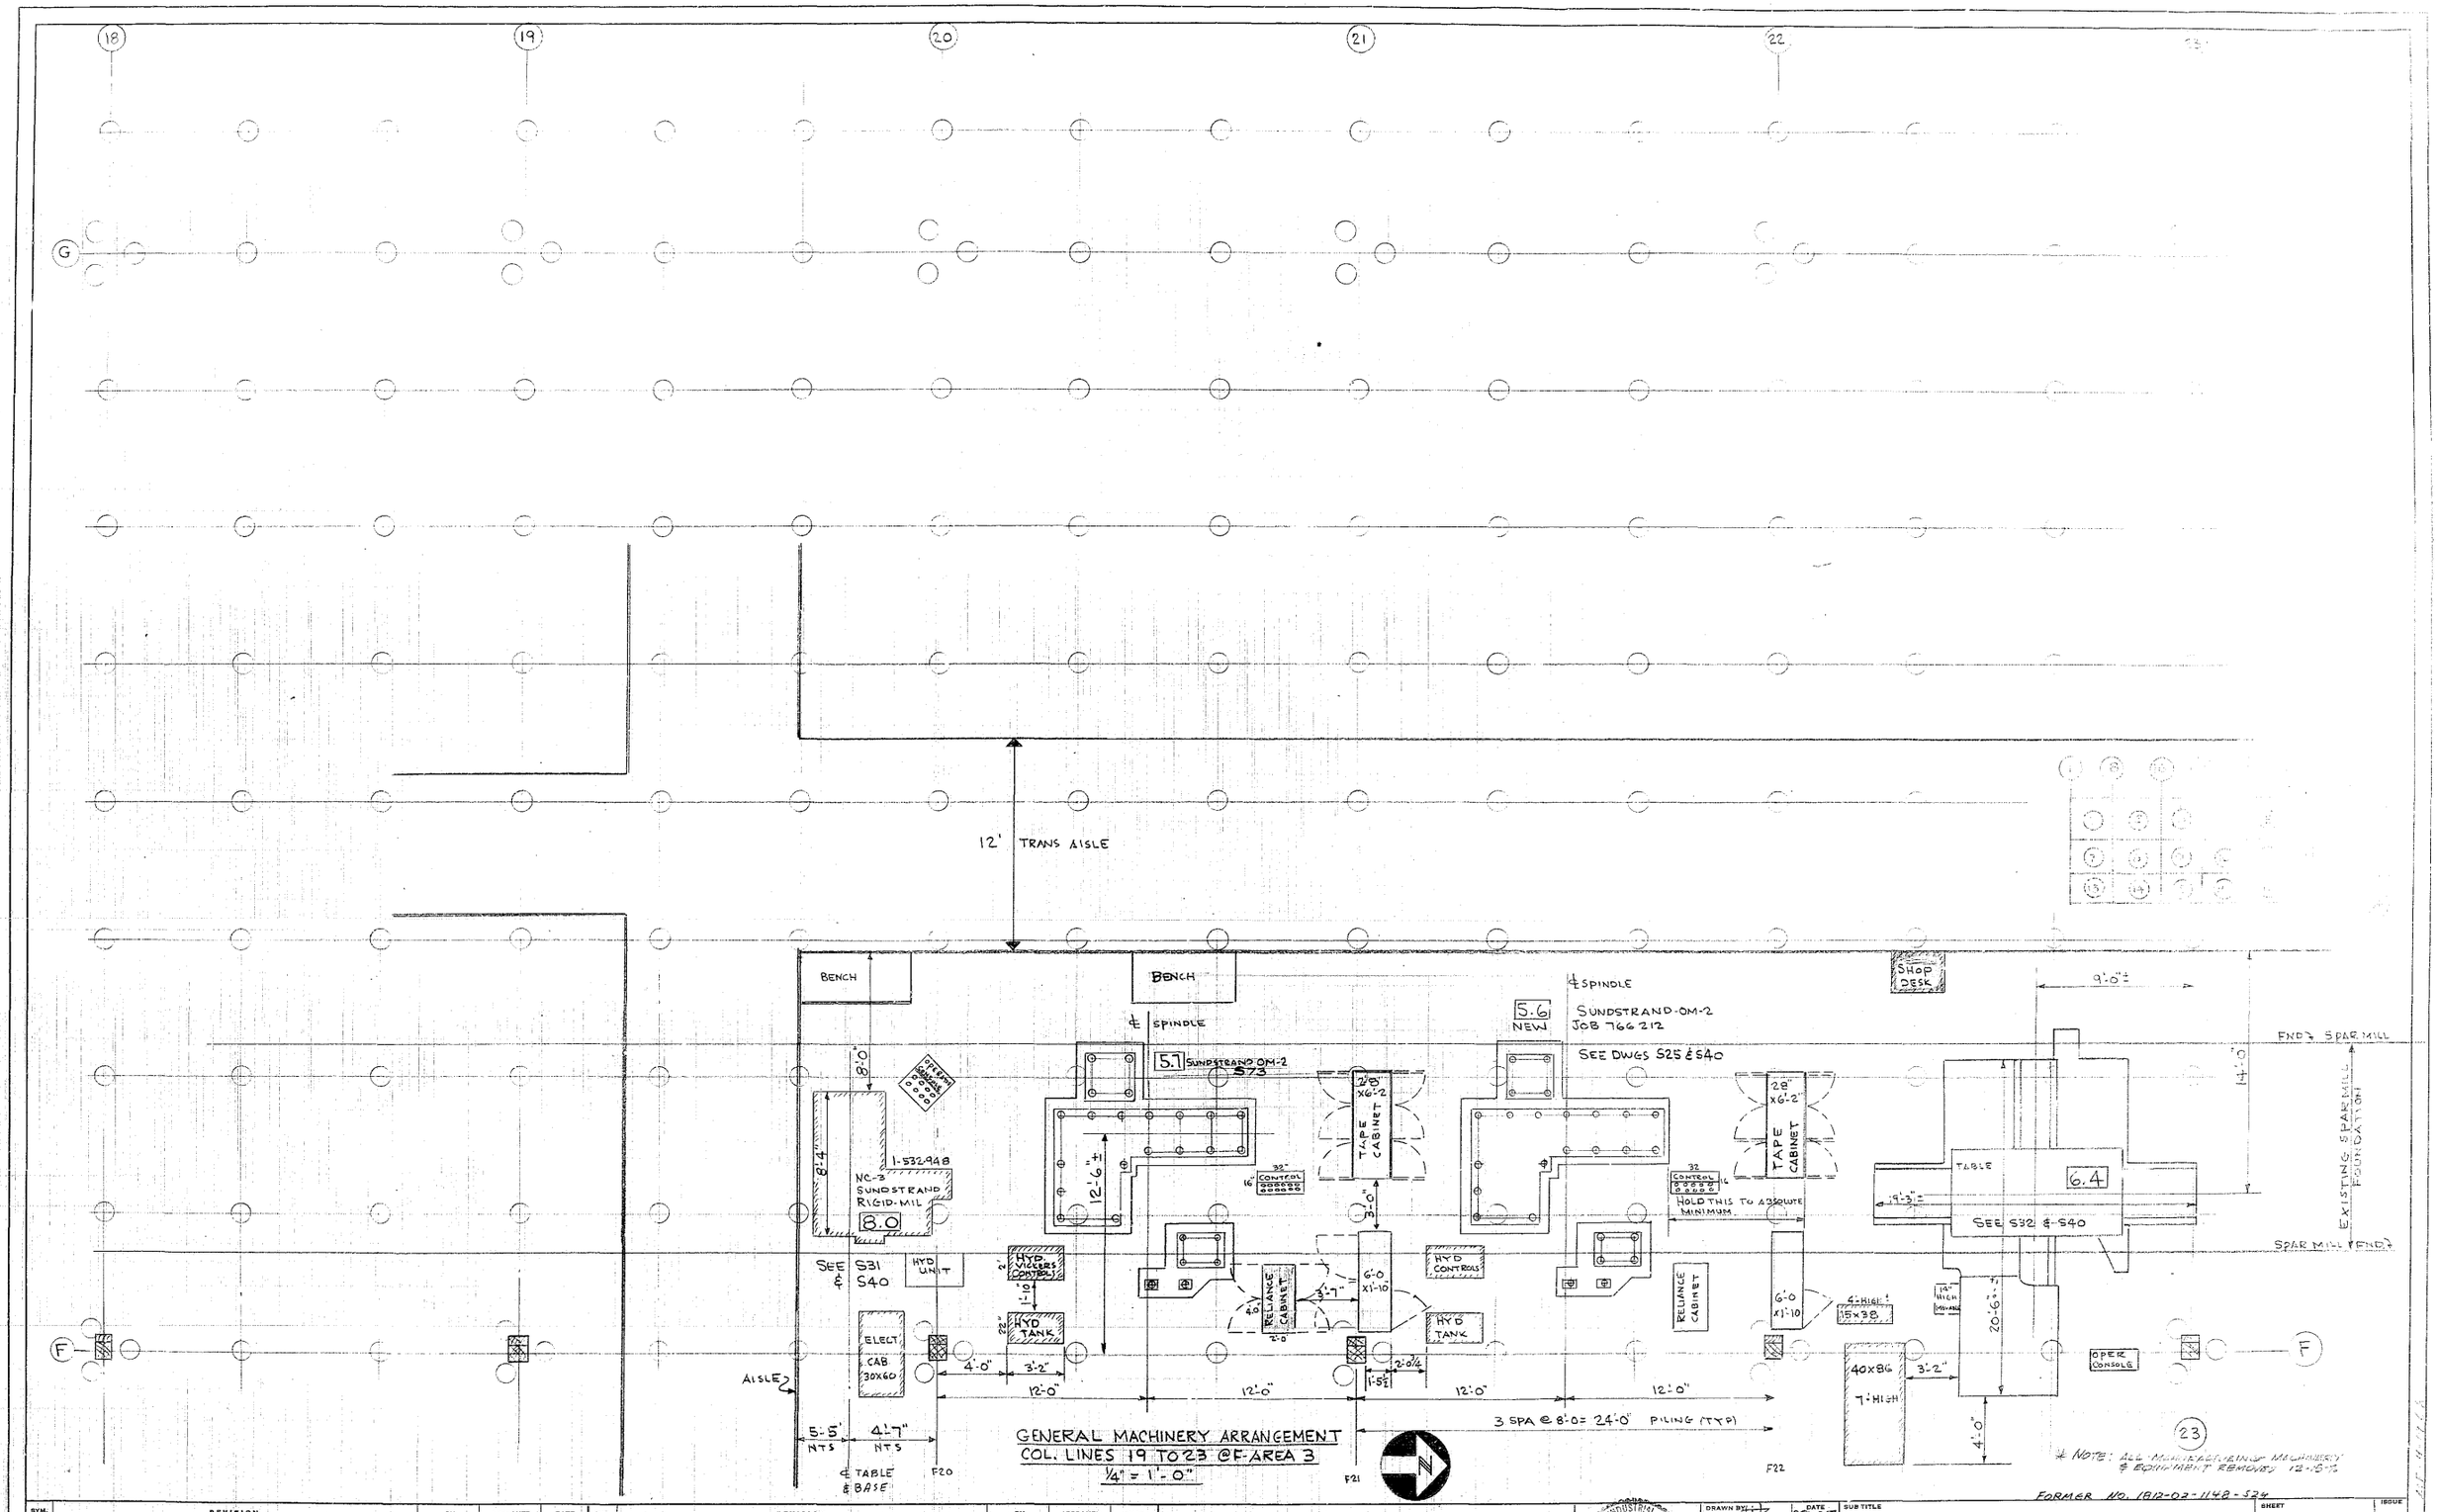

GENERAL MACHINERY ARRANGEMENT
COL. LINES 19 TO 23 @ F-AREA 3
1/4" = 1'-0"

* NOTE: ALL MANUFACTURING MACHINERY & EQUIPMENT REMOVED 12-15-%

FORMER NO. 1812-02-1148-S24

SYM.	REVISION	BY	APPROVED	DATE
D	AS BUILT	EISI	JJ	2-14-68
C	REV. LOCATION OF AISLE & MACHINE 8.0	EISI	EWC	10/9/67
B	ISSUED FOR CONSTRUCTION	EISI	JCJ	9-1-67
A	ISSUED FOR BID-CONTRACT ASD (FAC) 67-28	EISI	JJ	6/12/67

GRAPHIC SCALES
1 1/2" 0 3 6 9 6 3 0 3"
1 1/2" 0 1 1 0 1"
3/8" 0 1 2 1 0 3/4"
1/8" 0 2 4 6 4 3 2 1 0 1/4"

ENGINEERED INDUSTRIAL SYSTEMS INC
CONSULTING ENGINEERS
SEATTLE WASHINGTON

DRAWN BY		DATE 25APR67
CHECKED	JCJ	5-31-67
CHECKED		
APPROVED		
APPROVED		
APPROVED		

SUB TITLE: MACHINERY FOUNDATION LAYOUT
TITLE: GENERAL ARRANGEMENT
COLS. F-G, 18, 23 BLDG. 12.02

SHEET S24 OF
ISSUE D
JOB NO. 2967
DWG. NO. 112-002-1148

WA0954KC

24X -- DO NOT SCALE

897183