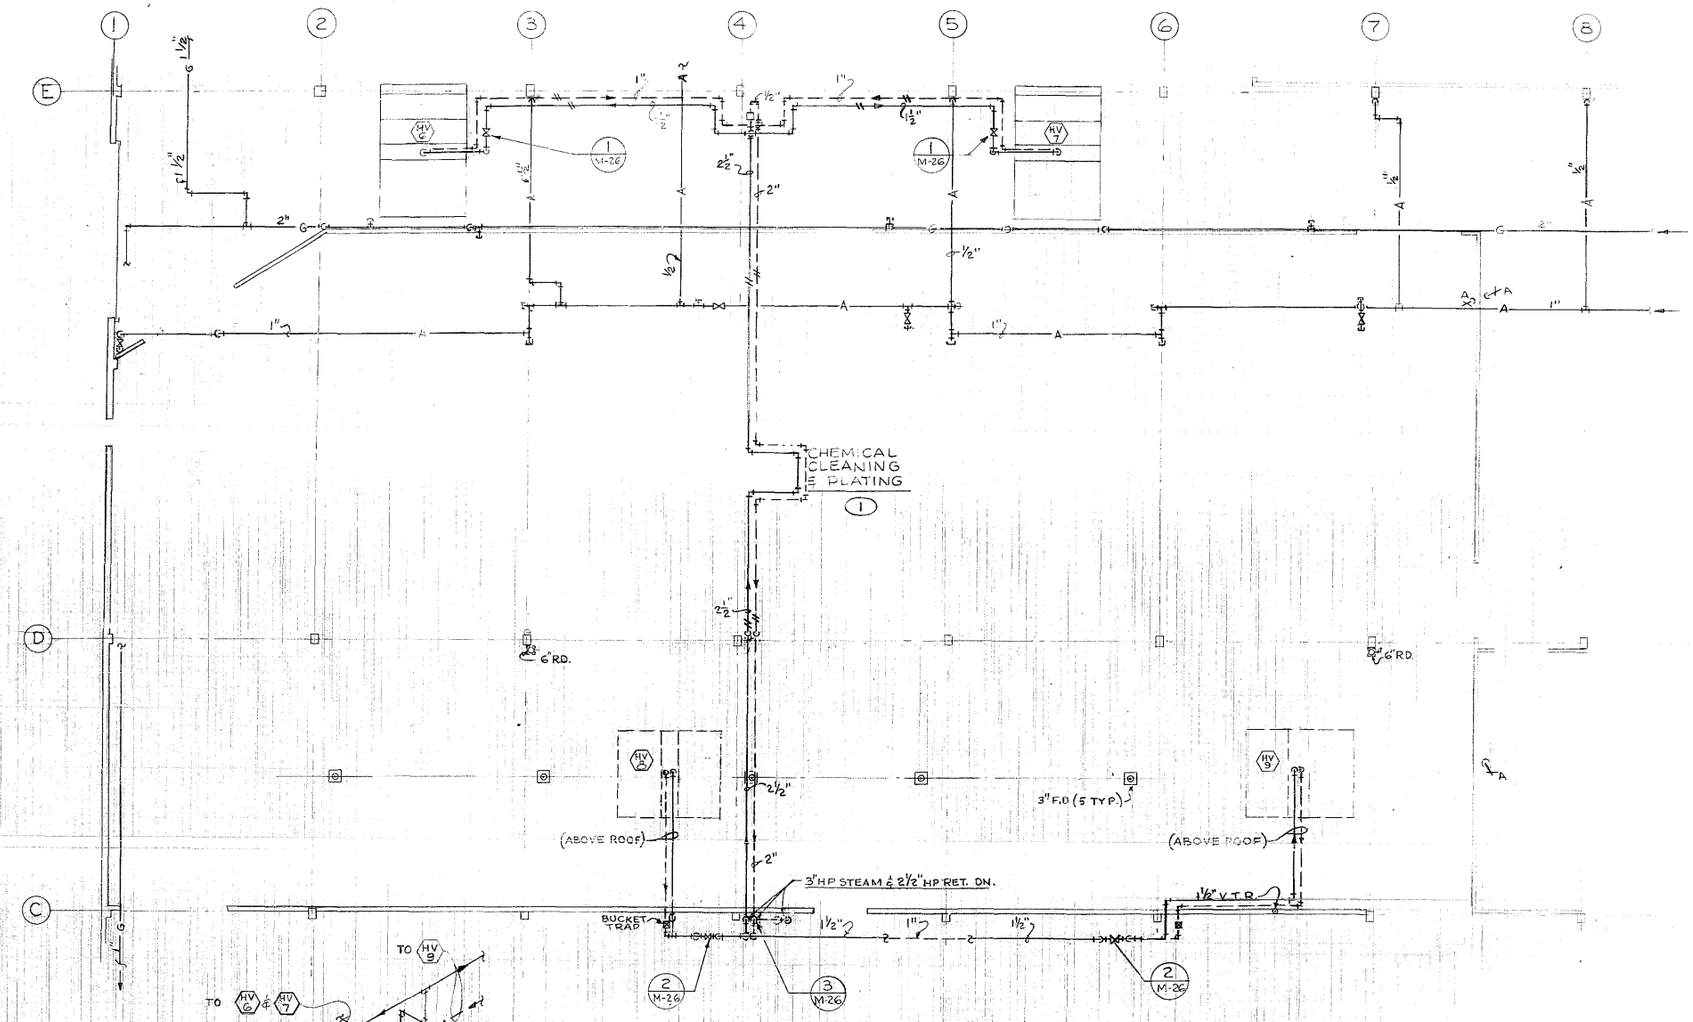

PARTIAL FIRST FLOOR PLAN
SCALE 1/8" = 1'-0"

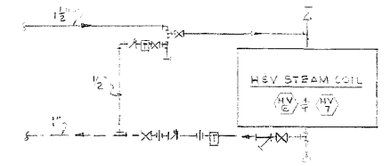

DIAGRAM 1 M-26
NOT TO SCALE
TYPICAL

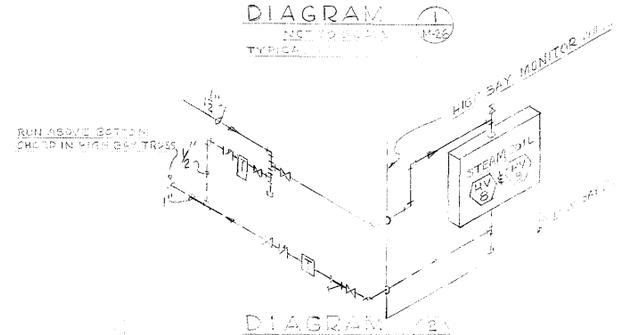

DIAGRAM 2 M-26
NOT TO SCALE
TYPICAL FOR 2 UNITS
PIPING FOR HSV-5 COIL SHOWN
PIPING FOR HSV-8 & 9 TO BE HAND

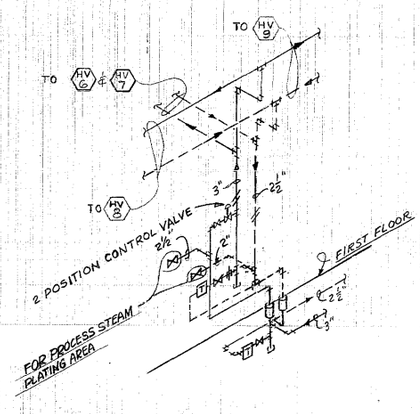

DIAGRAM 3 M-26
NOT TO SCALE

GRAPHIC SCALES

897185

24X -- DO NOT SCALE

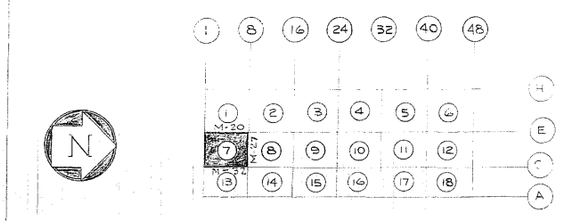

KEY PLAN BLDG. 12.02
FORMER NO. 1212-02-4157

SYM.	REVISION	BY	APPROVED	DATE
F	AS BUILT	EISI	RWP	3/15/68

SYM.	REVISION	BY	APPROVED	DATE
E	REMOVE UNIT HEATER	EISI	RWP	11/27/67
D	ISSUED FOR PHASE II	EISI	GHT	9/5/67
C	ISSUED FOR CONSTRUCTION	EISI	GHT	9/1/67
B	REVISION - ADDENDUM # 1	EISI	GHT	6/26/67
A	ISSUED FOR BID - CONTRACT ASD (FAC) 67-28	EISI	GHT	6/12/67

ENGINEERED INDUSTRIAL SYSTEMS INC
CONSULTING ENGINEERS
SEATTLE WASHINGTON

		DATE
DRAWN BY	EISI	6/1/67
CHECKED	GHT	6/9/67
CHECKED		
APPROVED		
APPROVED		
APPROVED		

SUB TITLE: FLOOR PLAN PIPING
TITLE: MECHANICAL MASTER
COL. C-E, 1-8 BLDG. 12.02
SHEET: M-26 OF
ISSUE
JOB NO. 1157
DWG. NO. 112-002-4157

WA0954KC

1384